IREDELL COUNTY HEALTH DEPARTMENT

STATESVILLE 704-878-5305 MOORESVILLE 704-664-5281

IMPROVEMENT PERMIT / AUTHORIZATION TO CONSTRUCT / OPERATION PERMIT / EXISTING SYSTEM INSPECTION

PERMIT# 123291 PIN# 4667670278.000 4664563529 DATE 4/20/05

OWNER OR CONTRACTOR RIDGELINE DEVELOPMENT PHONE: Business 365-5007 Home

ADDRESS 17105 READA DRIVE SUITE 207-C CORNELIUS NC 28031

LOCATION SHEARERS RD- SEPTIC ON LEFT PAST ANNESTON - CTR ANNESTON - TR LOGAN - TR ELIZABETH LOT ATGNO

SUBDIVISION ANNESTON BLOCK / SECTION 1 LOT 40 LOT AREA 1.8 AC SITE CLASS RS DESIGN FLOW 450GPD L.T.A.R. .25000/RS

Septic Tank: 1000 Gallons; STB T94 Date 6-13-06

Pump Tank: 1000 Gallons; PT 283 Date 11-21-06

Pump Make: Goulds Model WE1512HH Serial No.

Nitrification Field: No Fields 1 Square Feet 1440 Linear Feet 480

No Lines 6 Trench Width 36" Max Trench Bottom Depth 36" Gravel Depth N/A

☑ New System ☐ Repair System Type: I, II, III, IV, V, VI

System Description: PUMP 25% ROCK/SAND OFFSITE

Repair System Description: LP PANEL OFFSITE

Maintenance Agreement Required: ☐ Yes ☑ No

☑ House/Mod. Home ☐ Mobile Home ☐ Business ☐ Other

No. Bedrooms 4 No. Bathrooms 4 No. Employees


Water Supply: ☑ Individual ☐ Public ☐ Community

☐ Slab ☐ Crawl Space ☑ Basement w/plumbing ☐ Basement wo/plumbing


Comments:/Conditions: 30" DEEP OF GREATER UNDER DRIVE WITH SUPPLY LINE

Comments:/Conditions: ST W/ MARKER PT W/ RISER Red Poly lok filter

INITIAL SITE SKETCH

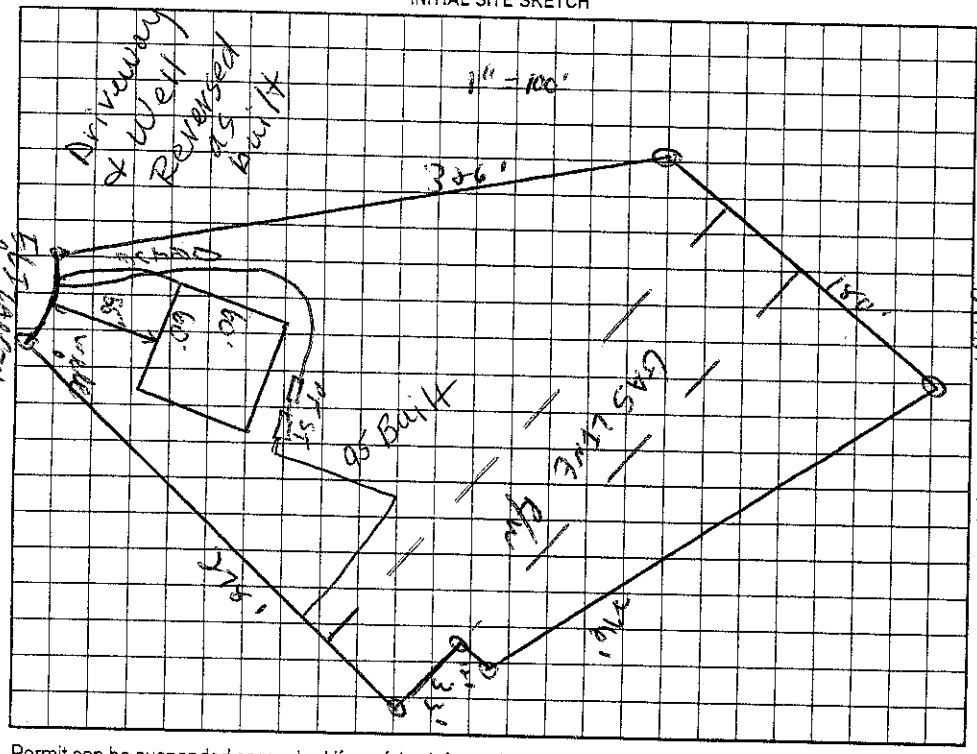

AS BUILT SKETCH

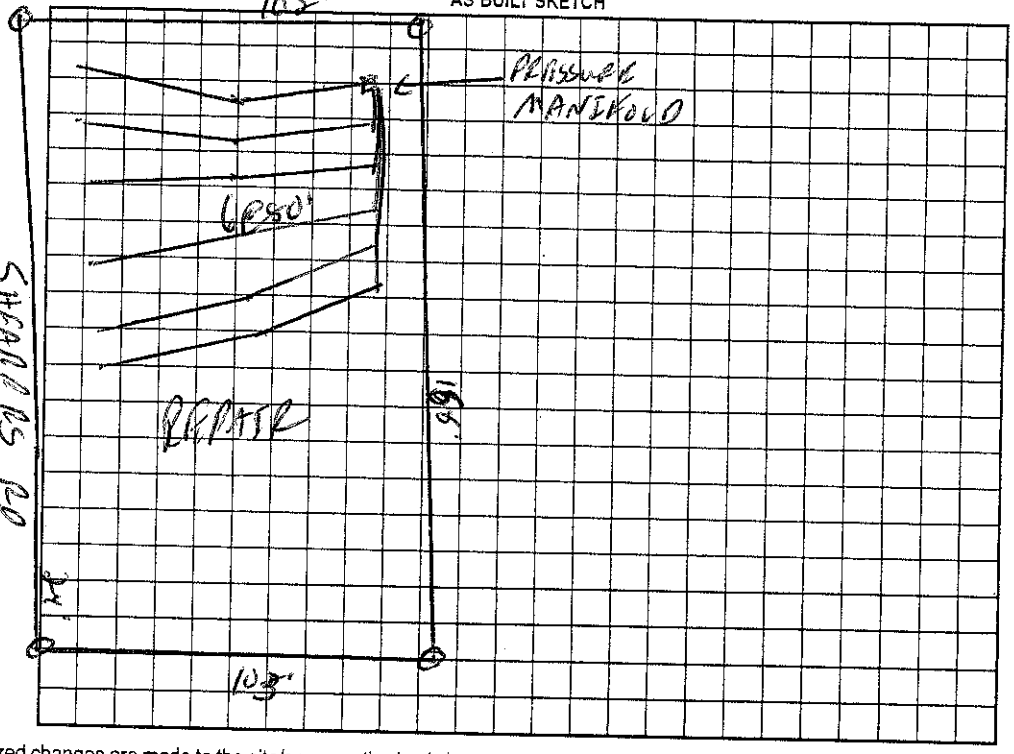

Permit can be suspended or revoked if any false information is supplied toward securing the permit/any unauthorized changes are made to the site/any unauthorized changes are made in the installation of the system. Improvement Permit with plat valid without expiration. Improvement Permit with site plan valid for sixty months. Authorization to Construct is valid for a period equal to that of Improvement Permit – not to exceed sixty months.

Signed: [signature] date 5-17-05 Installed by: Marty Tucker

Improvement Permit by: [signature] date 4/20/05 Operation Permit by: [signature] date 2-2-07

Authorization to Construct by: Marty Sparks RS date 2/9/06 Existing System Inspection by: date

HEALTH DEPT. COPY: WHITE OWNER COPY (FINAL): YELLOW OWNER COPY (INITIAL): PINK