IREDELL COUNTY HEALTH DEPARTMENT

STATESVILLE 704-878-5305 MOORESVILLE 704-664-5281

IMPROVEMENT PERMIT / AUTHORIZATION TO CONSTRUCT / OPERATION PERMIT / EXISTING SYSTEM INSPECTION

PERMIT# 123290 PIN# 4664-67-0275.039 4664565701 DATE 4/20/05

OWNER OR CONTRACTOR RIDGELINE DEVELOPMENT PHONE: Business 362-5007 Home

ADDRESS 17105 KRATON DR. SUITE 207-C CORNELIUS, NC 28031

LOCATION SHEARERS RD - SEPTIC ON LEFT PAST ANNISTON - (TL ANNISTON - TR LOGAN - TR ELIZABETH (LOT ON LT)

SUBDIVISION ANNISTON BLOCK / SECTION 1 LOT 304 LOT AREA .95AC SITE CLASS. CS DESIGN FLOW 480.00 L.T.A.R. ~.256-RO/KI=

Septic Tank: 1000 Gallons; STB 794 Date 9/6/06

Pump Tank: 1000 Gallons; PT 2483 Date 7/3/06

Pump Make: Gomes Model WEG-512HH Serial No.

Nitrification Field: No Fields 1 Square Feet 1530 Linear Feet 510

No Lines 6 @ 85' Trench Width 36" Max Trench Bottom Depth 28" Gravel Depth N/A

☑ New System ☐ Repair System Type: I, II, III, IV, V, VI

System Description: PUMP OFFSITE 50% REDUCTION

Repair System Description: SAME

Maintenance Agreement Required: ☐ Yes ☑ No

☐ House/Mod. Home No. Bedrooms 4

☐ Mobile Home No. Bathrooms 4

☐ Business No. Employees

☐ Other


☐ Slab ☑ Crawl Space ☑ Basement w/plumbing ☐ Basement wo/plumbing

Water Supply: ☐ Individual ☐ Public ☐ Community


Comments:/Conditions: SUPPLY LINE TO BE CLOSER THAN 50' TO WELL - ~~GOOD~~ SUPPLY LINE TO BE CONSTRUCTED OF SIMILAR LEAKPROOF PIPE WITH MECHANICAL JOINTS EQUIVALENT TO WATER MAIN STANDARDS.

Comments:/Conditions:

INITIAL SITE SKETCH

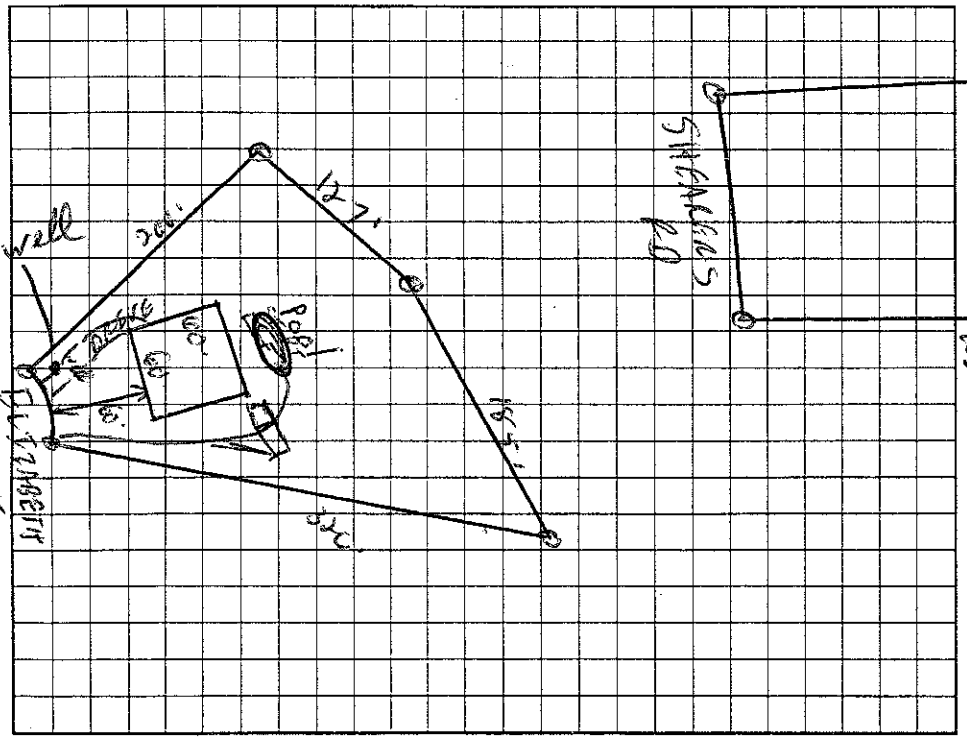

AS BUILT SKETCH

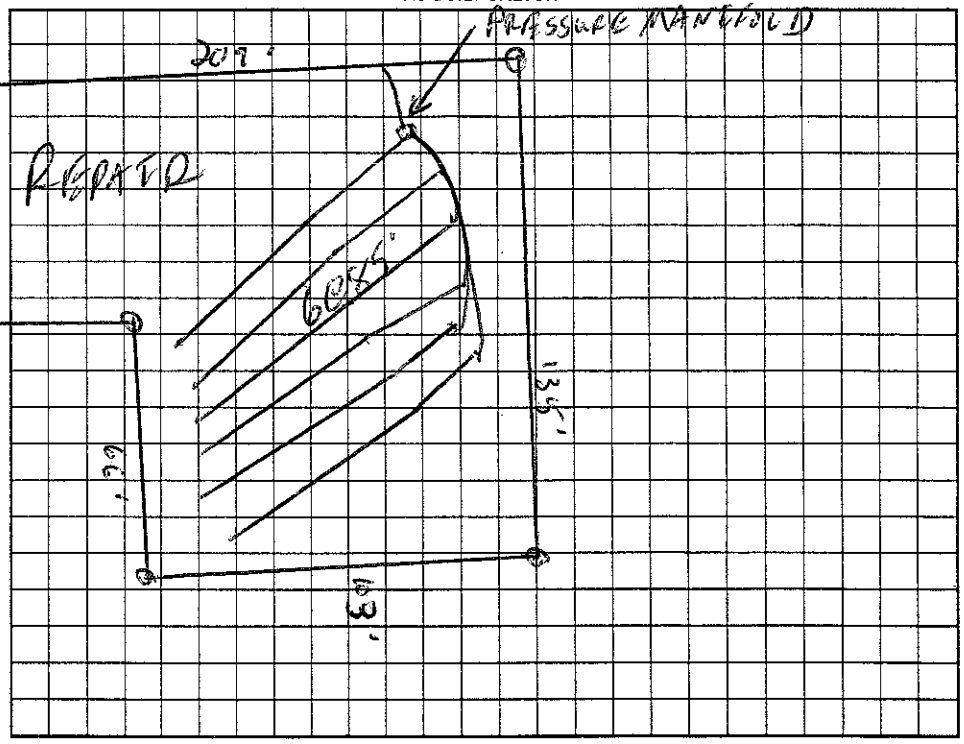

Permit can be suspended or revoked if any false information is supplied toward securing the permit/any unauthorized changes are made to the site/any unauthorized changes are made in the installation of the system. Improvement Permit with plat valid without expiration. Improvement Permit with site plan valid for sixty months. Authorization to Construct is valid for a period equal to that of Improvement Permit – not to exceed sixty months.

Signed: [signature] date 5-17-05 Installed by: Tucker

Improvement Permit by: [signature] date 4/20/05 Operation Permit by: Wesley Sparks RS. date 9/19/06

Authorization to Construct by: Wesley Sparks RS. date 11/23/05 Existing System Inspection by: date

HEALTH DEPT. COPY: WHITE OWNER COPY (FINAL): YELLOW OWNER COPY (INITIAL): PINK