IREDELL COUNTY HEALTH DEPARTMENT

STATESVILLE 704-878-5305 130.00 Paid 3:30 MOORESVILLE 704-664-5281

IMPROVEMENT PERMIT / AUTHORIZATION TO CONSTRUCT / OPERATION PERMIT / EXISTING SYSTEM INSPECTION

PERMIT# 130812 PIN# 4664 57 2559.030 4664-56-7204 DATE Sept 7, 2005

OWNER OR CONTRACTOR Anniston LLC PHONE: Business 704 362-5007 Home

ADDRESS 17624 Statesville Rd, Suite 112, Cornelius, N.C. 28031

LOCATION Weavers Rd (S) TL Anniston Way TR Logan Crossing Dr. on Right at end

SUBDIVISION Anniston BLOCK / SECTION 1 LOT 30/30A LOT AREA 2.264c + 2.45ac SFE SITE CLASS: PS SFE DESIGN FLOW 480 gpd L.T.A.R. @.25 SFE 30A

Septic Tank: 1000 Gallons; STB 319 Date 8-10-07

Pump Tank: 1000 Gallons; PT 283 Date 12-30-07

Pump Make: Goulds LP Model [redacted] Serial No.

Nitrification Field: No Fields 1 Square Feet 966 Linear Feet 322

No Lines 7@46' Trench Width 36" Max Trench Bottom Depth 30" Gravel Depth N/A

☒ New System ☐ Repair System Type: I, II, III_B, IV, V, VI

System Description: pm PPBPS

Repair System Description: LP PPBPS

Maintenance Agreement Required: ☐ Yes ☒ No initially

☒ House/Mod. Home No. Bedrooms 4

☐ Mobile Home No. Bathrooms

☐ Business No. Employees

☐ Other

☐ Slab ☒ Crawl Space ☐ Basement w/plumbing ☐ Basement wo/plumbing

Water Supply: ☒ Individual ☐ Public ☐ Community

Comments:/Conditions:

Initial site evaluation and system design performed by Rollans Soil and Environmental Services.

Comments:/Conditions:

3SE815 22J 1.5 hp

Pump Info. Goulds

INITIAL SITE SKETCH

SEE Plan by Ashley Rollans

AS BUILT SKETCH


Permit can be suspended or revoked if any false information is supplied toward securing the permit/any unauthorized changes are made to the site/any unauthorized changes are made in the installation of the system. Improvement Permit with plat valid without expiration. Improvement Permit with site plan valid for sixty months. Authorization to Construct is valid for a period equal to that of Improvement Permit – not to exceed sixty months.

Signed: Lori Tomaszewski date 9-22-05 Installed by: Stanley

Improvement Permit by: [signature] date 9-7-05 Operation Permit by: [signature] date 5-13-08

Authorization to Construct by: [signature] date 12/5/07 Existing System Inspection by: date

HEALTH DEPT. COPY: WHITE OWNER COPY (FINAL): YELLOW OWNER COPY (INITIAL): PINK

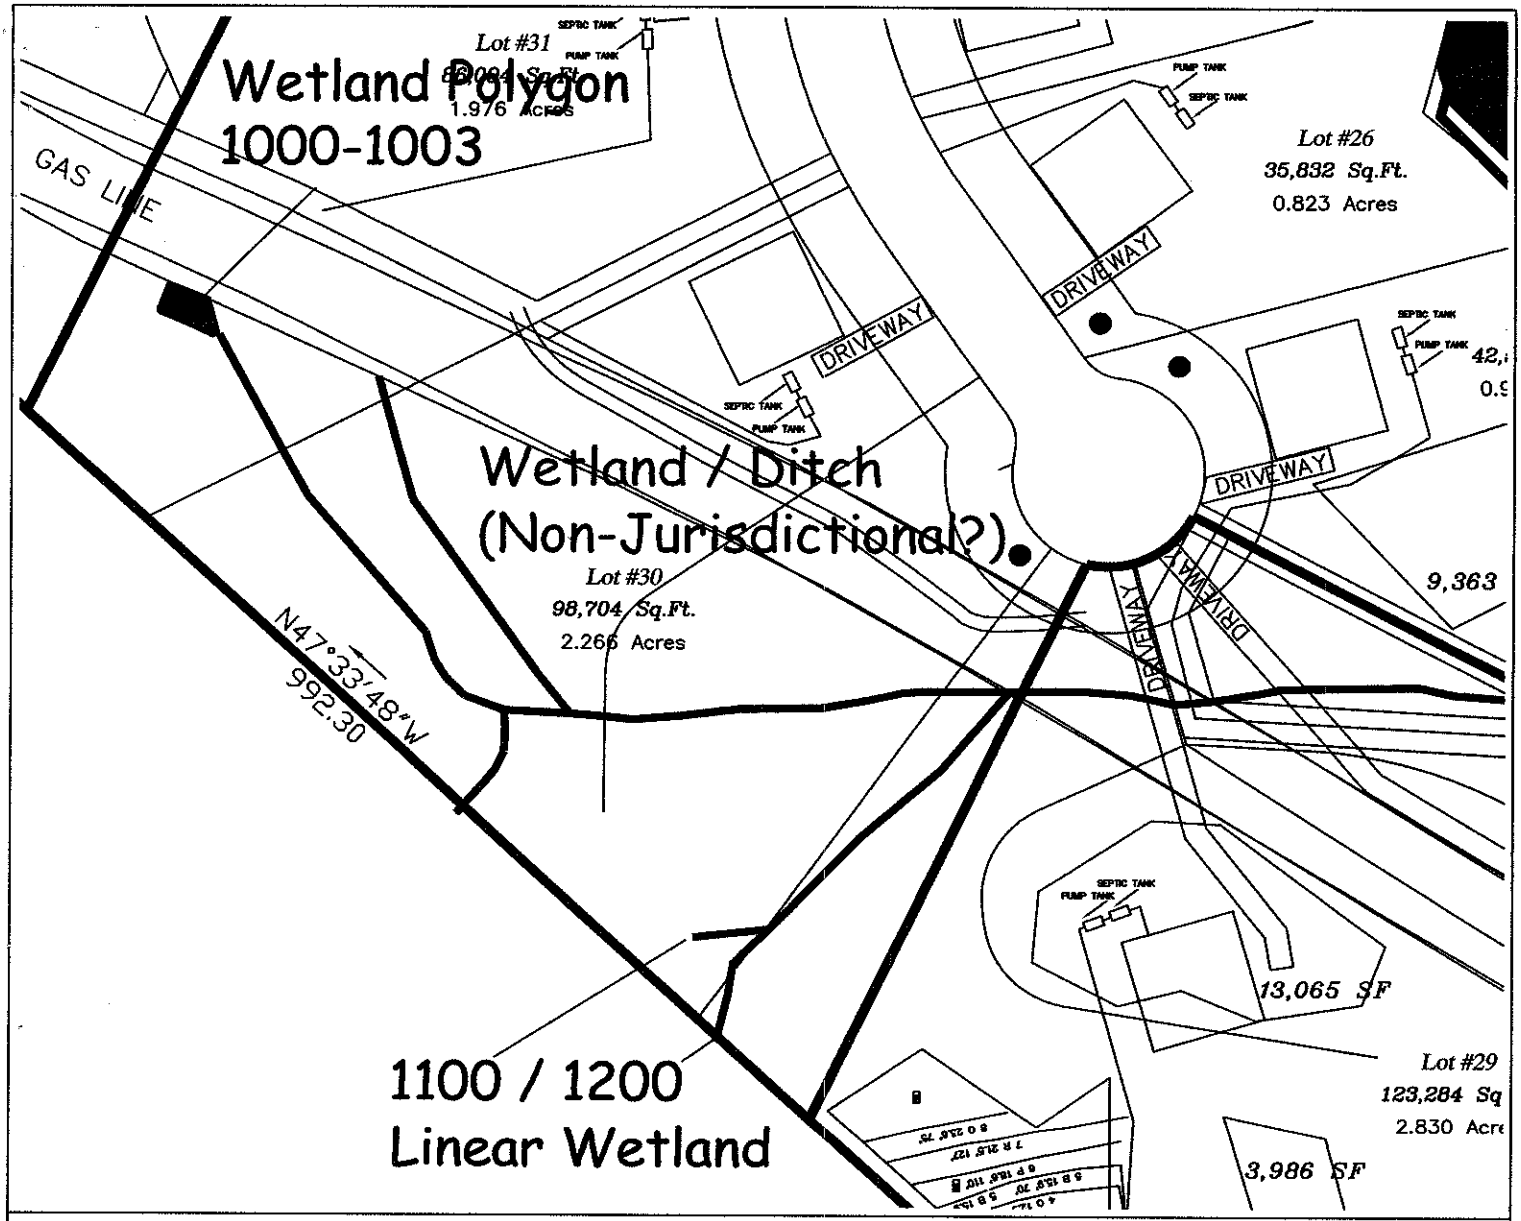

LEGEND

- Areas contain soils with 24 inches or more of useable material and have potential for conventional, modified conventional and low-pressure pipe (lpp) septic systems.
- Building Envelope (60' x 60')
- System lines.
- Repair lines.
- Temporary Bench Mark (TBM)
- Well Location.

GRAPHIC SCALE
1" = 100'

100 0 100 200

FOR PRELIMINARY PLANNING PURPOSES ONLY. ALL LOTS WILL REQUIRE FINAL APPROVAL BY THE COUNTY HEALTH DEPARTMENT ON A LOT BY LOT BASIS. THIS MAP SHOULD BY USED AS A GENERAL GUIDE, SOME ADJUSTMENTS WILL BE NECESSARY IN THE FIELD DUE TO SOIL VARIABILITY AND COMPLEX TOPOGRAPHIC FEATURES.
THIS MAP ONLY REFLECTS EXISTING SOIL SUITABILITY FOR ON-SITE SEPTIC TANK SYSTEMS.

PLEASE REFER TO ATTACHED SOIL REPORT FOR ADDITIONAL SITE SPECIFIC INFORMATION

ROLLANS SOIL & ENVIRONMENTAL SERVICES
2120 GRAHAM ROAD
MOUNT ULLA, NC 28125
PHONE/FAX: (704) 278 - 0989
ASHLEY ROLLANS, NC LICENSED SOIL SCIENTIST
MOBILE: (704) 746 - 5046
EMAIL: ROLLANSFORTCJ@AOL.COM

MAP TITLE: SITE PLAN & DRAINFIELD AREAS

PROJECT NAME: RIDGELINE DEVELOPMENT CORP. / ANNISTON PHASE II

LOCATION/DATE: SHEARER CHAPEL ROAD, IREDELL COUNTY, NORTH CAROLINA, AUGUST 2005

JOB # : 01-1005
FILE: C:\JOBS\01-1005
PROJECT MGR.: S.A.R.
FIELD WORK: S.A.R.
DRAWN BY: S.A.R.