IREDELL COUNTY HEALTH DEPARTMENT

STATESVILLE 704-878-5305 130.00 Paid MOORESVILLE 704-664-5281

IMPROVEMENT PERMIT / AUTHORIZATION TO CONSTRUCT / OPERATION PERMIT / EXISTING SYSTEM INSPECTION

PERMIT# 130782 PIN# 4664572559.023 4664-56-9896 DATE Sept 7, 05

OWNER OR CONTRACTOR Anniston LLC / EDWARDS CONST. PHONE: Business 704-362-5007 Home

ADDRESS 17824 Statesville Rd, Suite 112, Cornelius, N.C. 28031

LOCATION Square Rd. (S) TL Anniston Way TR Logan Crossing Dr. on left near end

SUBDIVISION Anniston BLOCK / SECTION 1 LOT 23/23A LOT AREA .967Ac+.435Ac SFE SITE CLASS. PS SFE DESIGN FLOW 440gpd L.T.A.R. .25 SFE 23A

Septic Tank: 1060 Gallons; STB 794 Date 2/21/06

Pump Tank: 1000 Gallons; PT 27 Date 8/26/07

Pump Make: Goulds Model WE-1512HN Serial No. 4-25-07

Nitrification Field: No Fields 1 Square Feet 1575 Linear Feet 525

No Lines 7@75' Trench Width 36" Max Trench Bottom Depth 36" Gravel Depth NA

☒ New System ☐ Repair System Type: I, II, III, IV, V, VI

System Description: pm 25% Reduction

Repair System Description: LP PPBPS

Maintenance Agreement Required: ☐ Yes ☒ No initially Aug 4/14/07

☒ House/Mod. Home ☐ Mobile Home ☐ Business No. Bedrooms 4 No. Bathrooms ___ No. Employees ___ Other

☐ Slab ☒ Crawl Space ☐ Basement w/plumbing ☐ Basement wo/plumbing

Water Supply: ☒ Individual ☐ Public ☐ Community

Comments:/Conditions:
Initial site evaluation and system design performed by Rollins Soil and Environmental Services

Comments:/Conditions: 111

INITIAL SITE SKETCH

SEE Plan by Ashley Rollins

AS BUILT SKETCH

11/21/07 lines Tanks checked

1/7/08 Electrical, Floats & Alarm checked

2/26/08 Pump Installed
pressure checked
System Installed as designed
2/26/08

The location of the proposed Pool addition does not appear to impact the existing septic system.
**NOTE: Pool must be min. 15' from Tanks

Cindy Blue Tuttle REHS
Date: 4-25-11
ICHD-Environmental Health Division

Permit can be suspended or revoked if any false information is supplied toward securing the permit/any unauthorized changes are made to the site/any unauthorized changes are made in the installation of the system. Improvement Permit with plat valid without expiration. Improvement Permit with site plan valid for sixty months. Authorization to Construct is valid for a period equal to that of Improvement Permit – not to exceed sixty months.

Signed: Lori Tomaselli date 9-27-05

Improvement Permit by: [signature] date 9-7-05


Authorization to Construct by: Wesley Sparks R.S. date 4/18/07

Installed by: Marty Tucker

Operation Permit by: Anthony Coberth date 2/26/08

Existing System Inspection by: ___ date ___

HEALTH DEPT. COPY: WHITE OWNER COPY (FINAL): YELLOW OWNER COPY (INITIAL): PINK

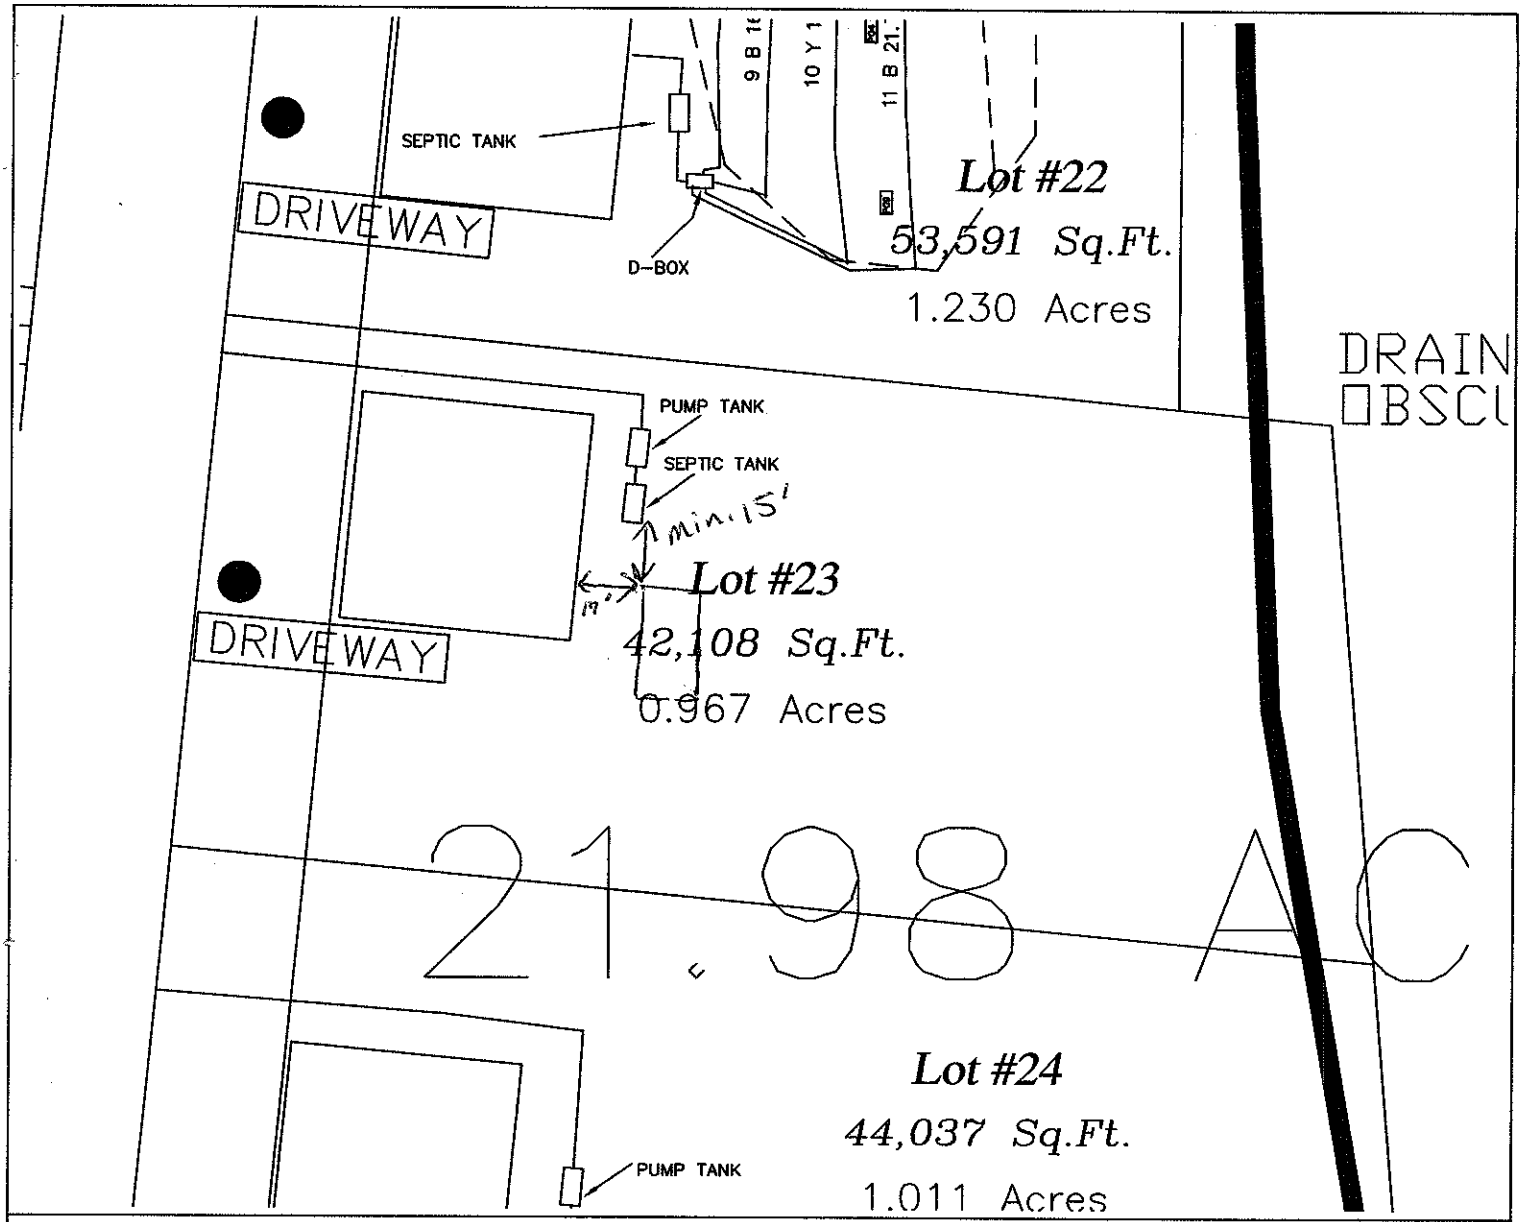

LEGEND

- Areas contain soils with 24 inches or more of useable material and have potential for conventional, modified conventional and low-pressure pipe (lpp) septic systems.
- Building Envelope (60' x 60')
- System lines.
- Repair lines.
- Temporary Bench Mark (TBM)
- Well Location.

GRAPHIC SCALE
1" = 50'

50 0 50 100

FOR PRELIMINARY PLANNING PURPOSES ONLY. ALL LOTS WILL REQUIRE FINAL APPROVAL BY THE COUNTY HEALTH DEPARTMENT ON A LOT BY LOT BASIS. THIS MAP SHOULD BY USED AS A GENERAL GUIDE, SOME ADJUSTMENTS WILL BE NECESSARY IN THE FIELD DUE TO SOIL VARIABILITY AND COMPLEX TOPOGRAPHIC FEATURES. THIS MAP ONLY REFLECTS EXISTING SOIL SUITABILITY FOR ON-SITE SEPTIC TANK SYSTEMS.

PLEASE REFER TO ATTACHED SOIL REPORT FOR ADDITIONAL SITE SPECIFIC INFORMATION

ROLLANS SOIL & ENVIRONMENTAL SERVICES
2120 GRAHAM ROAD
MOUNT ULLA, NC 28125
PHONE/FAX: (704) 278 - 0989
ASHLEY ROLLANS, NC LICENSED SOIL SCIENTIST
MOBILE: (704) 746 - 5086
EMAIL: ROLLANSFORTCJ@AOL.COM

MAP TITLE: SITE PLAN & DRAINFIELD AREAS

PROJECT NAME: RIDGELINE DEVELOPMENT CORP. / ANNISTON PHASE 6

LOCATION/DATE: SHEARER CHAPEL ROAD, IREDELL COUNTY, NORTH CAROLINA, AUGUST 2005

JOB # : 01-1005
FILE: C:\JOBS\01-1005
PROJECT MGR.: S.A.R.
FIELD WORK: S.A.R.
DRAWN BY: S.A.R.