IREDELL COUNTY HEALTH DEPARTMENT

STATESVILLE 704-878-5305 MOORESVILLE 704-664-5281

IMPROVEMENT PERMIT / AUTHORIZATION TO CONSTRUCT / OPERATION PERMIT / EXISTING SYSTEM INSPECTION

PERMIT # 163791 PIN # 4664-57-1886 DATE 12-21-10

OWNER or APPLICANT JASON RAMSEY PHONE: Business 704-458-0208 Home:

OWNER or APPLICANT ADDRESS 127 LOGAN CROSSING DAVIDSON NC

LOCATION / DIRECTIONS SHEARERS, TURN INTO ANNISTON, FIRST R, ON L

SUBDIVISION ANNISTON BLOCK / SECTION LOT # 14 LOT AREA .76 AC DESIGN FLOW 480 GPD L.T.A.R. .25/R.1

Septic Tank EX. 1000 Gallons: STB Date

Pump Tank EX. 1000 Gallons: P T Date

Pump Make GOULDS Model WE1512HH Serial #

Nitrification Field No Fields No Lines Linear Feet EXISTING

Trench Width Max. Trench Bottom Depth Gravel Depth

☐ New System ☐ Repair ☐ Expansion System Type I II III (IV) V VI

System Description: EX. LP- PANEL BLOCK

Repair System Description: LPP

Maintenance Agreement Required ☒ YES ☐ NO

GRAVITY ☒ PRESSURE

☒ Residence No. Bedrooms 4

☐ Business No. Persons

☒ Other No. Employees

☐ Slab ☒ Crawl Space

☒ Basement w/plumbing ☐ Basement w/o plumbing


Water Supply: ☒ Private ☐ Public ☐ Community

Comments / Conditions (1) POOL CAN MOVE CLOSER TO HOUSE PER ZONING REQUIREMENTS (2) POOL MUST BE MIN 15' FROM REPAIR AREA


Comments / Conditions

POOL

INITIAL SITE SKETCH

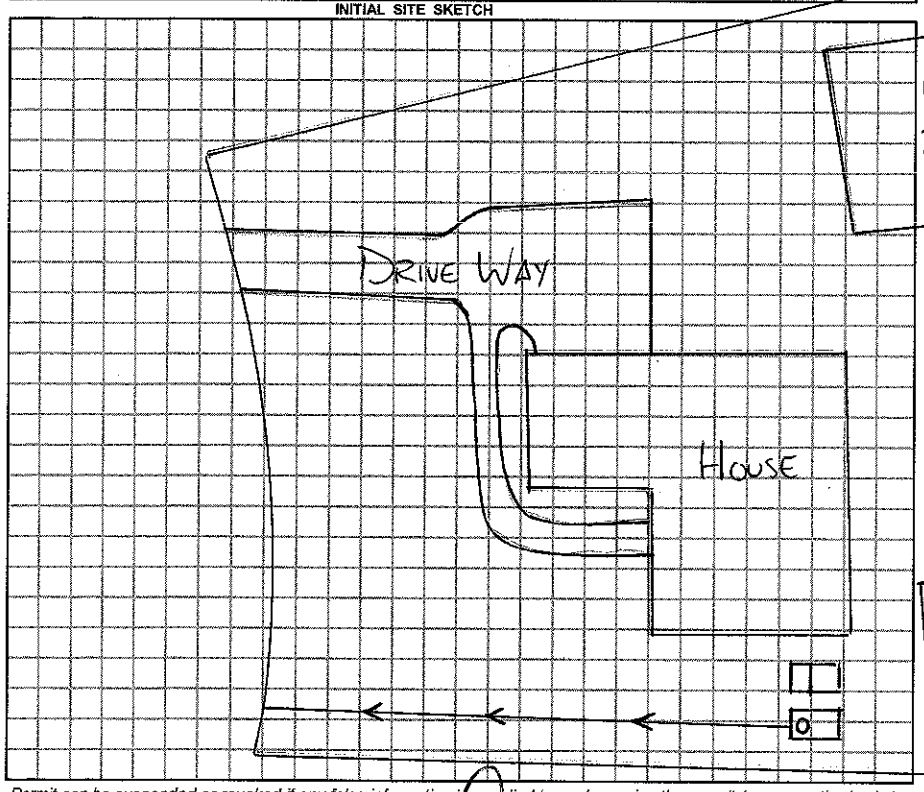

AS BUILT SKETCH

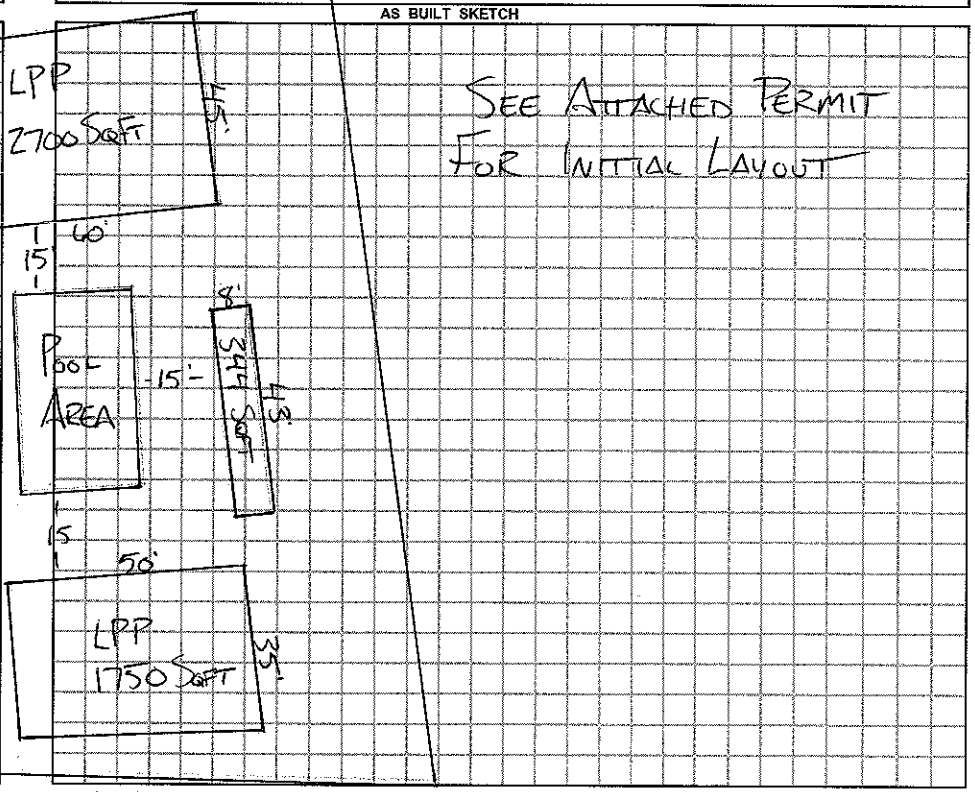

SEE ATTACHED PERMIT FOR INITIAL LAYOUT

Permit can be suspended or revoked if any false information is supplied toward securing the permit / any unauthorized changes are made to the site / any unauthorized changes are made in the installation of the system.

☐ *IMPROVEMENT PERMIT w / plat valid without expiration.* ☐ *IMPROVEMENT PERMIT w / site plan valid for 60 mos.* ☐ *AUTHORIZATION TO CONSTRUCT valid for period equal to IMPROVEMENT PERMIT-not to exceed 60 mo.*

Owner / Applicant Signature: Date 1-19-11

Improvement Permit by: Date

Authorization to Construct by: Date

YOU SHOULD CONTACT A LOCATOR SERVICE PRIOR TO ANY EXCAVATION.

Installed by:

Operation Permit by: Date:

Existing System Inspected by: REHS Date: 12-21-10

WHITE COPY Environmental Health YELLOW COPY (Final) Owner / Applicant PINK COPY (Initial) Owner / Applicant