IREDELL COUNTY HEALTH DEPARTMENT

STATESVILLE 704-878-5305 MOORESVILLE 704-664-5281

IMPROVEMENT PERMIT / AUTHORIZATION TO CONSTRUCT / OPERATION PERMIT / EXISTING SYSTEM INSPECTION

PERMIT# 123297 PIN# 4664-67-0278.043 4664-57-2004 DATE 4/21/05

OWNER OR CONTRACTOR REDLINE DEV. PHONE: Business 362-5007 Home

ADDRESS 17105 KEATON DR. SUITE 207-C CORNELIUS NC 28031

LOCATION SHEARERS (S) - TL ANNISTON - TR LOGAN - TR ELIZABETH - LOT ON RT

SUBDIVISION ANNISTON BLOCK / SECTION 1 LOT 43 LOT AREA .64c SITE CLASS. PS DESIGN FLOW 360 GPD L.T.A.R. .256 AC/FT

Septic Tank: 1000 Gallons; STB 794 Date 3-13-07

Pump Tank: 1000 Gallons; PT 283 Date 3-26-07

Pump Make: Goulds Model WEOS11HH Serial No.

Nitrification Field: No Fields 1 Square Feet 480 Linear Feet 240

No Lines 4 Con' Trench Width 24" Max Trench Bottom Depth 30" Gravel Depth N/A

☑ New System ☐ Repair System Type: I, II, III, (IV), V, VI

System Description: LP PANEL OFFSITE

Repair System Description: SAME ONSITE

Maintenance Agreement Required: ☑ Yes ☐ No

☑ House/Mod. Home No. Bedrooms 3

☐ Mobile Home No. Bathrooms 3

☐ Business No. Employees

☐ Other

☐ Slab ☑ Crawl Space ☐ Basement w/plumbing ☐ Basement wo/plumbing


Water Supply: ☑ Individual ☐ Public ☐ Community

Comments:/Conditions:


36"

Comments:/Conditions:

1"=50' INITIAL SITE SKETCH

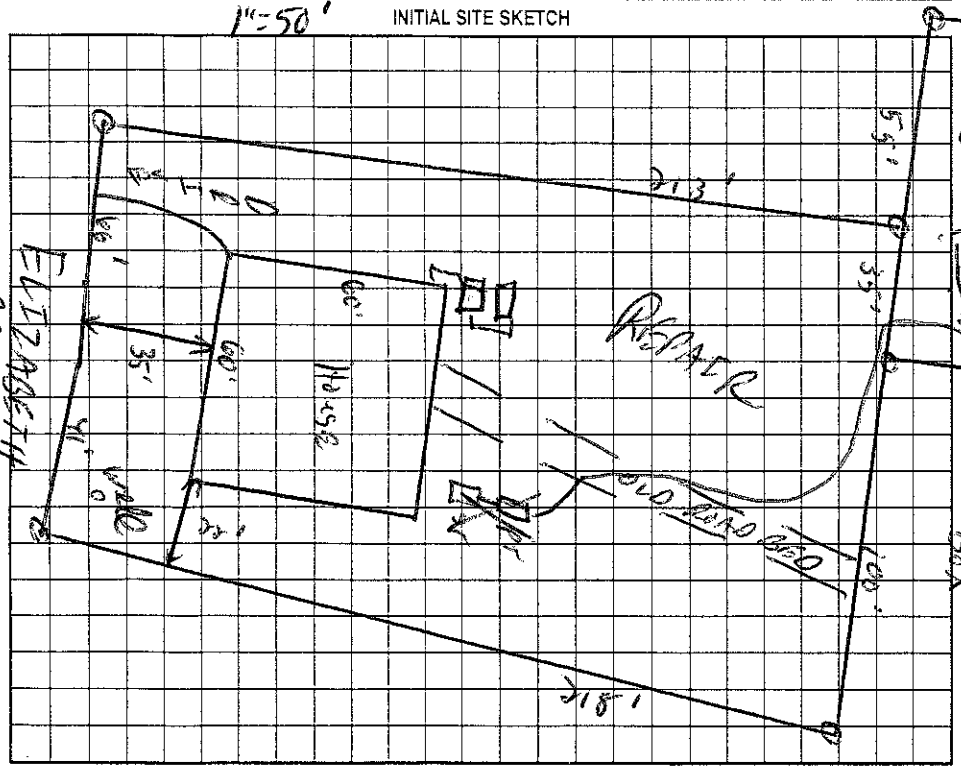

AS BUILT SKETCH

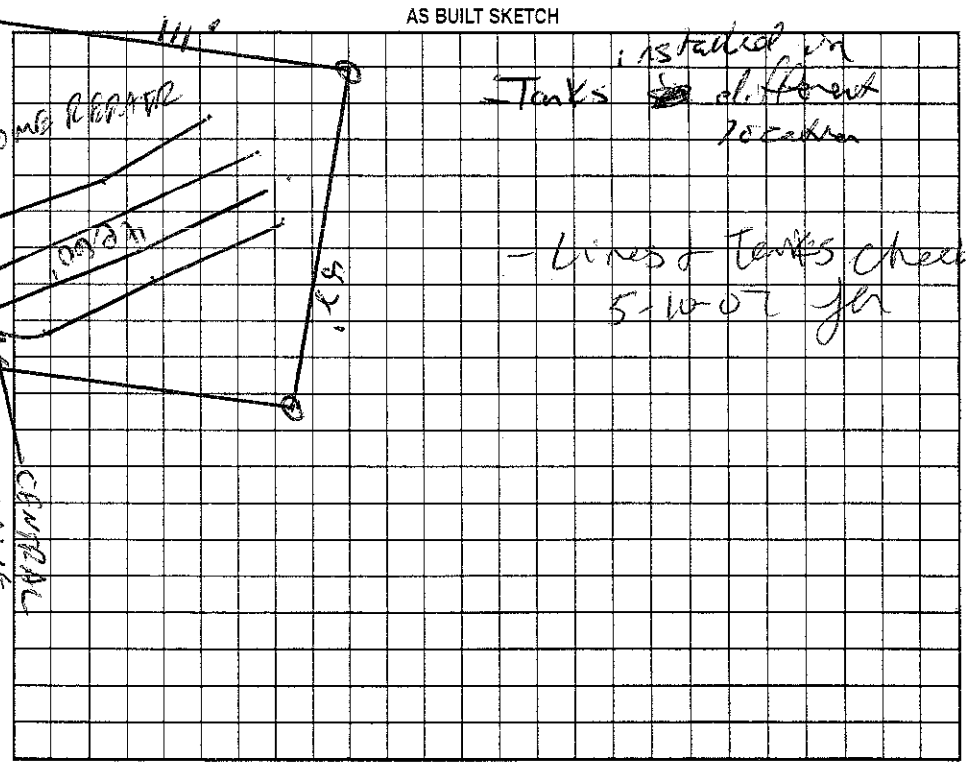

Permit can be suspended or revoked if any false information is supplied toward securing the permit/any unauthorized changes are made to the site/any unauthorized changes are made in the installation of the system. Improvement Permit with plat valid without expiration. Improvement Permit with site plan valid for sixty months. Authorization to Construct is valid for a period equal to that of Improvement Permit – not to exceed sixty months.

Signed: [signature] date 5-17-05 Installed by: Marty Tucker

Improvement Permit by: C. S. Peters RS date 4/21/05 Operation Permit by: [signature] date 7/27/07

Authorization to Construct by: Wesley Peters RS date 2/9/06 Existing System Inspection by: date

HEALTH DEPT. COPY: WHITE OWNER COPY (FINAL): YELLOW OWNER COPY (INITIAL): PINK