IREDELL COUNTY HEALTH DEPARTMENT

STATESVILLE 704-878-5305 MOORESVILLE 704-664-5281

IMPROVEMENT PERMIT / AUTHORIZATION TO CONSTRUCT / OPERATION PERMIT / EXISTING SYSTEM INSPECTION

PERMIT# 123295 PIN# 4664-67-0278.044 4664-57-2109 DATE 4/21/05

OWNER OR CONTRACTOR RIDGELINE DEV. / EDWARDS CONST. CO PHONE: Business 362-5007 Home

ADDRESS 17105 KEATON DRIVE Suite 207-C CORNELIUS NC 28031

LOCATION SHEARER RD - TL ANNISTON - TR LOUIN - TR ELIZABETH - 2nd RT

SUBDIVISION ANNISTON BLOCK / SECTION 1 LOT 44 LOT AREA .73Ac SITE CLASS. PS DESIGN FLOW 480GPD L.T.A.R. .250PD/672

Septic Tank: 1000 Gallons; STB 794 Date 7/16/05

Pump Tank: 1250 Gallons; PT 27 Date 1/8/06

Pump Make: GOULDS Model WE3-311M Serial No. 2

Nitrification Field: No Fields 1 Square Feet 640 Linear Feet 320

No Lines 4@80' Trench Width 24" Max Trench Bottom Depth 36" Gravel Depth N/A

☑ New System ☐ Repair System Type: I, II, III, IV, V, VI

System Description: LP PANEL

Repair System Description: SAME

Maintenance Agreement Required: ☑ Yes ☐ No

☐ House/Mod. Home No. Bedrooms 4

☐ Mobile Home No. Bathrooms 4

☐ Business No. Employees

☐ Other


☐ Slab ☑ Crawl Space ☐ Basement w/plumbing ☐ Basement wo/plumbing

Water Supply: ☑ Individual ☐ Public ☐ Community

Comments:/Conditions: DO NOT CUT HOUSE PAD

Comments:/Conditions:

INITIAL SITE SKETCH 1" = 50'

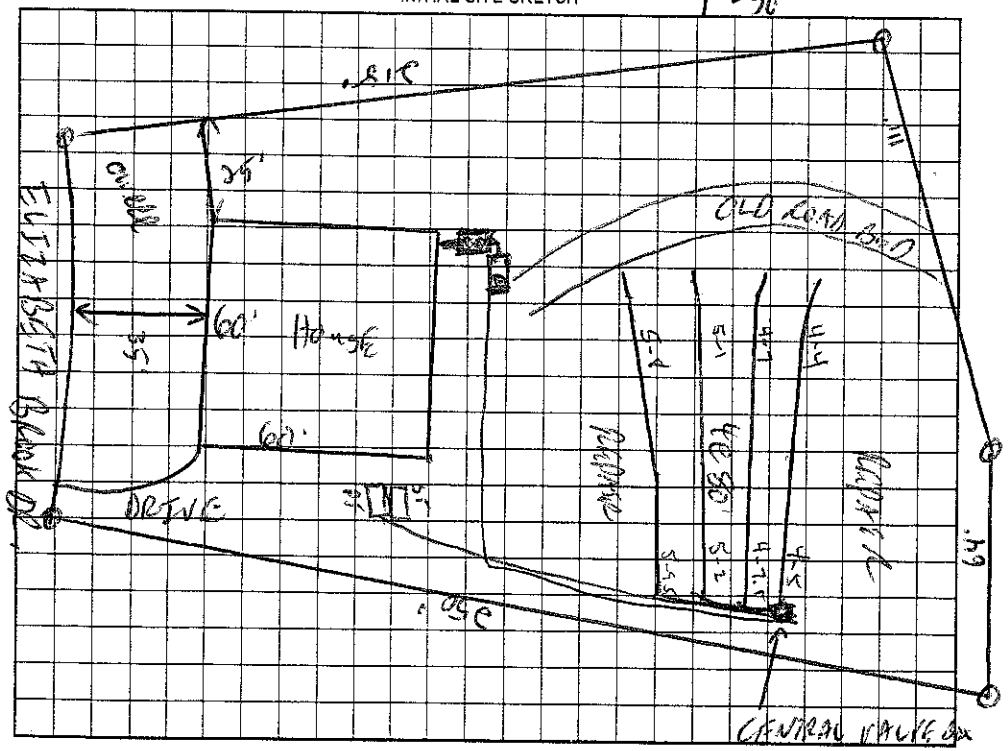

AS BUILT SKETCH

Permit can be suspended or revoked if any false information is supplied toward securing the permit/any unauthorized changes are made to the site/any unauthorized changes are made in the installation of the system. Improvement Permit with plat valid without expiration. Improvement Permit with site plan valid for sixty months. Authorization to Construct is valid for a period equal to that of Improvement Permit – not to exceed sixty months.

Signed: [signature] date 5-17-05

Improvement Permit by: [signature] RS date 4/21/05

Authorization to Construct by: Wesley Sparks RS. date 6/16/05

Installed by: Martin Franken

Operation Permit by: Wesley Sparks RS date 3/24/06

Existing System Inspection by: date

HEALTH DEPT. COPY: WHITE OWNER COPY (FINAL): YELLOW OWNER COPY (INITIAL): PINK