IREDELL COUNTY HEALTH DEPARTMENT

STATESVILLE 704-878-5305 MOORESVILLE 704-664-5281

IMPROVEMENT PERMIT / AUTHORIZATION TO CONSTRUCT / OPERATION PERMIT / EXISTING SYSTEM INSPECTION

PERMIT# 123253 PIN# 4664670275.016 4664573683 DATE 4/20/05

OWNER OR CONTRACTOR REDGELINE DEVELOPMENT/EDWARDS CONSTRUCTION PHONE: Business 362-5007 Home

ADDRESS ~~2170 GRAHAM RD~~ 17105 KEATON RIDGE DR. SUITE 207-C DAVIDSON NC 28031

LOCATION STEARNS - TL ANNESTON WAY - SEPTIC ON LEFT - TR LOGAN - LOT ON LEFT

SUBDIVISION ANNESTON BLOCK / SECTION 1 LOT 16 LOT AREA .854c SITE CLASS. PS DESIGN FLOW 450GPD L.T.A.R. .25 0.50/1.12

Septic Tank: 1000 Gallons; STB 794 Date 2-25-07

Pump Tank: 1000 Gallons; PT 83 Date 3-16-07

Pump Make: Model Serial No.

Nitrification Field: No Fields 1 Square Feet 660 Linear Feet 330

No Lines 3@110' Trench Width 24" Max Trench Bottom Depth (30") Gravel Depth #57

☑ New System ☐ Repair System Type: I, II, III, (IV), V, VI

System Description: LPP PANEL

Repair System Description: SAME

Maintenance Agreement Required: ☑ Yes ☐ No

☑ House/Mod. Home No. Bedrooms 4

☐ Mobile Home No. Bathrooms 4

☐ Business No. Employees

☐ Other


☐ Slab ☐ Crawl Space ☑ Basement w/plumbing ☐ Basement wo/plumbing

Water Supply: ☑ Individual ☐ Public ☐ Community


Comments:/Conditions:

Comments:/Conditions:

INITIAL SITE SKETCH

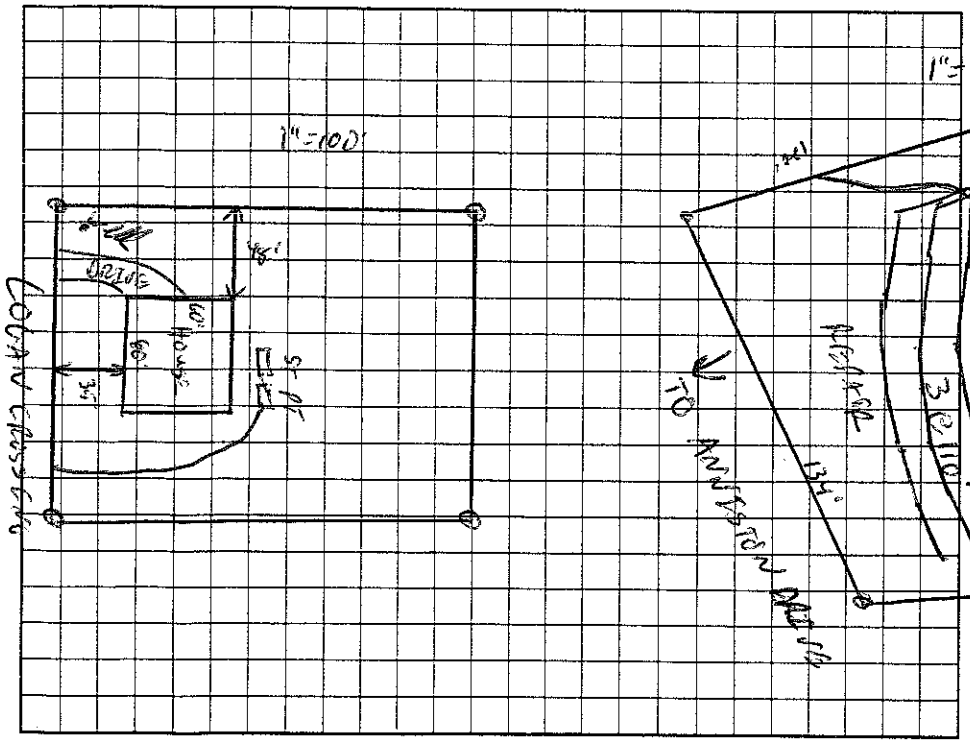

AS BUILT SKETCH

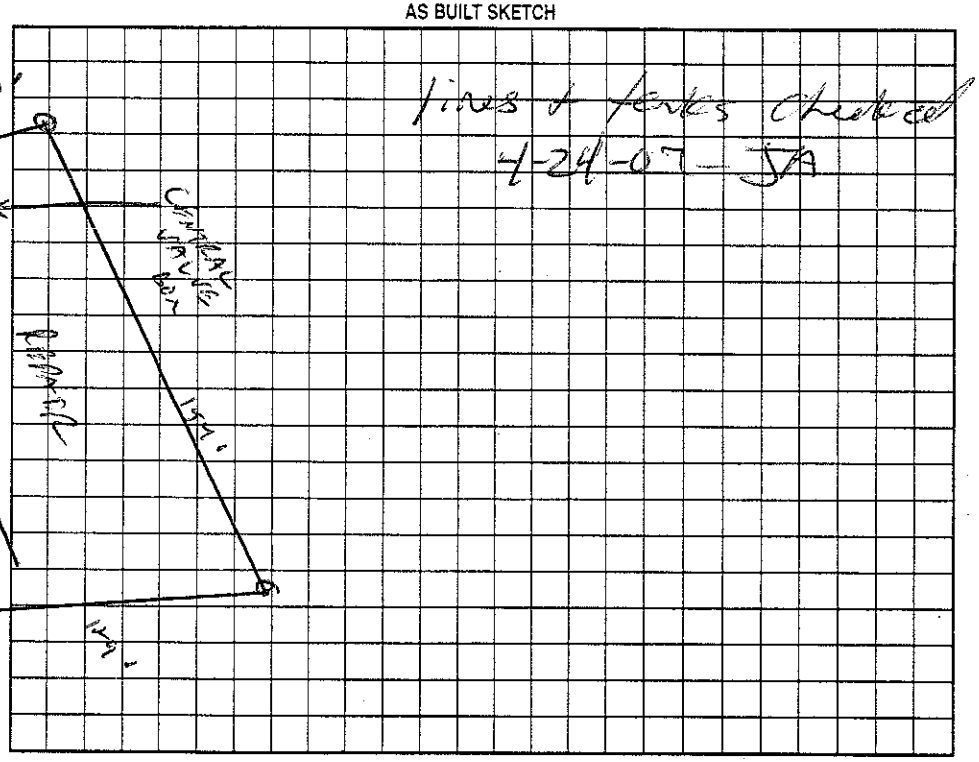

Permit can be suspended or revoked if any false information is supplied toward securing the permit/any unauthorized changes are made to the site/any unauthorized changes are made in the installation of the system. Improvement Permit with plat valid without expiration. Improvement Permit with site plan valid for sixty months. Authorization to Construct is valid for a period equal to that of Improvement Permit – not to exceed sixty months.

Signed: [signature] date 5-17-05 Installed by: Marty Tucker

Improvement Permit by: [signature] RS date 4/20/05 Operation Permit by: date

Authorization to Construct by: [signature] date 1/26/06 Existing System Inspection by: date

HEALTH DEPT. COPY: WHITE OWNER COPY (FINAL): YELLOW OWNER COPY (INITIAL): PINK