IREDELL COUNTY HEALTH DEPARTMENT

~~STATE~~SVILLE 704-878-5305 MOORESVILLE 704-664-5281

IMPROVEMENT PERMIT / AUTHORIZATION TO CONSTRUCT / OPERATION PERMIT / EXISTING SYSTEM INSPECTION

PERMIT# 123282 PIN# 4664670378.015 / 4664-57-3704 DATE 5/5/05

OWNER OR CONTRACTOR Ridgeline Development / Wynsor PHONE (Business) 362-2207 Home

ADDRESS 17105 Keaton Dr. Suite 207-C Cornelius NC 28031

LOCATION Shearers Rd (S) - TL Anniston Way - TR Logan Crossing - Lot on LT - Septic on RT

SUBDIVISION Anniston BLOCK / SECTION 1 LOT 15-15A LOT AREA .77AC SITE CLASS. PS DESIGN FLOW 480GPD L.T.A.R. ~.25 GPD/ft2

Septic Tank: 1000 Gallons; STB 794 Date 9-10-07
Pump Tank: 1000 Gallons; PT 283 Date 2-20-08
Pump Make: Myers Model ME150-21 Serial No.
Nitrification Field: No Fields 1 Square Feet 730 Linear Feet 365
No Lines 4 Trench Width 24" Max Trench Bottom Depth 30" Gravel Depth N/A

☑ New System ☐ Repair System Type: I, II, III, IV, V, VI (IV circled)
System Description: LP Panel (Offsite)
Repair System Description: LPP (Same)
Maintenance Agreement Required: ☑ Yes ☐ No

☑ House/Mod. Home No. Bedrooms 4
☐ Mobile Home No. Bathrooms 4
☐ Business No. Employees
☐ Other


☐ Slab ☐ Crawl Space ☑ Basement w/plumbing ☐ Basement wo/plumbing

Water Supply: ☑ Individual ☐ Public ☐ Community


Comments:/Conditions: 3/16" hole drilled
4/25/08 Checked 2" supply line from PT to Rd

Comments:/Conditions: 4/24/08 Checked lines & tanks

INITIAL SITE SKETCH

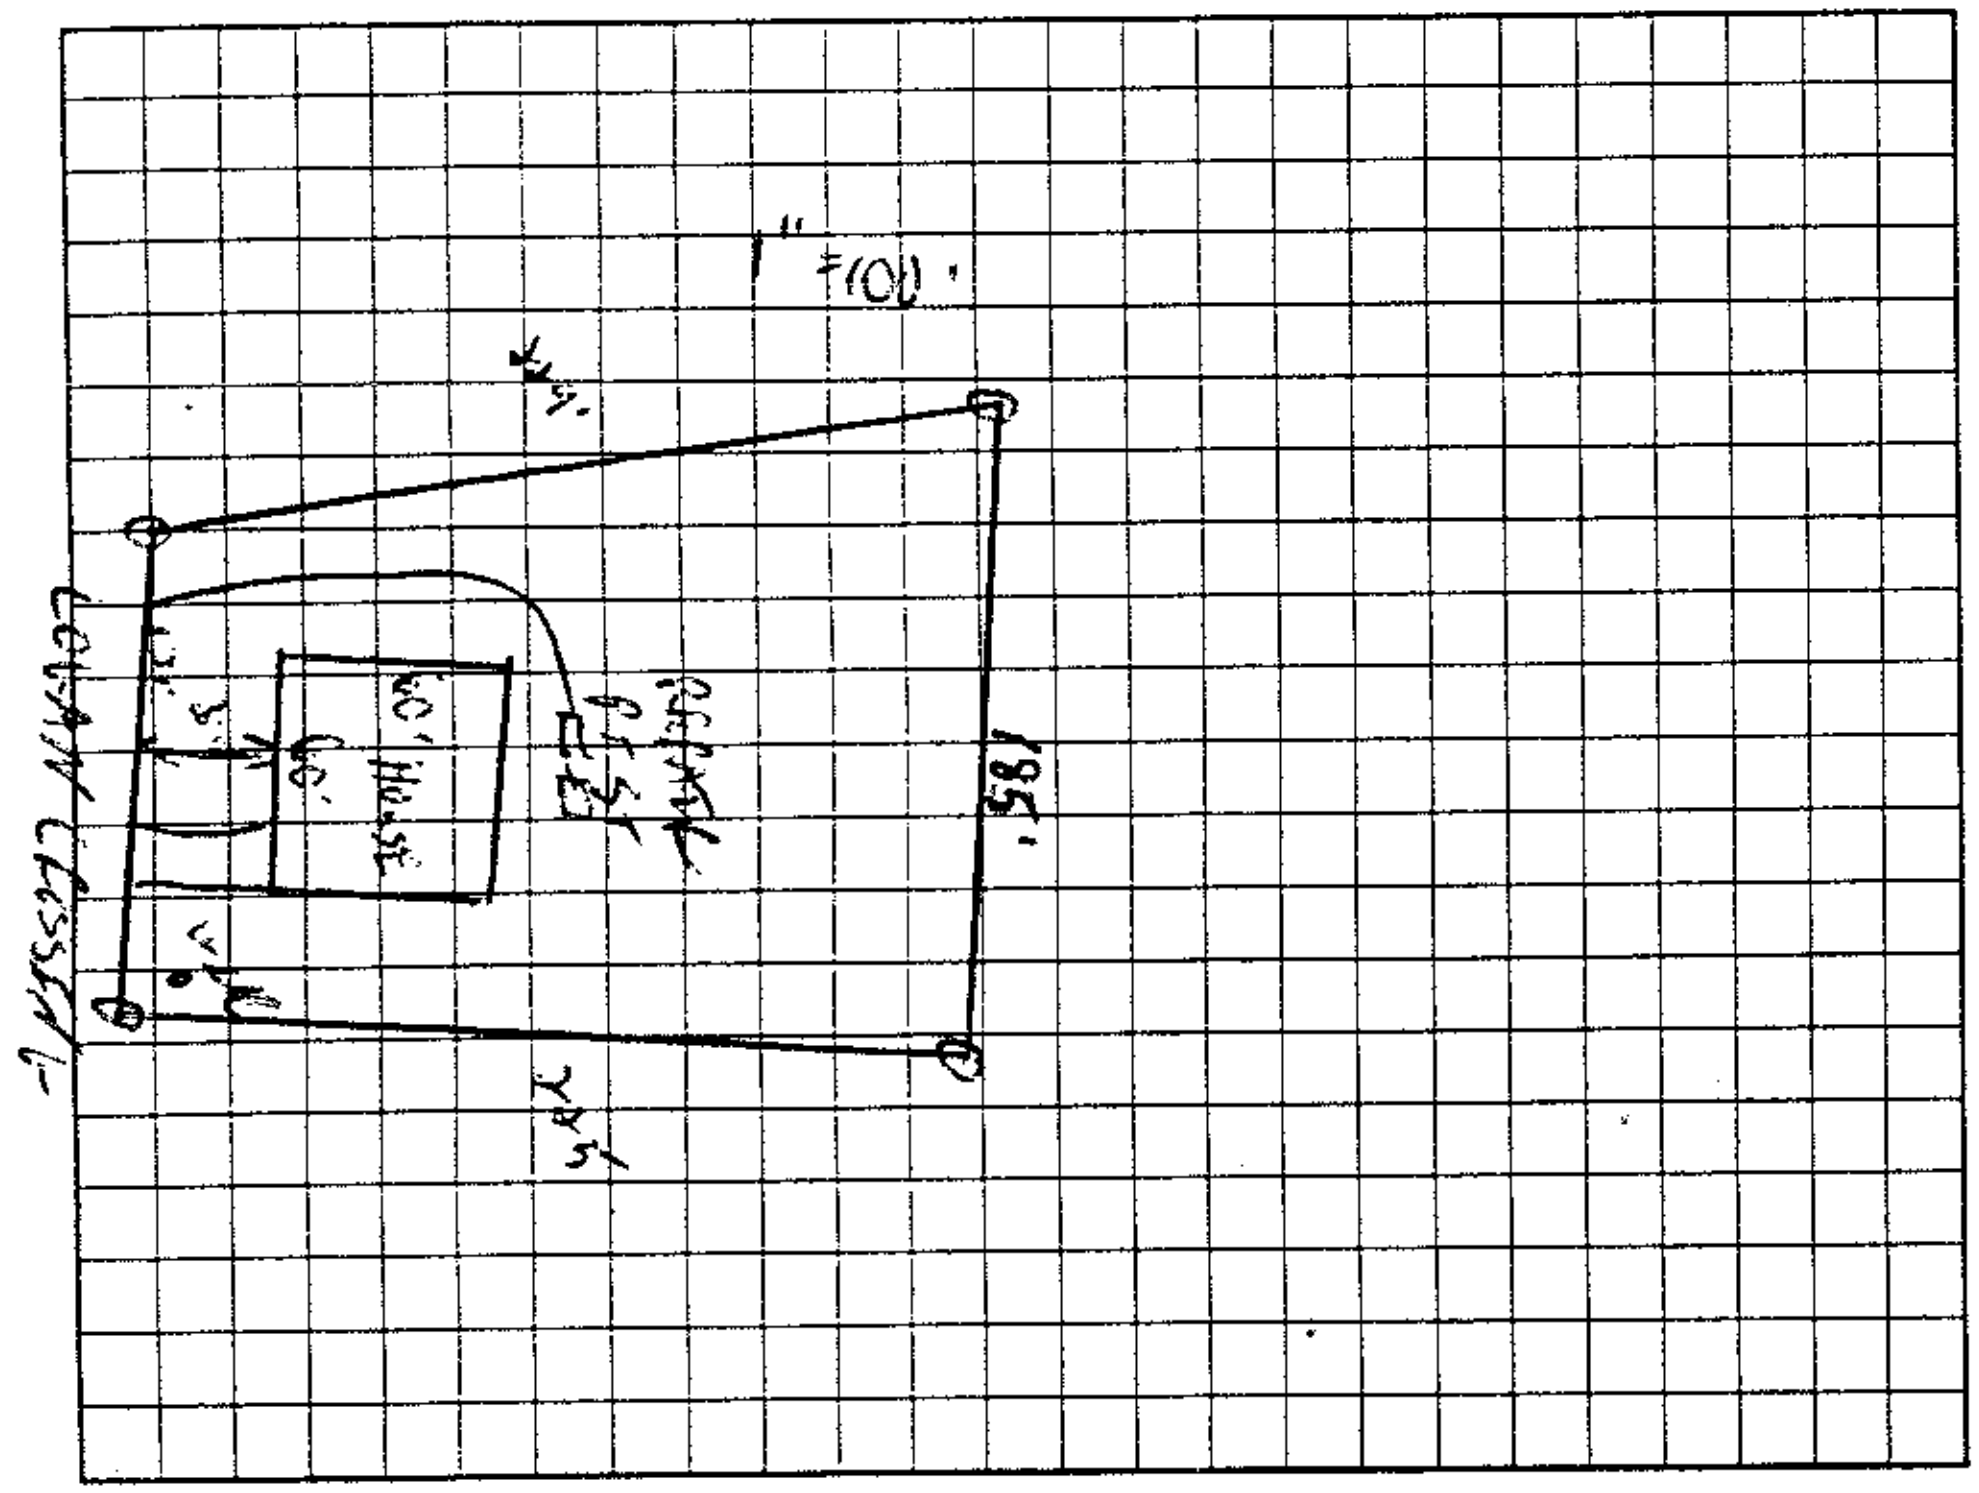

AS BUILT SKETCH

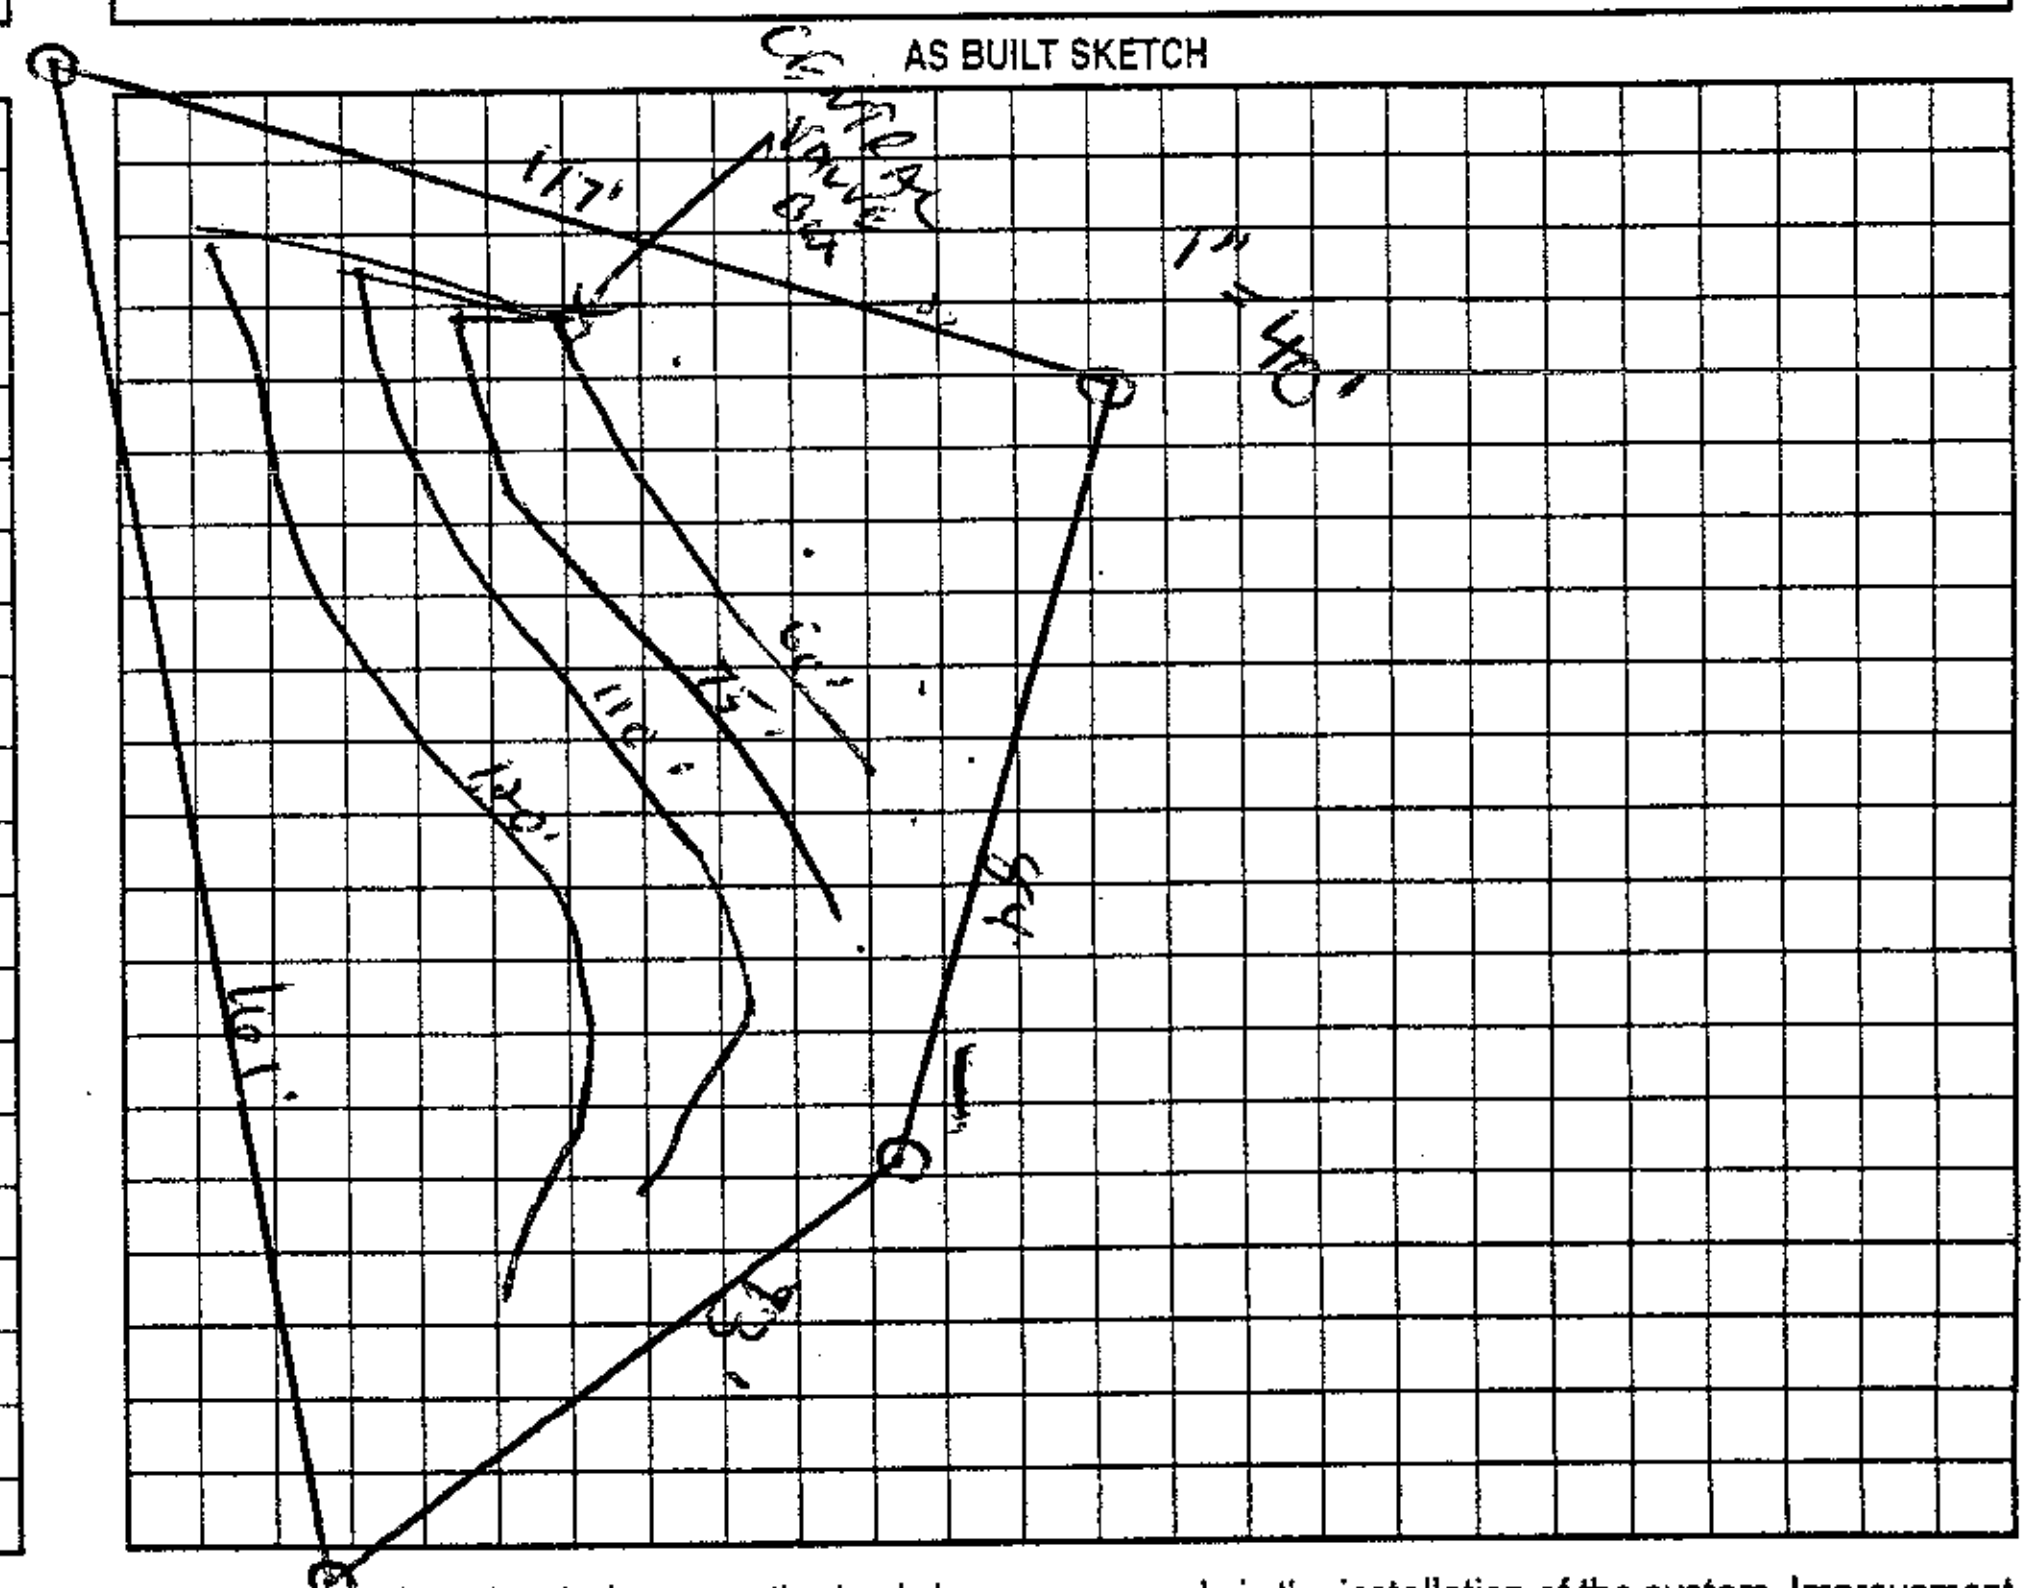

Permit can be suspended or revoked if any false information is supplied toward securing the permit/any unauthorized changes are made to the site/any unauthorized changes are made in the installation of the system. Improvement Permit with plat valid without expiration. Improvement Permit with site plan valid for sixty months. Authorization to Construct is valid for a period equal to that of Improvement Permit – not to exceed sixty months.

Signed: Lori Tomaszewski date 5-17-05
Installed by: Stanley Septic
Improvement Permit by: [signature] RS date 5/5/05
Operation Permit by: [signature] date 6-9-08
Authorization to Construct by: Wesley Sparks RS date 12/5/07
Existing System Inspection by: date

HEALTH DEPT. COPY: WHITE OWNER COPY (FINAL): YELLOW OWNER COPY (INITIAL): PINK