IREDELL COUNTY HEALTH DEPARTMENT

STATESVILLE 704-878-5305 MOORESVILLE 704-664-5281

IMPROVEMENT PERMIT / AUTHORIZATION TO CONSTRUCT / OPERATION PERMIT / EXISTING SYSTEM INSPECTION

PERMIT# 123284 PIN# 4664-67-0278.017 4664574564 DATE 4/20/05

OWNER OR CONTRACTOR Ridgeline Development / Edwards Const. PHONE: Business 362-5007 Home

ADDRESS 17105 Keation Plaza Suite 207-C Cornelius NC 28031

LOCATION Sheagers Rd - TL Anniston - Septic on left - TR Logan Xing - Lot on LT

SUBDIVISION Anniston BLOCK / SECTION 1 LOT 17 LOT AREA .77AC SITE CLASS. PS DESIGN FLOW 480 GPD L.T.A.R. .256 GPD/FT

Septic Tank: 1000 Gallons; STB 794 Date 6-12-06
Pump Tank: 1000 Gallons; PT 27 Date 10-8-06
Pump Make: Model Serial No.
Nitrification Field: No Fields 1 Square Feet 1000 Linear Feet 400
No Lines 4@100' Trench Width 36" Max Trench Bottom Depth 36" Gravel Depth

☑ New System ☐ Repair System Type: I, II, III, IV, V, VI
System Description: Pump 25% Reduction Offsite
Repair System Description: Change Offsite
Maintenance Agreement Required: ☐ Yes ☑ No

☑ House/Mod. Home No. Bedrooms 4
☐ Mobile Home No. Bathrooms 4
☐ Business No. Employees
☐ Other


☐ Slab ☐ Crawl Space ☑ Basement w/plumbing ☐ Basement wo/plumbing

Water Supply: ☑ Individual ☐ Public ☐ Community


Comments:/Conditions:

Comments:/Conditions:

INITIAL SITE SKETCH

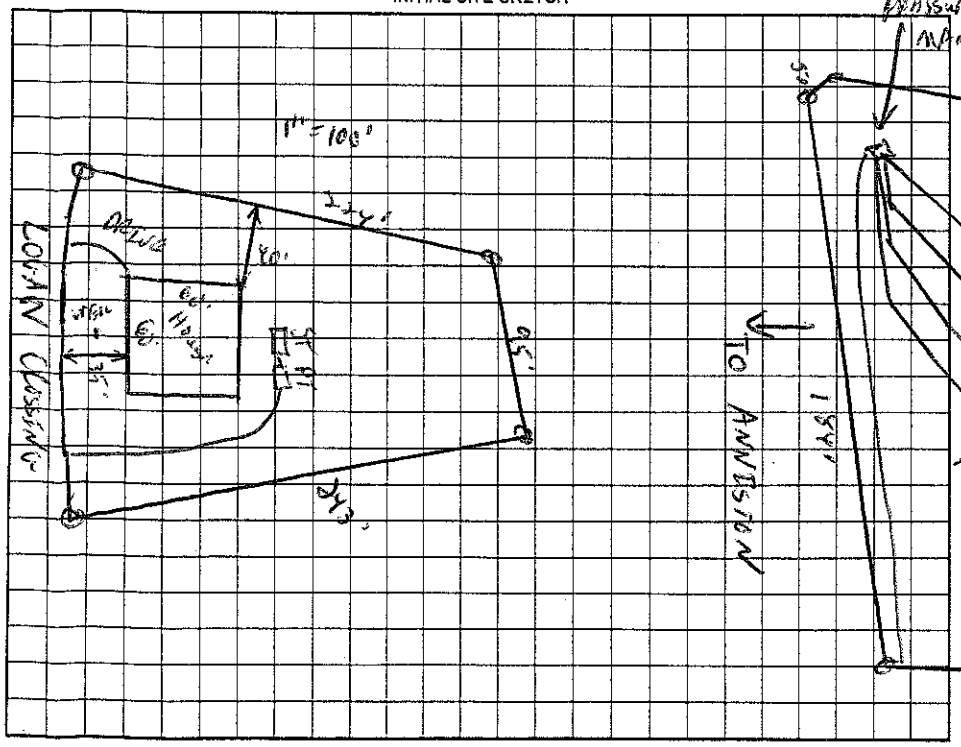

1" = 60' AS BUILT SKETCH

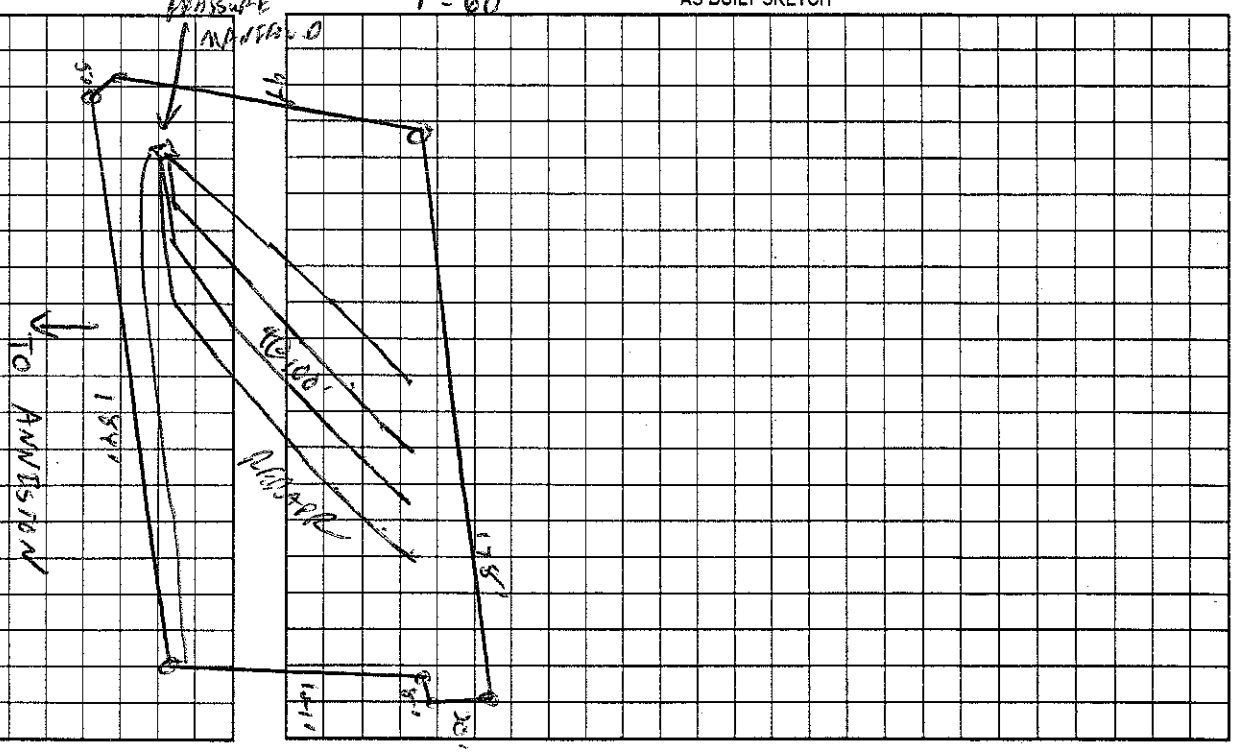

Permit can be suspended or revoked if any false information is supplied toward securing the permit/any unauthorized changes are made to the site/any unauthorized changes are made in the installation of the system. Improvement Permit with plat valid without expiration. Improvement Permit with site plan valid for sixty months. Authorization to Construct is valid for a period equal to that of Improvement Permit – not to exceed sixty months.

Signed: Mark Tomaszewski date 5-17-05 Installed by: Tucker's Grading

Improvement Permit by: C. [illegible] RS date 4/20/05 Operation Permit by: John E. Allen date 12-28-06

Authorization to Construct by: Judy Melville date 4-21-06 Existing System Inspection by: date

HEALTH DEPT. COPY: WHITE OWNER COPY (FINAL): YELLOW OWNER COPY (INITIAL): PINK