IREDELL COUNTY HEALTH DEPARTMENT

STATESVILLE 704-878-5305 MOORESVILLE 704-664-5281

IMPROVEMENT PERMIT / AUTHORIZATION TO CONSTRUCT / OPERATION PERMIT / EXISTING SYSTEM INSPECTION

PERMIT# 17325 PIN# ~~4664-07-0398-000~~ 4664575779.000 DATE 5/5/05

OWNER OR CONTRACTOR REDEVINE DEVELOPMENT / Edwards Const. PHONE: Business 362-5007 Home

ADDRESS 17105 KRATON DR. SUITE 207-C CORNELIUS NC 28031

LOCATION SHEARINS (S) - TL ANNISTON - SEPTIC ON LEFT - LOT ON RT

SUBDIVISION ANNISTON BLOCK / SECTION 1 LOT 6 LOT AREA .72AC SITE CLASS. AS DESIGN FLOW 480GPD L.T.A.R. .30 /FT2

Septic Tank: 1000 Gallons; STB Date

Pump Tank: 1000 Gallons; PT Date

Pump Make: Model Serial No.

Nitrification Field: No Fields 1 Square Feet 1200 Linear Feet 400

No Lines 3@33 Trench Width ~~24~~ 36" Max Trench Bottom Depth 36" Gravel Depth

☑ New System ☐ Repair System Type: I, II, III, IV, V, VI

System Description: PUMP OFFSITE 35% REDUCTION

Repair System Description: LP PANEL OFFSITE

Maintenance Agreement Required: ☐ Yes ☑ No

☑ House/Mod. Home No. Bedrooms 4

☐ Mobile Home No. Bathrooms 4

☐ Business No. Employees

☐ Other


☐ Slab ☐ Crawl Space ☑ Basement w/plumbing ☐ Basement wo/plumbing

Water Supply: ☑ Individual ☐ Public ☐ Community


Comments:/Conditions:

Comments:/Conditions:

INITIAL SITE SKETCH

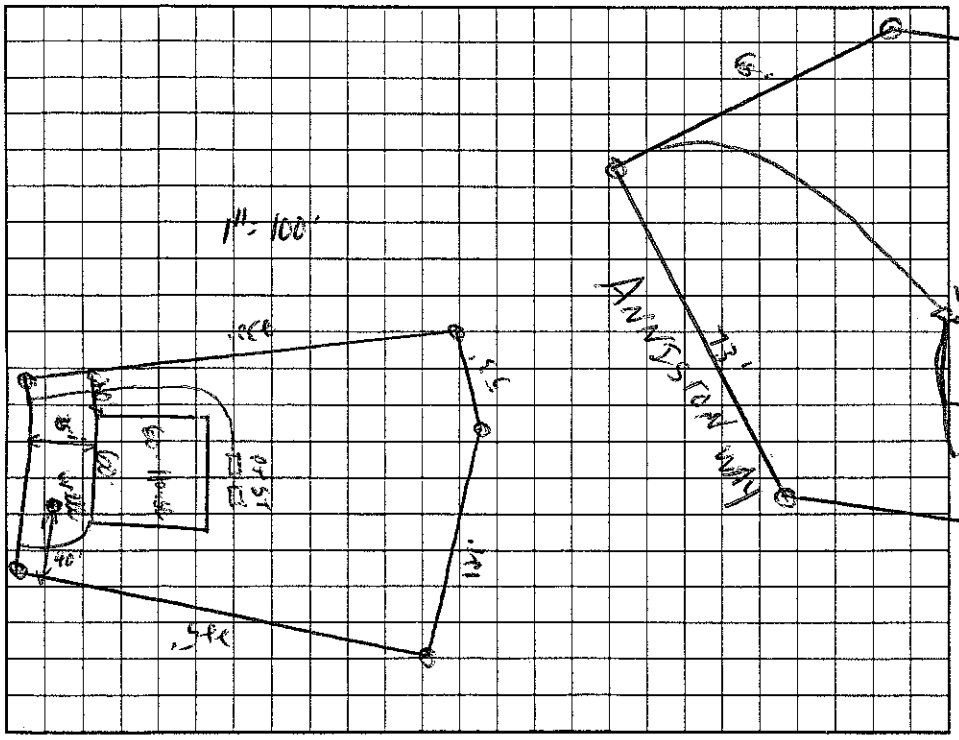

1" = 40' AS BUILT SKETCH

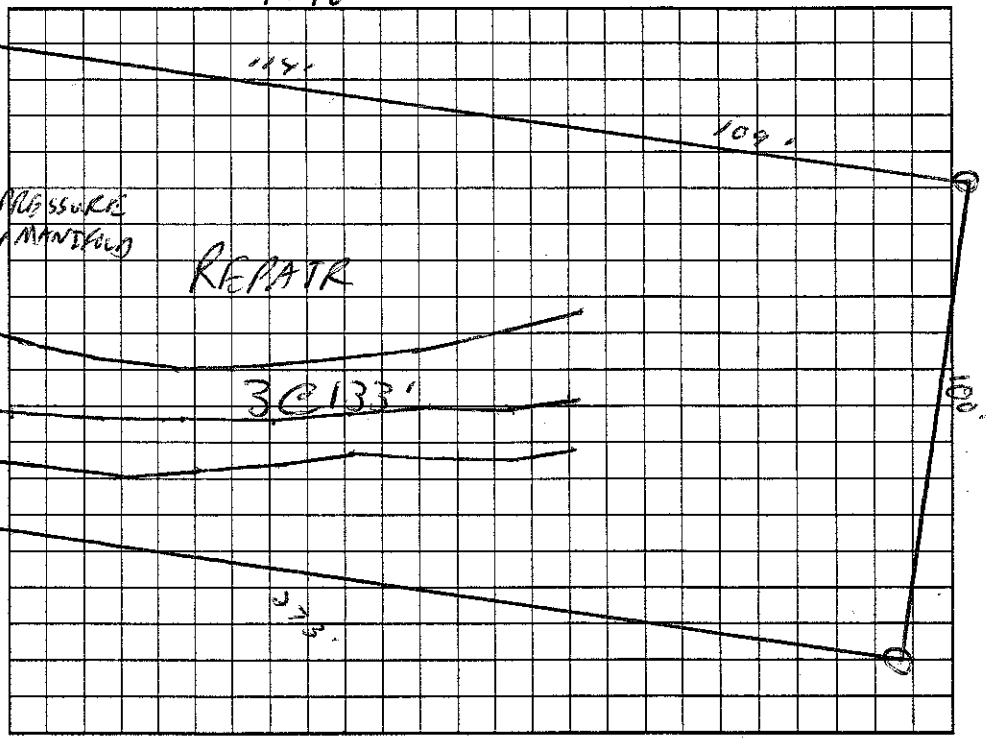

Permit can be suspended or revoked if any false information is supplied toward securing the permit/any unauthorized changes are made to the site/any unauthorized changes are made in the installation of the system. Improvement Permit with plat valid without expiration. Improvement Permit with site plan valid for sixty months. Authorization to Construct is valid for a period equal to that of Improvement Permit – not to exceed sixty months.

Signed: Mary Tucker date 5-17-05

Improvement Permit by: [signature] RS date 5/5/05

Authorization to Construct by: [signature] date 4-21-06

Installed by: Mary Tucker

Operation Permit by: [signature] date 5-9-07

Existing System Inspection by: date

HEALTH DEPT. COPY: WHITE OWNER COPY (FINAL): YELLOW OWNER COPY (INITIAL): PINK