IR[illegible]LL COUNTY HEALTH DEPARTMENT STATESVILLE 704-878-5305 MOORESVILLE 704-664-5281

IMPROVEMENT PERMIT / AUTHORIZATION TO CONSTRUCT / OPERATION PERMIT / EXISTING SYSTEM INSPECTION

PERMIT # 162605 PIN # 4664 577119 DATE August 4, 2010

OWNER or APPLICANT Tina Gains PHONE: Business 704-650-2002 Home: 704-990-6036

OWNER or APPLICANT ADDRESS 9156 Glen Ashley Dr Cornelius NC 28031

LOCATION / DIRECTIONS Shearers Rd. S. TL Anniston TR Logan Crossing

SUBDIVISION Anniston BLOCK / SECTION LOT # 35/35A LOT AREA .80 Ac. DESIGN FLOW 480gpd L.T.A.R. .25 gpd/ft 2

Septic Tank 1000 Gallons: STB 825 Date 7-20-10

Pump Tank 1000 Gallons: PT 301 Date 8-20-10

Pump Make ZOELLER Model E-189 Serial # 2-HP

Nitrification Field No Fields 1 No Lines 4 Linear Feet 330

Trench Width 24" Max. Trench Bottom Depth 30" Gravel Depth Sand ☐ GRAVITY ☒ PRESSURE

☒ New System ☐ Repair ☐ Expansion System Type I II III (IV) V VI

System Description: LP PPBPS

Repair System Description: LP PPBPS

Maintenance Agreement Required ☒ YES ☐ NO

☒ Residence No. Bedrooms 4

☐ Business No. Persons 8

☐ Other No. Employees

☐ Slab ☒ Crawl Space

☐ Basement w/plumbing ☐ Basement w/o plumbing

Water Supply: ☐ Private ☐ Public ☐ Community

Comments / Conditions

Max. 30" Trench Bottom

Comments / Conditions

INITIAL SITE SKETCH

See Plan from Rollins Soil & Environmental Services Approved by FCHD

AS BUILT SKETCH

INSTALLED AS DRAWN

Permit can be suspended or revoked if any false information is supplied toward securing the permit / any unauthorized changes are made to the site / any unauthorized changes are made in the installation of the system.

☐ *IMPROVEMENT PERMIT w/plan valid without expiration.* ☐ *IMPROVEMENT PERMIT w / site plan valid for 60 mos.* ☐ *AUTHORIZATION TO CONSTRUCT valid for period equal to IMPROVEMENT PERMIT-not to exceed 60 mo.*

Owner / Applicant Signature: [signature] Date 8/4/10

Improvement Permit by: [signature] Date 8-4-10

Authorization to Construct by: [signature] Date 8-4-10

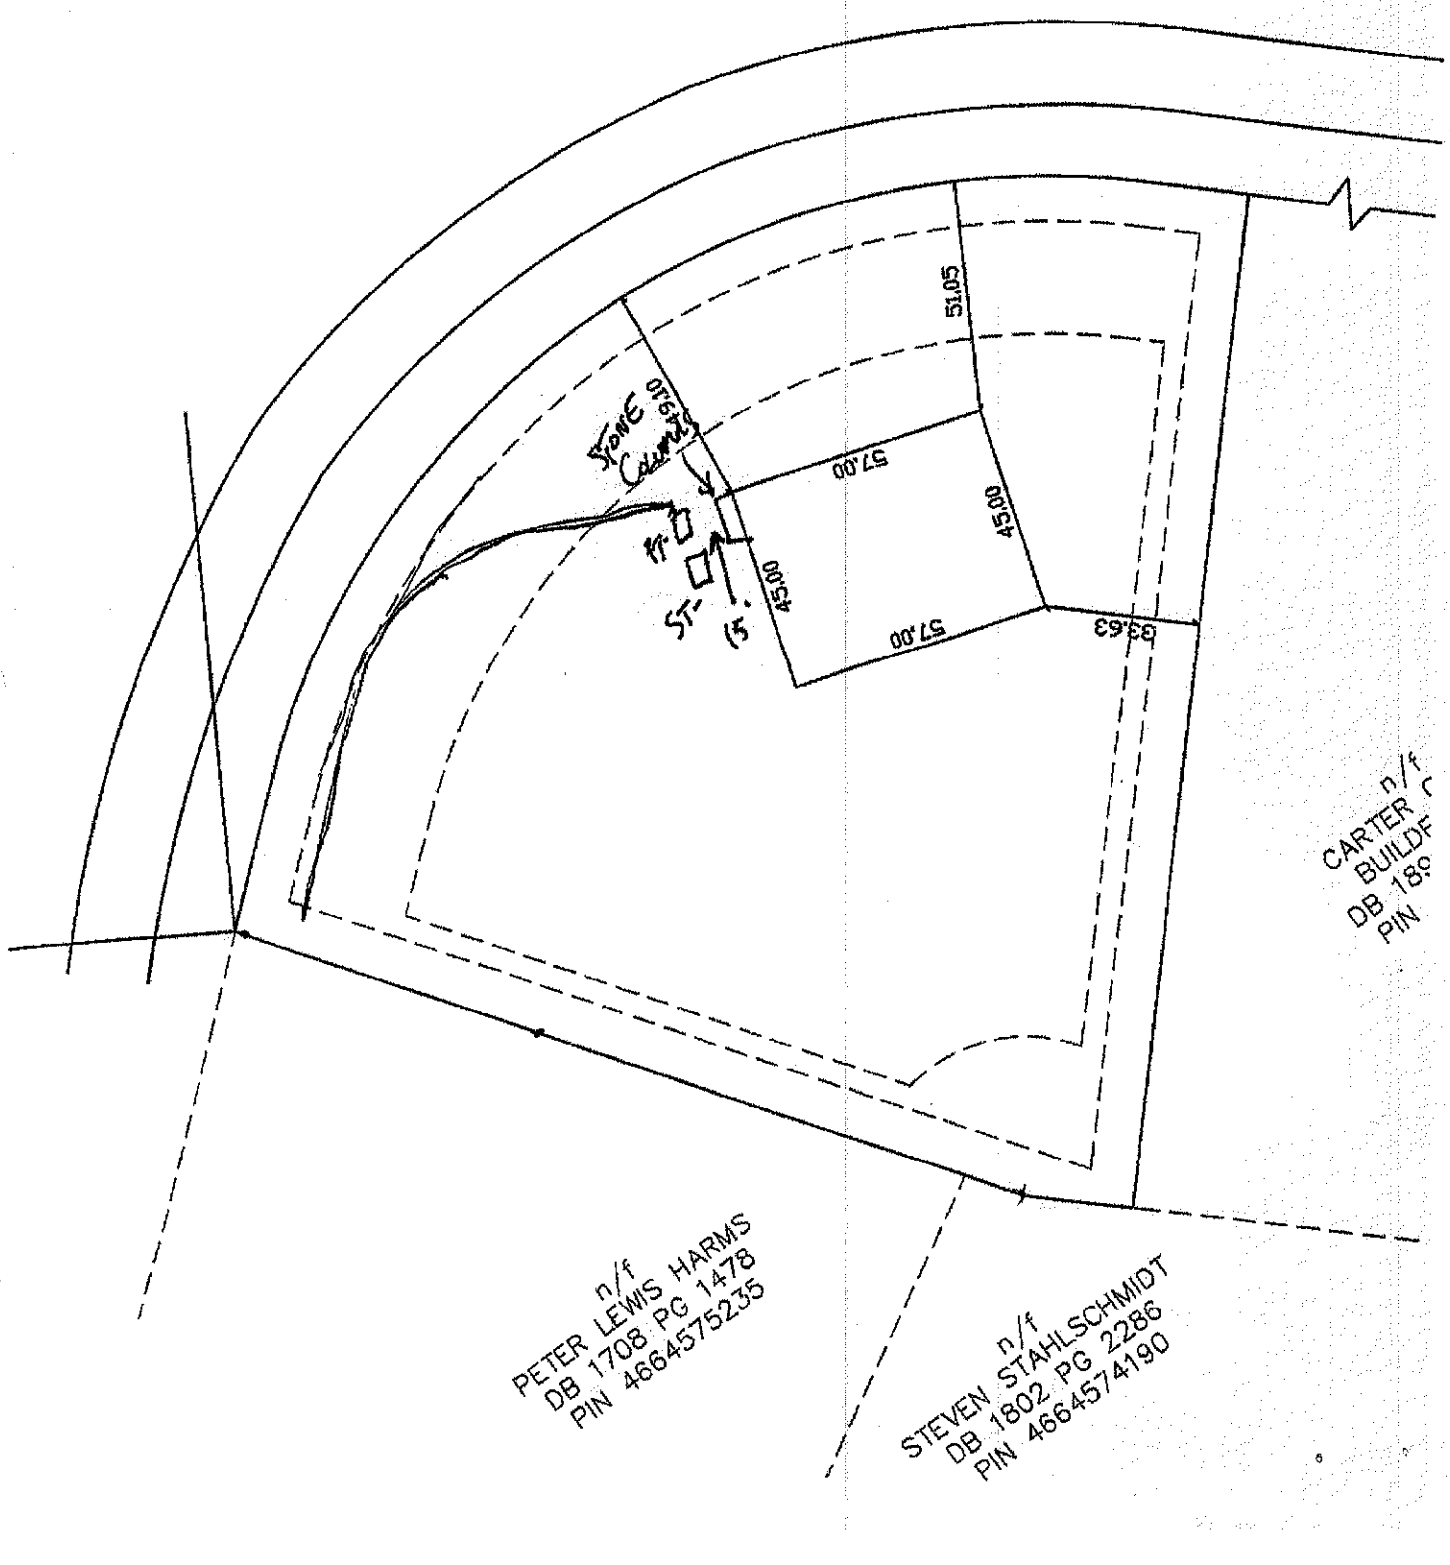
YOU SHOULD CONTACT A LOCATOR SERVICE PRIOR TO ANY EXCAVATION.

Installed by: Rowen Septic Tank

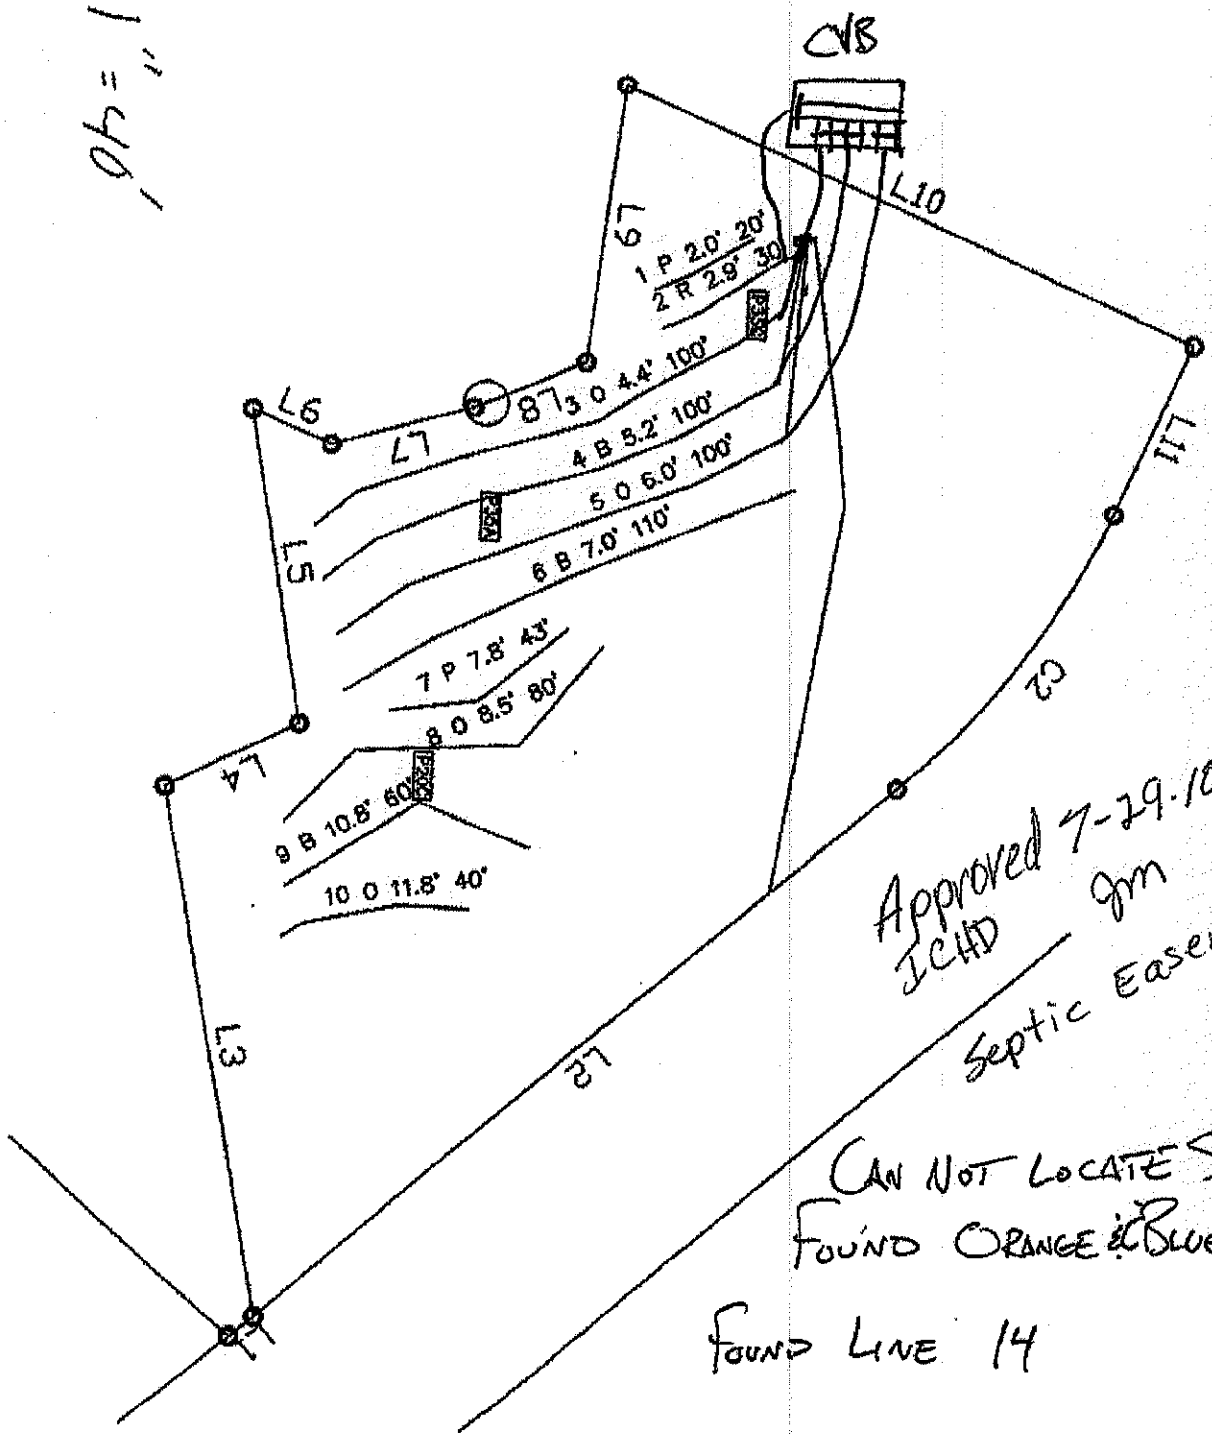
Operation Permit by: [signature] REHS Date: 12/13/10

Existing System Inspected by: Date:

WHITE COPY Environmental Health YELLOW COPY (Final) Owner / Applicant PINK COPY (Initial) Owner / Applicant


51.05
57.00
45.00
45.00
57.00
53.63
Stone Corner
n/f
PETER LEWIS HARMS
DB 1708 PG 1478
PIN 4664575235
n/f
STEVEN STAHLSCHMIDT
DB 1802 PG 2286
PIN 4664574190

1" = 100'


1" = 40'
CVB
L10
L9
1 P 2.0' 20'
2 R 2.9' 30'
L8
L7
8 3 O 4.4' 100'
4 B 5.2' 100'
5 O 6.0' 100'
6 B 7.0' 110'
7 P 7.8' 43'
8 O 8.5' 80'
9 B 10.8' 60'
10 O 11.8' 40'
L5
L4
L3
L2
L1
L11
L12
Approved 7-29-10
ICHD gm
Septic Easement
CAN NOT LOCATE S. LINE
FOUND ORANGE & BLUE?
FOUND LINE 14