IREDELL COUNTY HEALTH DEPARTMENT

Statesville Office (704) 878-5305 Mooresville Office (704) 660-3625 PERMIT # 207435

IMPROVEMENT PERMIT / AUTHORIZATION TO CONSTRUCT / OPERATION PERMIT / EXISTING SYSTEM

PIN # 4664577119

APPLICANT: Bananafish for Dominic LePore APPLICANT ADDRESS: 9222 Monroe Rd Charlotte

SITE ADDRESS: 174 Logan Crossing Drive PHONE: (704) 321-2997 ALT. PHONE: (860) 338-1734 Dominic Lepore


SITE DIRECTIONS: (174 Logan Crossing Drive) Go Shears Rd TL on Anniston Way TR on Logan Crossing

SUBDIVISION: Anniston SECTION: 1 LOT # 35/35A LOT AREA: .80 ac DESIGN FLOW: 480 L.T.A.R.: .25

Septic Tank 1000 usual (gal)	STB	Date	☐ New System ☐ Repair ☐ Expansion System Type: I II III (IV) V VI	☑ Residence	No. Bedrooms 4	Water Supply
Pump Tank 1000 usual (gal)	PT	Date	System Description: offsite PPBPS LPP district (existing)	☐ Business	No. Persons	☐ Private
Pump Make	Model	Serial #	Repair System Description: offsite LPP PPBPS	☐ Other	No. Employees	☐ Public
# Nitrification Fields 1	# Lines	Linear Ft:	Maintenance Agreement Required: ☑ YES ☐ NO	☐ Slab	☑ Crawl Space	☐ Community
Trench Width	Max. Trench Bottom Depth	Gravel Depth	☐ GRAVITY ☑ PRESSURE	☐ Basement w/plumbing		☐ Basement w/o plumbing

Comments / Conditions: This is an existing system reuse permit authorizing the construction of an in ground pool (250 sq ft) No increase in number of bedrooms or design flow

INITIAL SITE SKETCH

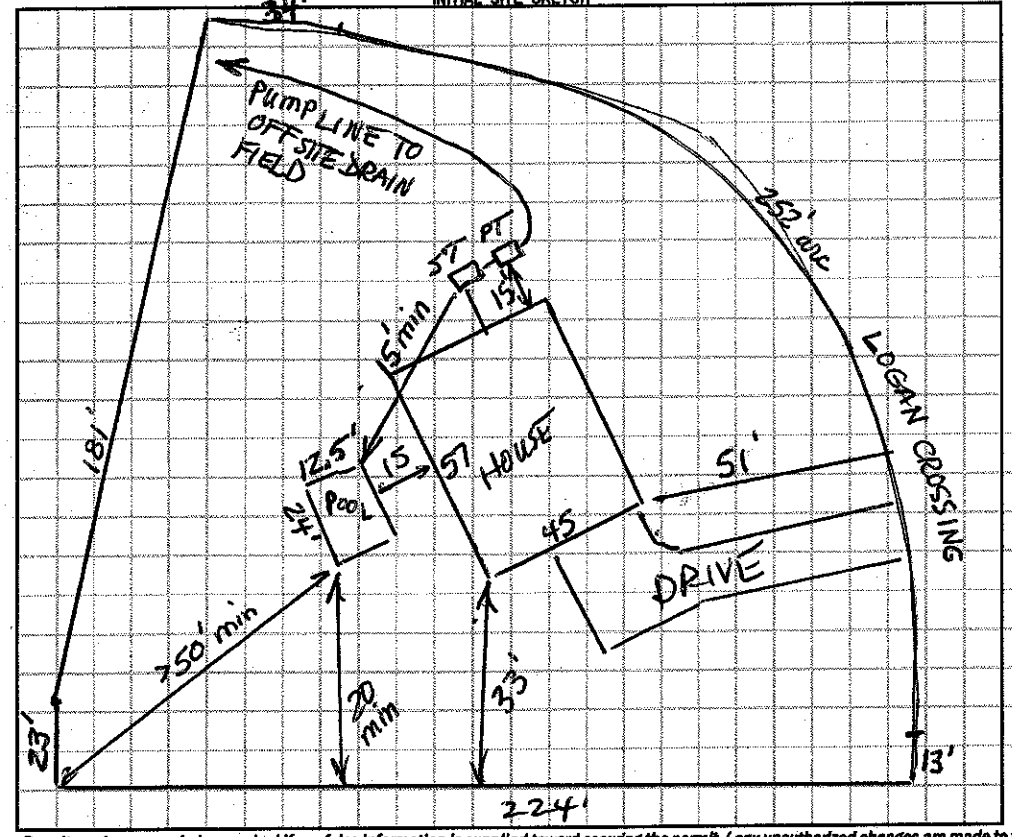

AS BUILT SKETCH

Permit can be suspended or revoked if any false information is supplied toward securing the permit / any unauthorized changes are made to the site / any unauthorized changes are made in the installation of the system. CONTACT A LOCATOR SERVICE PRIOR TO ANY EXCAVATION

☐ IMPROVEMENT PERMIT with plat valid without expiration. ☐ IMPROVEMENT PERMIT with site plan valid for 60 mos. ☐ AUTHORIZATION TO CONSTRUCT valid for period equal to IMPROVEMENT PERMIT--not to exceed 60 mo.

Owner / Location of the proposed pool addition does not appear to impact the existing on-site septic

IMPROVI system or well.**NOTE:

AUTHORI Richard Farris REHS Date: 12/31/14

ICHD-Environmental Health Division

Installed by:

OPERATION PERMIT by: Date:

Existing System Inspected by: Date:

Applicant (Final Approval) - YELLOW Applicant (Conditional Approval) - PINK