IREDELL COUNTY HEALTH DEPARTMENT

STATESVILLE 704-878-5305 MOORESVILLE 704-664-5281

IMPROVEMENT PERMIT / AUTHORIZATION TO CONSTRUCT / OPERATION PERMIT / EXISTING SYSTEM INSPECTION

PERMIT# 123255 PIN# 4664-67-0275.004 4664578628 DATE 4/15/05

OWNER OR CONTRACTOR RIDGELINE DEVELOPMENT/EDWARDS CONST. Business 362-5007 Home

ADDRESS 17105 KEATON DR. SUITE 207-D CORNELIUS NC 28031

LOCATION SHEARERS RD - TL ANNISTON - LOT ON RT - SEPTIC ON LEFT

SUBDIVISION ANNISTON BLOCK / SECTION 1 LOT 4 LOT AREA .75AC SITE CLASS. PS DESIGN FLOW 360GPD L.T.A.R. .25000/KT2

Septic Tank: 1000 Gallons; STB 794 Date 4/10/06

Pump Tank: 1000 Gallons; PT 27 Date 4/3/06

Pump Make: ~~Wilco~~ Gould Model WE0 511HH Serial No.

Nitrification Field: No Fields 1 Square Feet 1080 Linear Feet 360

No Lines 4 @ 90' Trench Width 36" Max Trench Bottom Depth (24") Gravel Depth

☑ New System ☐ Repair System Type: I, II, III, IV, V, VI

System Description: PUMP 2506 REDUCTION

Repair System Description: SAME

Maintenance Agreement Required: ☐ Yes ☑ No

☑ House/Mod. Home No. Bedrooms 3

☐ Mobile Home No. Bathrooms 3

☐ Business No. Employees

☐ Other

☐ Slab ☑ Crawl Space ☑ Basement w/plumbing ☐ Basement wo/plumbing


Water Supply: ☑ Individual ☐ Public ☐ Community

Comments:/Conditions:


Comments:/Conditions: 4/11

OFFSITE

INITIAL SITE SKETCH

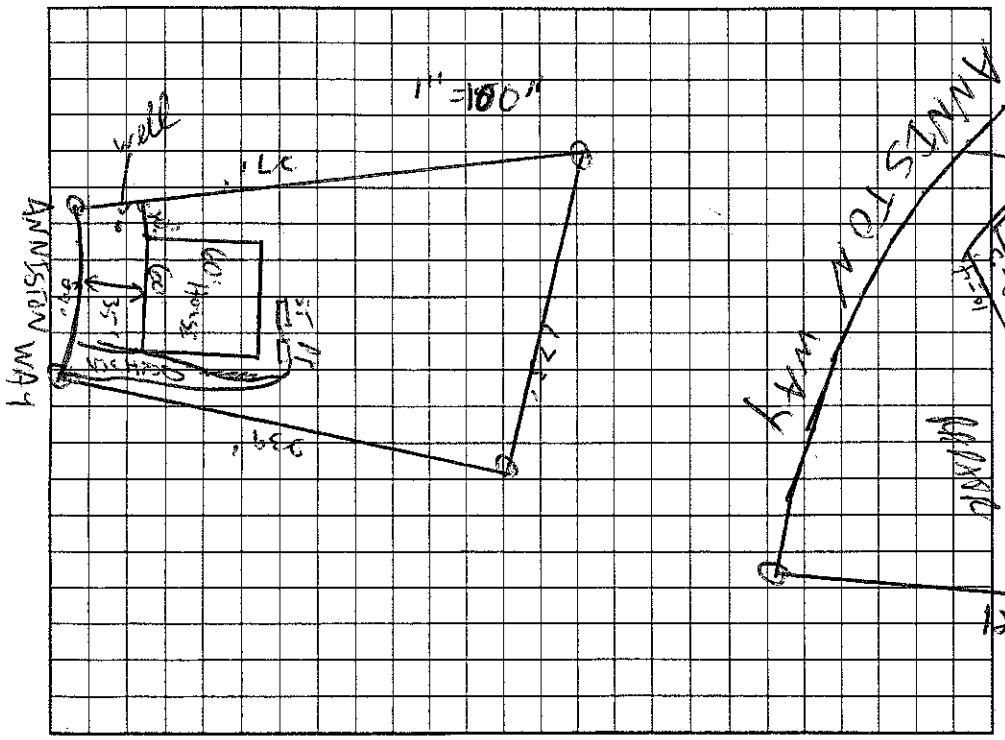

AS BUILT SKETCH

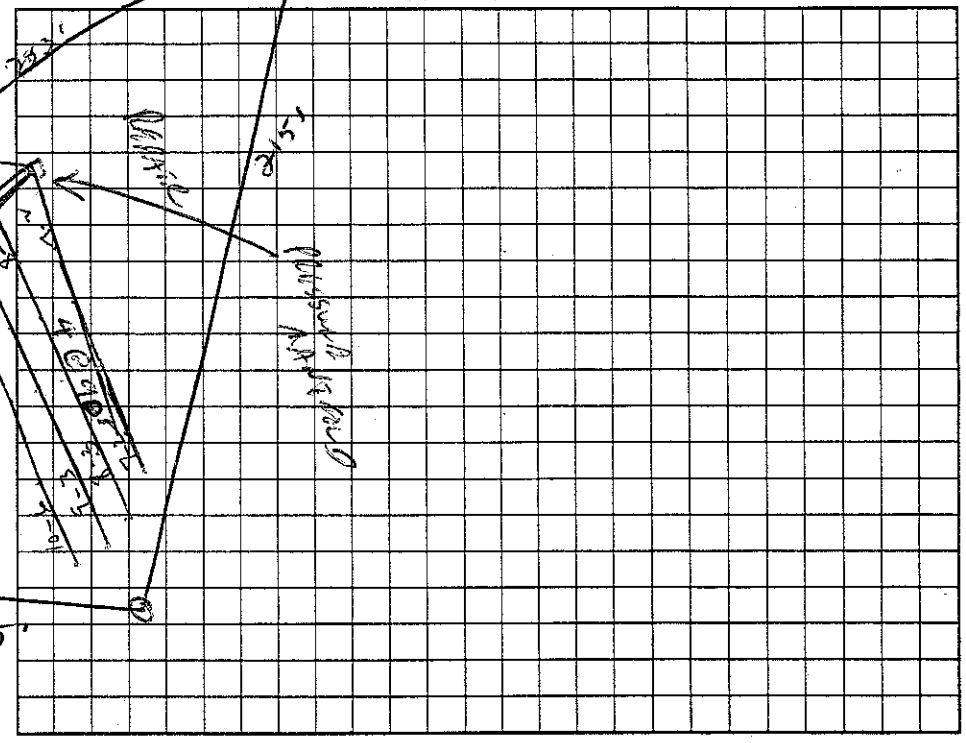

Permit can be suspended or revoked if any false information is supplied toward securing the permit/any unauthorized changes are made to the site/any unauthorized changes are made in the installation of the system. Improvement Permit with plat valid without expiration. Improvement Permit with site plan valid for sixty months. Authorization to Construct is valid for a period equal to that of Improvement Permit – not to exceed sixty months.

Signed: [signature] date 5-11-05

Improvement Permit by: [signature] RS date 4/15/05

Authorization to Construct by: [signature] RS date 8/25/05

Installed by: [signature] date 7/3/06

Operation Permit by: [signature] RS date 6/16/06

Existing System Inspection by: date

HEALTH DEPT. COPY: WHITE OWNER COPY (FINAL): YELLOW OWNER COPY (INITIAL): PINK