IREDELL COUNTY HEALTH DEPARTMENT

STATESVILLE 704-878-5305 MOORESVILLE 704-664-5281

IMPROVEMENT PERMIT / AUTHORIZATION TO CONSTRUCT / OPERATION PERMIT / EXISTING SYSTEM INSPECTION

PERMIT # 130787 PIN # 4664 57 9086 DATE 9/16/09

OWNER or APPLICANT TREY WILLIS PHONE: Business 704-904-9097 Home:

OWNER or APPLICANT ADDRESS 10421 FRIARSGATE RD. HUNTERSVILLE, N.C. 28078

LOCATION / DIRECTIONS 179 LOGANSCROSSING DRIVE, SHEARER RD TL ANNISTON WAY TR LOGAN CROSSING ON (L)

SUBDIVISION ANNISTON BLOCK / SECTION 1 LOT # 22 LOT AREA ~1.2AC DESIGN FLOW 480 L.T.A.R. .2

Septic Tank 1000 Gallons: STB 794 Date 9-16-09

Pump Tank 1000 Gallons: ~~STB~~ Date

Pump Make Model Serial #

Nitrification Field No Fields 2 No Lines 8 Linear Feet 75' 600

Trench Width 3' Max Trench Bottom Depth 18" Gravel Depth 8" NA

☒ New System ☐ Repair ☐ Expansion System Type I (II) III IV V VI

System Description: FD-2DB - 25% REDUCTION

Repair System Description: LP - DRIP IRRIGATION

Maintenance Agreement Required ☐ YES ☒ NO

☒ GRAVITY ☐ PRESSURE

☒ Residence No. Bedrooms 4

☐ Business No. Persons

☐ Other No. Employees

☐ Slab ☐ Crawl Space

☒ Basement w/plumbing ☐ Basement w/o plumbing

Water Supply: ☒ Private ☐ Public ☐ Community

Comments / Conditions

75' x 3'

8'


75' x 3'

DB

Comments / Conditions

18 CHAM EACH LINE

INITIAL SITE SKETCH

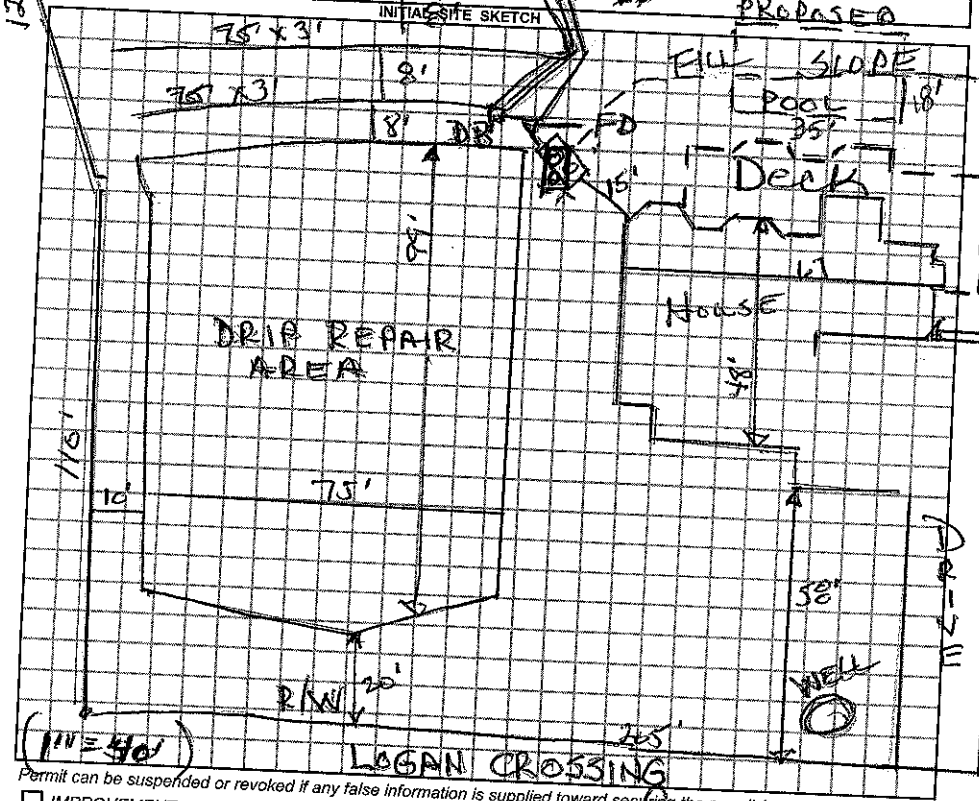

AS BUILT SKETCH

INSTALLED AS DRAWN

The location of the proposed Pool addition does not appear to impact the existing septic system.

**NOTE: Pool must be min. 15' from Septic

Shasty Melville REHS

Date: 4-25-11

ICHD-Environmental Health Division

Permit can be suspended or revoked if any false information is supplied toward securing the permit / any unauthorized changes are made to the site / any unauthorized changes are made in the installation of the system.

☐ IMPROVEMENT PERMIT w / plat valid without expiration. ☐ IMPROVEMENT PERMIT w / site plan valid for 60 mos. ☒ AUTHORIZATION TO CONSTRUCT valid for period equal to IMPROVEMENT PERMIT-not to exceed 60 mo.

Owner / Applicant Signature: Laura Unsworth Date 9/11/09

Improvement Permit by: Wesley Sparks R.S. Date 9/16/09

Authorization to Construct by: Wesley Sparks R.S. Date 9/16/09

YOU SHOULD CONTACT A LOCATOR SERVICE PRIOR TO ANY EXCAVATION.

Installed by: MARTY TUCKER

Operation Permit by: REHS Date: 11-6-09

Existing System Inspected by: Date:

WHITE COPY Environmental Health YELLOW COPY (Final) Owner / Applicant PINK COPY (Initial) Owner / Applicant