IREDELL COUNTY HEALTH DEPARTMENT

STATESVILLE 704-878-5305 — MOORESVILLE 704-664-5281

IMPROVEMENT PERMIT / AUTHORIZATION TO CONSTRUCT / OPERATION PERMIT / EXISTING SYSTEM INSPECTION

PERMIT# 130786 PIN# 4664 57 2559, 021 4664-57-9273 DATE Sept 7, 2005

OWNER OR CONTRACTOR Anniston LLC PHONE: Business 704-362-5507 Home

ADDRESS 17824 Statesville Rd. Suite 112 Cornelius, N.C. 28031

LOCATION Spencers Rd. (S) TL Anniston Way TR Logan Crossing DR. on left

SUBDIVISION Anniston BLOCK / SECTION 1 LOT 210 LOT AREA 1.23Ac ± SFE SITE CLASS. PS DESIGN FLOW 360gpd L.T.A.R. 2 initial onsite @ .25 Perm 21A

Septic Tank: 1000 Gallons; STB 794 Date 7/28/07

Pump Tank: Gallons; PT Date

Pump Make: Model Serial No.

Nitrification Field: No Fields 1 Square Feet 1350 Linear Feet 450

No Lines 7 Trench Width 36" Max Trench Bottom Depth 18"

☒ New System ☐ Repair System Type: I, II, III, IV, V, VI

System Description: Gravity 25% Red. "accepted"

Repair System Description: LP PPBPS on SFE 21A

Maintenance Agreement Required: ☐ Yes ☒ No initially

Gravel Depth N/A

☒ House/Mod. Home ☐ Mobile Home ☐ Business ☐ Other

No. Bedrooms 3 No. Bathrooms No. Employees

☐ Slab ☒ Crawl Space ☐ Basement w/plumbing ☐ Basement wo/plumbing

Water Supply: ☒ Individual ☐ Public ☐ Community

Comments:/Conditions:

elevated site evaluation and system design performed by Rollins Soil and Environmental Services.


Comments:/Conditions: System installed as shown

≈50' ↑ to Back P/L

INITIAL SITE SKETCH

SEE Plan by Ashley Rollins

AS BUILT SKETCH NTS

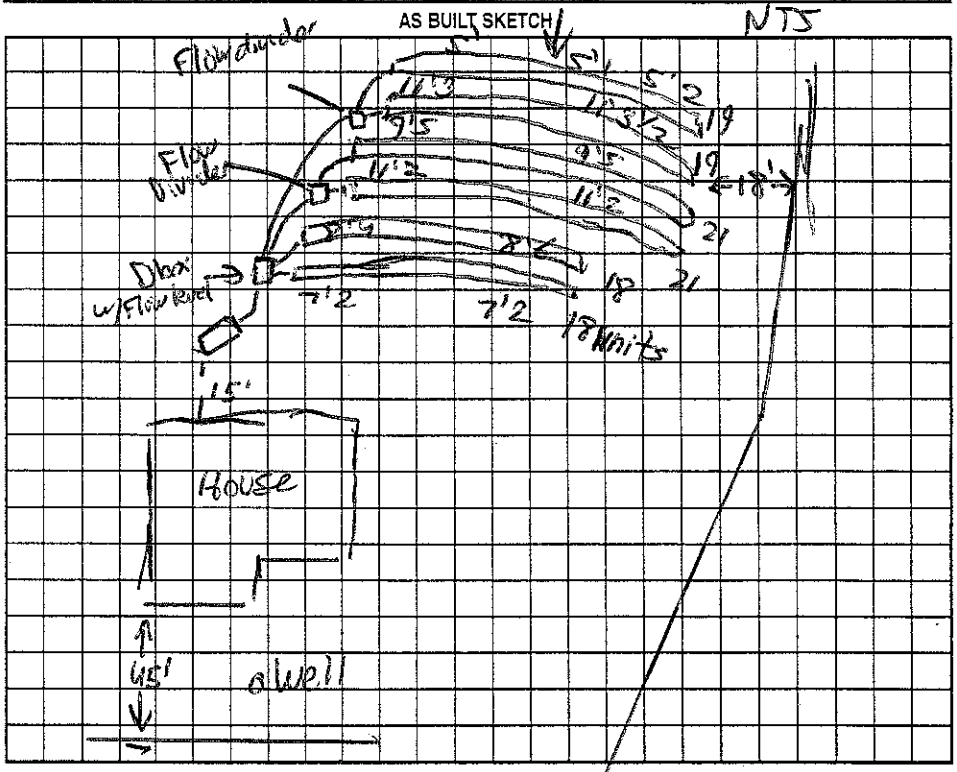

Permit can be suspended or revoked if any false information is supplied toward securing the permit/any unauthorized changes are made to the site/any unauthorized changes are made in the installation of the system. Improvement Permit with plat valid without expiration. Improvement Permit with site plan valid for sixty months. Authorization to Construct is valid for a period equal to that of Improvement Permit – not to exceed sixty months.

Signed: Lori Tomaszewski date 9-27-05 Installed by: Tucker Hauling & Grading

Improvement Permit by: date 9-7-05 Operation Permit by: Anthony Coker Jr. date 1-7-08

Authorization to Construct by: date 9/9/07 Existing System Inspection by: date

HEALTH DEPT. COPY: WHITE OWNER COPY (FINAL): YELLOW OWNER COPY (INITIAL): PINK