IREDELL COUNTY HEALTH DEPARTMENT

STATESVILLE 704-878-5305 / 130.00 Paid / MOORESVILLE 704-664-5281

IMPROVEMENT PERMIT / AUTHORIZATION TO CONSTRUCT / OPERATION PERMIT / EXISTING SYSTEM INSPECTION

PERMIT# 130785 PIN# 4664 57 ~~2559.020~~ 9309 v DATE Sept 7, 2005

OWNER OR CONTRACTOR Anniston LLC / WINSOR HOLLIES PHONE: Business 704 362 - 5007 Home

ADDRESS 17824 Statesville Rd., Suite 112 Cornelius N.C. 28031

LOCATION Shearers Rd. (S) TL Anniston Way TR Logan Crossing Dr. on left

SUBDIVISION Anniston BLOCK / SECTION 1 LOT 210-212 LOT AREA 1.189 ac ± SITE CLASS. PS SPE DESIGN FLOW 360 gpd L.T.A.R. .020

Septic Tank: 1000 Gallons; STB 760 Date 7/8

Pump Tank: 1000 Gallons; PT 363 Date 4/15

Pump Make: GOULDS Model BLASTER Serial No. DEB 1022

Nitrification Field: No Fields 1 Square Feet 1380 Linear Feet 460

No Lines 4 @ 115'ea · Trench Width .36" Max Trench Bottom Depth 18"

☐ New System ☐ Repair System Type: I, II, III, IV, V, VI

System Description: pm 25% Reduction

Repair System Description: LP 25% Reduction

Maintenance Agreement Required: ☐ Yes ☒ No initially

☒ House/Mod. Home No. Bedrooms 3

☐ Mobile Home No. Bathrooms ___

☐ Business No. Employees ___

☐ Other ___

Water Supply: ☒ Individual ☐ Public ☐ Community

Gravel Depth NA ☐ Slab ☒ Crawl Space ☐ Basement w/plumbing ☐ Basement wo/plumbing

Comments:/Conditions:

Mutual site evaluation and system design performed by Rollins Soil and Environmental Services

Comments:/Conditions:

INITIAL SITE SKETCH

Logan Crossing N.

161

SEE PLAN by Ashley Rollins

AS BUILT SKETCH

The proposed POOL addition does not appear to impact the existing septic system.

**NOTE: SYSTEM UNDER CONSTRUCTION

Wesley Sparks R.S.

Date: 12/3/08

ICHD-Environmental Health Division

ENTERED

Permit can be suspended or revoked if any false information is supplied toward securing the permit/any unauthorized changes are made to the site/any unauthorized changes are made in the installation of the system. Improvement Permit with plat valid without expiration. Improvement Permit with site plan valid for sixty months. Authorization to Construct is valid for a period equal to that of Improvement Permit – not to exceed sixty months.

Signed: Keri Tomasewski date 9-27-05

Improvement Permit by: [signature] R.S. date 9-7-05


Authorization to Construct by: Wesley Sparks R.S. date 7/22/08

Installed by: Hog Log Septic Tank

Operation Permit by: [signature] date 12-3-08

Existing System Inspection by: ___ date ___

HEALTH DEPT. COPY: WHITE OWNER COPY (FINAL): YELLOW OWNER COPY (INITIAL): PINK

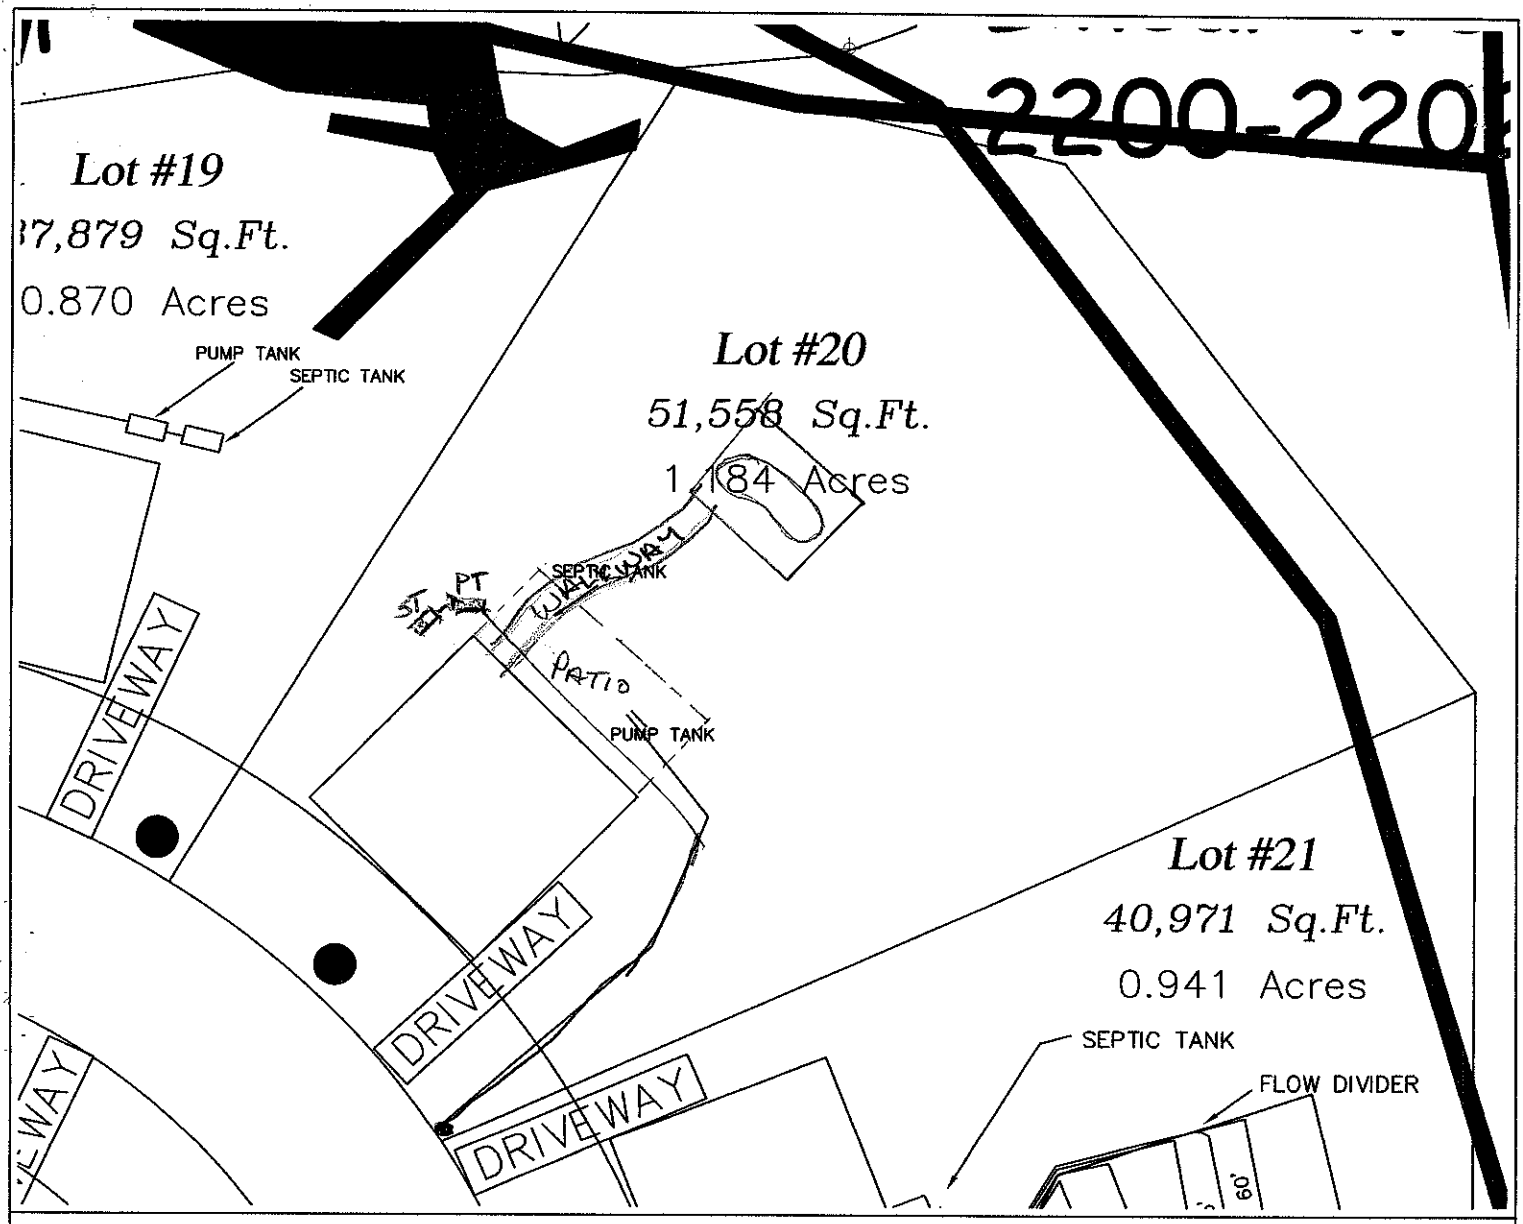

LEGEND

- Areas contain soils with 24 inches or more of useable material and have potential for conventional, modified conventional and low-pressure pipe (lpp) septic systems.
- Building Envelope (60' x 60')
- System lines.
- Repair lines.
- Temporary Bench Mark (TBM)
- Well Location.

GRAPHIC SCALE
1" = 50'

50 0 50 100

FOR PRELIMINARY PLANNING PURPOSES ONLY. ALL LOTS WILL REQUIRE FINAL APPROVAL BY THE COUNTY HEALTH DEPARTMENT ON A LOT BY LOT BASIS. THIS MAP SHOULD BY USED AS A GENERAL GUIDE, SOME ADJUSTMENTS WILL BE NECESSARY IN THE FIELD DUE TO SOIL VARIABILITY AND COMPLEX TOPOGRAPHIC FEATURES. THIS MAP ONLY REFLECTS EXISTING SOIL SUITABILITY FOR ON-SITE SEPTIC TANK SYSTEMS.

PLEASE REFER TO ATTACHED SOIL REPORT FOR ADDITIONAL SITE SPECIFIC INFORMATION


ROLLANS SOIL & ENVIRONMENTAL SERVICES
2120 GRAHAM ROAD
MOUNT ULLA, NC 28125
PHONE/FAX: (704) 278 - 0989
ASHLEY ROLLANS, NC LICENSED SOIL SCIENTIST
MOBILE: (704) 746 - 5046
EMAIL: ROLLANSFORTCJ@AOL.COM

MAP TITLE: SITE PLAN & DRAINFIELD AREAS

PROJECT NAME: RIDGELINE DEVELOPMENT CORP. / ANNISTON PHASE II

LOCATION/DATE: SHEARER CHAPEL ROAD, IREDELL COUNTY, NORTH CAROLINA, AUGUST 2005

JOB # : 01-1005
FILE: C:\JOBS\01-1005
PROJECT MGR.: S.A.R.
FIELD WORK: S.A.R.
DRAWN BY: S.A.R.

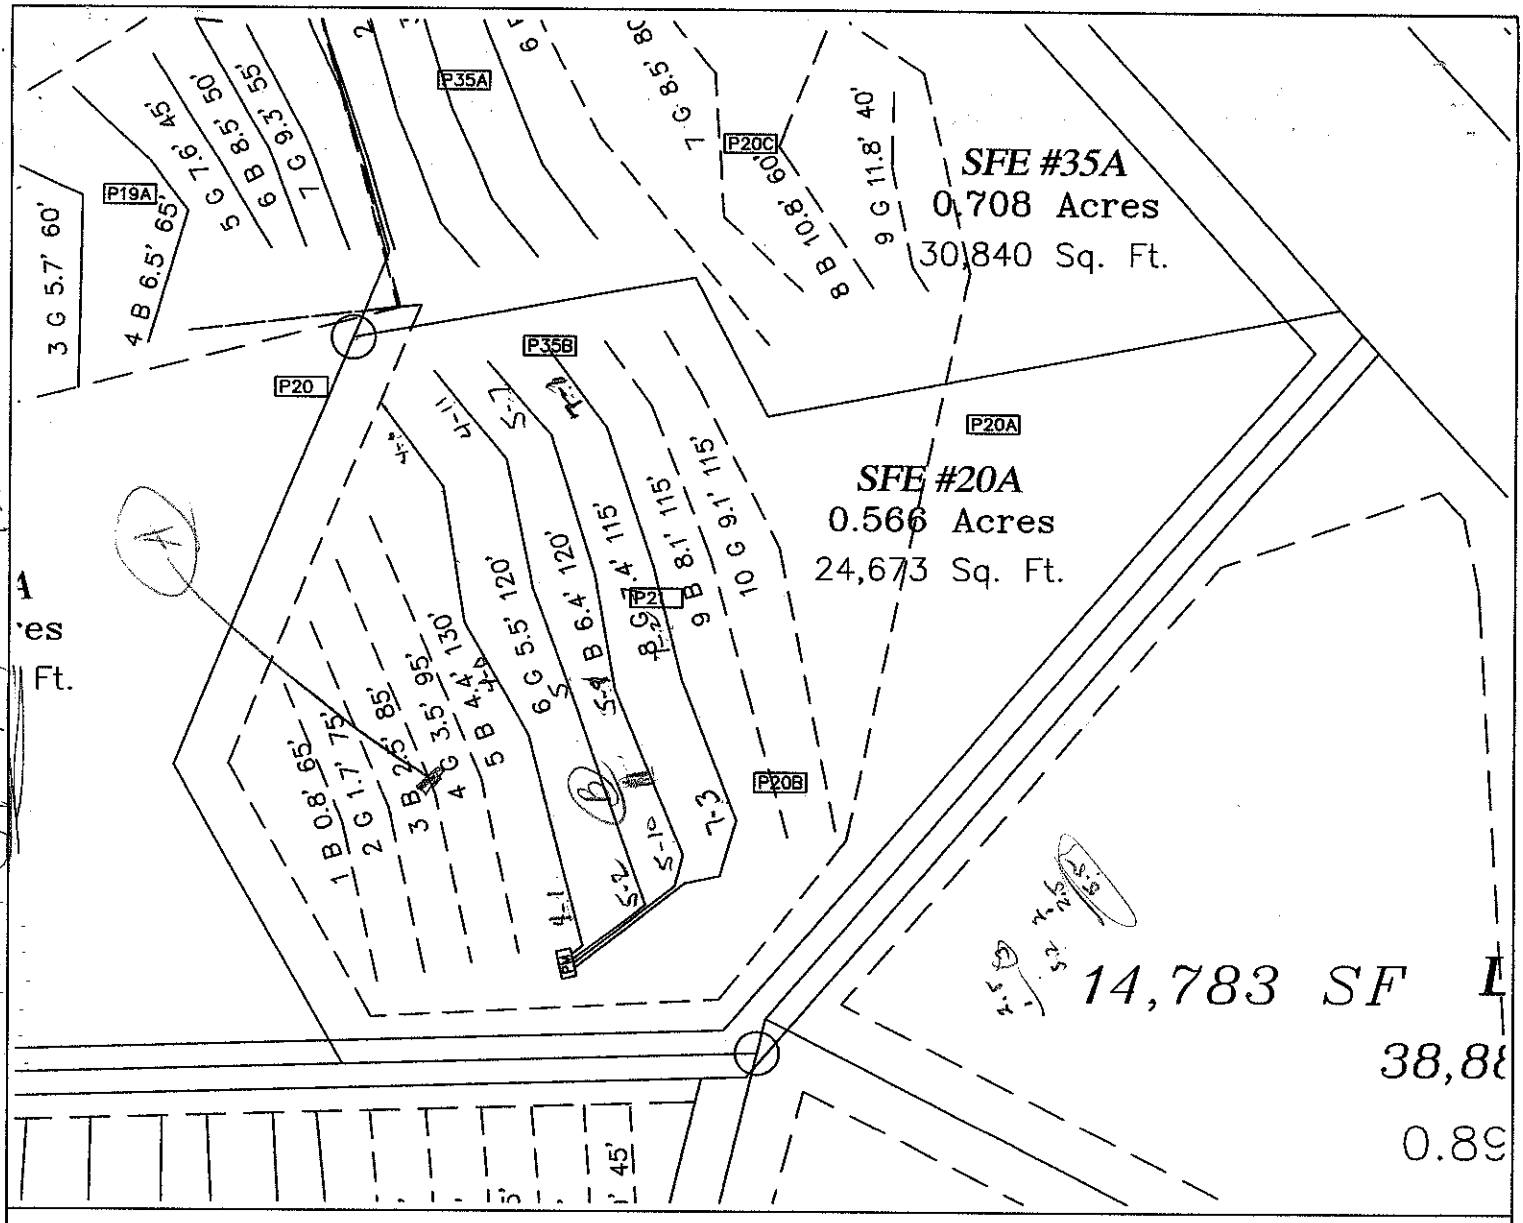

LEGEND

- Areas contain soils with 24 inches or more of useable material and have potential for conventional, modified conventional and low-pressure pipe (lpp) septic systems.
- Building Envelope (60' x 60')
- System lines.
- Repair lines.
- Temporary Bench Mark (TBM)
- Well Location.

GRAPHIC SCALE
1" = 40'

40 0 40 80

FOR PRELIMINARY PLANNING PURPOSES ONLY. ALL LOTS WILL REQUIRE FINAL APPROVAL BY THE COUNTY HEALTH DEPARTMENT ON A LOT BY LOT BASIS. THIS MAP SHOULD BY USED AS A GENERAL GUIDE, SOME ADJUSTMENTS WILL BE NECESSARY IN THE FIELD DUE TO SOIL VARIABILITY AND COMPLEX TOPOGRAPHIC FEATURES. THIS MAP ONLY REFLECTS EXISTING SOIL SUITABILITY FOR ON-SITE SEPTIC TANK SYSTEMS.

PLEASE REFER TO ATTACHED SOIL REPORT FOR ADDITIONAL SITE SPECIFIC INFORMATION

ROLLANS SOIL & ENVIRONMENTAL SERVICES
2120 GRAHAM ROAD
MOUNT ULLA, NC 28125
PHONE/FAX: (704) 278 - 0989
ASHLEY ROLLANS, NC LICENSED SOIL SCIENTIST
MOBILE: (704) 746 - 5046
EMAIL: ROLLANSFORTCJ@AOL.COM

MAP TITLE: SITE PLAN & DRAINFIELD AREAS

PROJECT NAME: RIDGELINE DEVELOPMENT CORP. / ANNISTON PHASE II

LOCATION/DATE: SHEARER CHAPEL ROAD, IREDELL COUNTY, NORTH CAROLINA, AUGUST 2005

JOB # : 01-1005
FILE: C:\JOBS\01-1005
PROJECT MGR.: S.A.R.
FIELD WORK: S.A.R.
DRAWN BY: S.A.R.