IREDELL COUNTY HEALTH DEPARTMENT

STATESVILLE 704-878-5305 / 130.00 Paid MOORESVILLE 704-664-5281

IMPROVEMENT PERMIT / AUTHORIZATION TO CONSTRUCT / OPERATION PERMIT / EXISTING SYSTEM INSPECTION

PERMIT# 130785 PIN# 4664 57 2559.020 9309 DATE Sept 7, 2005

OWNER OR CONTRACTOR Anniston LLC / WYNSOR HOLMES PHONE: Business 704 362 - 9007 Home

ADDRESS 17824 Statesville Rd., Suite 112 Cornelius, N.C. 28031

LOCATION Shearers Rd. (S) TL Anniston Way TR Logan Crossing Dr. on left

SUBDIVISION Anniston BLOCK / SECTION 1 LOT 30-36 LOT AREA 1.189 AC + 1.59 AC SFE SITE CLASS. PS SFE DESIGN FLOW 360 gpd L.T.A.R. .20

Septic Tank: 1000 Gallons; STB 760 Date 7/8

Pump Tank: 1000 Gallons; PT 363 Date 4/15

Pump Make: GOULDS Model BLASTER Serial No. DEB 1022

Nitrification Field: No. Fields 1 Square Feet 1380 Linear Feet 460

No. Lines 4 @ 115' ea. Trench Width 36" Max Trench Bottom Depth 18" Gravel Depth NA

☐ New System ☐ Repair System Type: I, II, III, IV, V, VI

System Description: pm 25% Reduction

Repair System Description: LP 25% Reduction

Maintenance Agreement Required: ☐ Yes ☒ No initially

☒ House/Mod. Home No. Bedrooms 3

☐ Mobile Home No. Bathrooms ____

☐ Business No. Employees ____

☐ Other ____

☐ Slab ☒ Crawl Space ☐ Basement w/plumbing ☐ Basement wo/plumbing

Water Supply: ☒ Individual ☐ Public ☐ Community

Comments:/Conditions:

Initial site evaluation and system design performed by Rollins Soil and Environmental Services

Comments:/Conditions:

INITIAL SITE SKETCH

SEE Plan by Ashley Rollins

AS BUILT SKETCH

The proposed POOL addition does not appear to impact the existing septic system.

**NOTE: SYSTEM UNDER CONSTRUCTION

Wesley Sparks R.S.

Date: 12/3/08

ICHD-Environmental Health Division

Permit can be suspended or revoked if any false information is supplied toward securing the permit/any unauthorized changes are made to the site/any unauthorized changes are made in the installation of the system. Improvement Permit with plat valid without expiration. Improvement Permit with site plan valid for sixty months. Authorization to Construct is valid for a period equal to that of Improvement Permit – not to exceed sixty months.

Signed: Lori Tomaselli date 9-27-05

Improvement Permit by: [signature] R.S. date 9-7-05


Authorization to Construct by: [signature] date 7/22/08

Installed by: Stag Septic Tank date 12-3-08

Operation Permit by: [signature] date

Existing System Inspection by: ____ date ____

HEALTH DEPT. COPY: WHITE OWNER COPY (FINAL): YELLOW OWNER COPY (INITIAL): PINK

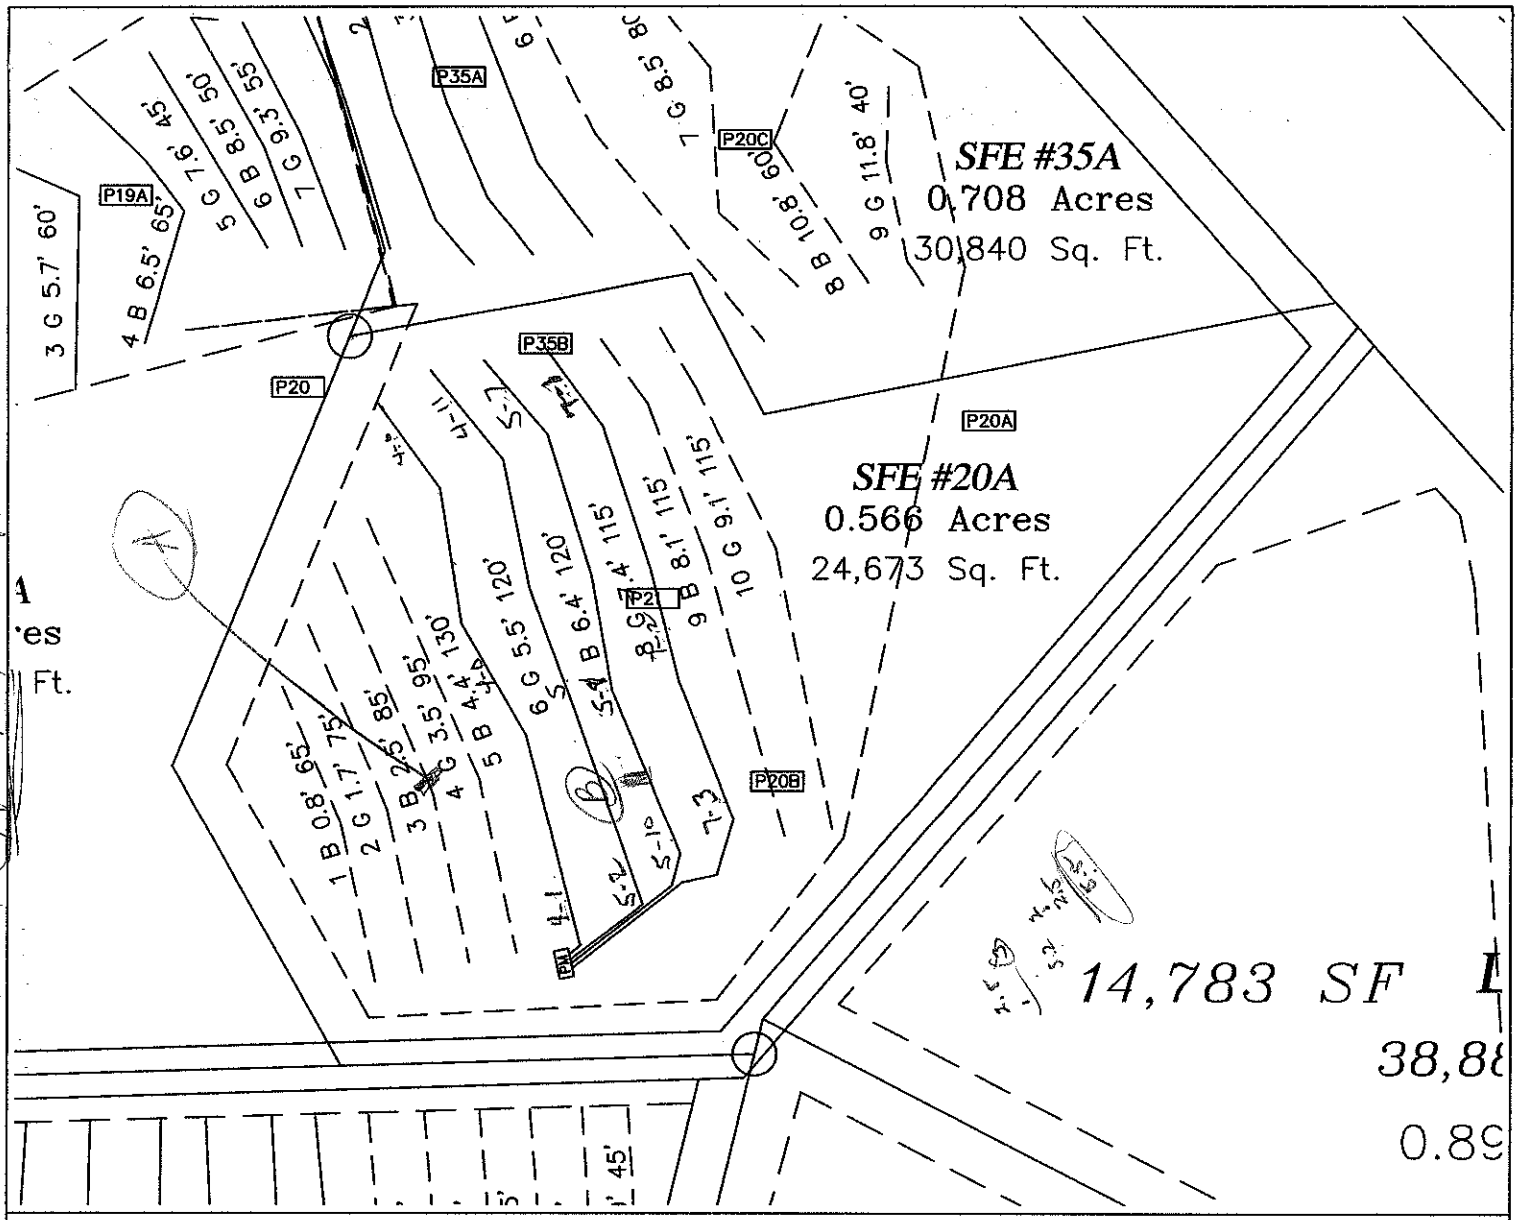

LEGEND

- Areas contain soils with 24 inches or more of useable material and have potential for conventional, modified conventional and low-pressure pipe (lpp) septic systems.
- Building Envelope (60' x 60')
- System lines.
- Repair lines.
- Temporary Bench Mark (TBM)
- Well Location.

GRAPHIC SCALE
1" = 40'

40 0 40 80

FOR PRELIMINARY PLANNING PURPOSES ONLY. ALL LOTS WILL REQUIRE FINAL APPROVAL BY THE COUNTY HEALTH DEPARTMENT ON A LOT BY LOT BASIS. THIS MAP SHOULD BY USED AS A GENERAL GUIDE, SOME ADJUSTMENTS WILL BE NECESSARY IN THE FIELD DUE TO SOIL VARIABILITY AND COMPLEX TOPOGRAPHIC FEATURES. THIS MAP ONLY REFLECTS EXISTING SOIL SUITABILITY FOR ON-SITE SEPTIC TANK SYSTEMS.

PLEASE REFER TO ATTACHED SOIL REPORT FOR ADDITIONAL SITE SPECIFIC INFORMATION

ROLLANS SOIL & ENVIRONMENTAL SERVICES
2120 GRAHAM ROAD
MOUNT ULLA, NC 28125
PHONE/FAX: (704) 278 - 0989
ASHLEY ROLLANS, NC LICENSED SOIL SCIENTIST
MOBILE: (704) 746 - 5046
EMAIL: ROLLANSFORTCJ@AOL.COM

MAP TITLE: SITE PLAN & DRAINFIELD AREAS

PROJECT NAME: RIDGELINE DEVELOPMENT CORP. / ANNISTON PHASE II

LOCATION/DATE: SHEARER CHAPEL ROAD, IREDELL COUNTY, NORTH CAROLINA, AUGUST 2005

JOB # : 01-1005
FILE: C:\JOBS\01-1005
PROJECT MGR.: S.A.R.
FIELD WORK: S.A.R.
DRAWN BY: S.A.R.

IREDELL COUNTY HEALTH DEPARTMENT

STATESVILLE 704-878-5305 / 130.00 Paid / MOORESVILLE 704-664-5281

IMPROVEMENT PERMIT / AUTHORIZATION TO CONSTRUCT / OPERATION PERMIT / EXISTING SYSTEM INSPECTION

PERMIT# 130785 PIN# 4664 57 ~~2559,020~~ 9309 DATE Sept 7, 2005

OWNER OR CONTRACTOR Anniston LLC / WINSOR HOLMES PHONE: Business 704 362 - 5007 Home

ADDRESS 17824 Statesville Rd., Suite 112, Cornelius N.C. 28031

LOCATION Shearers Rd. (S) TL Anniston Way TR Logan Crossing Dr. on left

SUBDIVISION Anniston BLOCK / SECTION 1 LOT 30-32 LOT AREA 1.184 Ac +.59 Ac SITE CLASS. PS SPE DESIGN FLOW 360gpd L.T.A.R. .20

Septic Tank: 1000 Gallons; STB 760 Date 7/8

Pump Tank: 1000 Gallons; PT 363 Date 4/15

Pump Make: Gould's Model BLASTER Serial No. DEB 1022

Nitrification Field: No Fields 1 Square Feet 1380 Linear Feet 460

No Lines 4 @ 115'ea · Trench Width 36" Max Trench Bottom Depth 18" Gravel Depth NA

☐ New System ☐ Repair System Type: I, II, III, IV, V, VI

System Description: one 25% Reduction

Repair System Description: LP 25% Reduction

Maintenance Agreement Required: ☐ Yes ☒ No initially

☒ House/Mod. Home ☐ Mobile Home ☐ Business ☐ Other

No. Bedrooms 3 No. Bathrooms ____ No. Employees ____

☐ Slab ☒ Crawl Space ☐ Basement w/plumbing ☐ Basement wo/plumbing

Water Supply: ☒ Individual ☐ Public ☐ Community

Comments:/Conditions:

Clinical site evaluation and system design performed by Rollans Soil and Environmental Services

Comments:/Conditions:

INITIAL SITE SKETCH

SEE Plan by Ashley Rollans

AS BUILT SKETCH

The proposed POOL addition does not appear to impact the existing septic system.

**NOTE: SYSTEM UNDER CONSTRUCTION

Wesley Sparks R.S.

Date: 12/3/08

ICHD-Environmental Health Division

Permit can be suspended or revoked if any false information is supplied toward securing the permit/any unauthorized changes are made to the site/any unauthorized changes are made in the installation of the system. Improvement Permit with plat valid without expiration. Improvement Permit with site plan valid for sixty months. Authorization to Construct is valid for a period equal to that of Improvement Permit – not to exceed sixty months.

Signed: Lori Tomaselli date 9-27-05

Improvement Permit by: [signature] R.S. date 9-7-05


Authorization to Construct by: Wesley Sparks R.S. date 9/22/08

Installed by: Hoyle Septic Tank

Operation Permit by: [signature] date 12-3-08

Existing System Inspection by: ____ date ____

HEALTH DEPT. COPY: WHITE OWNER COPY (FINAL): YELLOW OWNER COPY (INITIAL): PINK

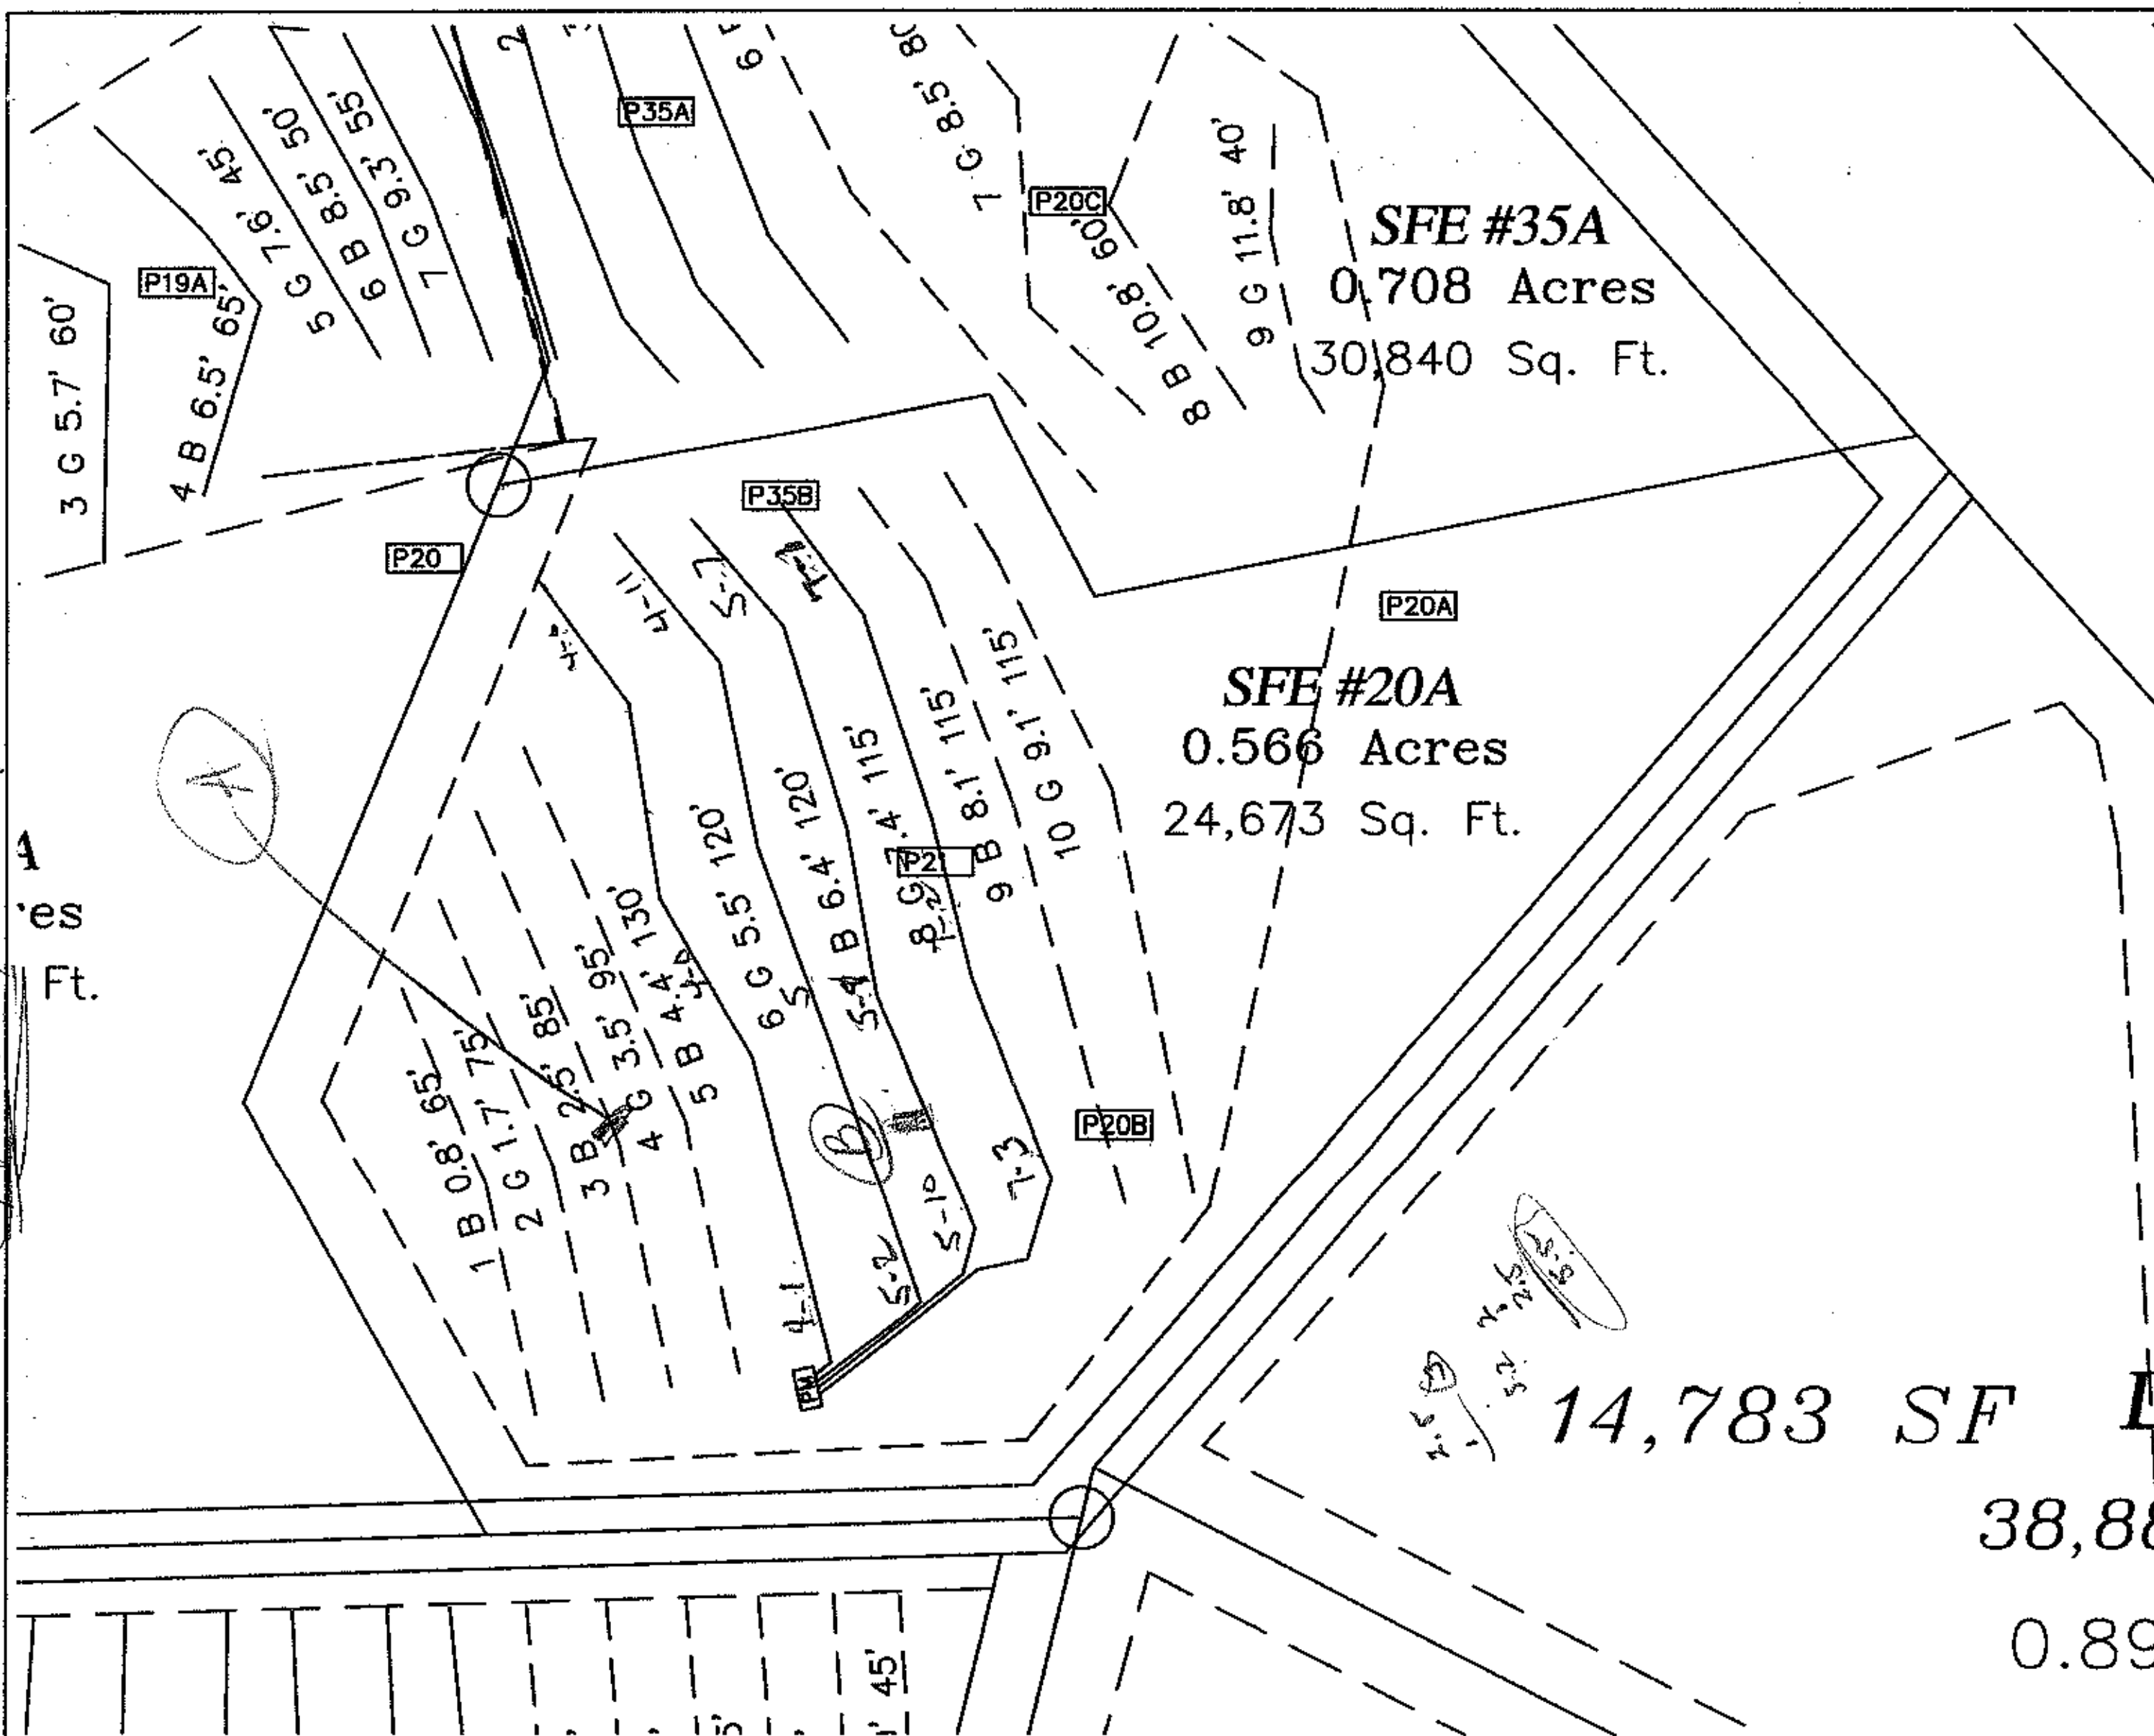

LEGEND

- Areas contain soils with 24 inches or more of useable material and have potential for conventional, modified conventional and low-pressure pipe (lpp) septic systems.
- Building Envelope (60' x 60')
- System lines.
- Repair lines.
- Temporary Bench Mark (TBM)
- Well Location.

GRAPHIC SCALE
1" = 40'

40 0 40 80

FOR PRELIMINARY PLANNING PURPOSES ONLY. ALL LOTS WILL REQUIRE FINAL APPROVAL BY THE COUNTY HEALTH DEPARTMENT ON A LOT BY LOT BASIS. THIS MAP SHOULD BY USED AS A GENERAL GUIDE, SOME ADJUSTMENTS WILL BE NECESSARY IN THE FIELD DUE TO SOIL VARIABILITY AND COMPLEX TOPOGRAPHIC FEATURES.
THIS MAP ONLY REFLECTS EXISTING SOIL SUITABILITY FOR ON-SITE SEPTIC TANK SYSTEMS.

PLEASE REFER TO ATTACHED SOIL REPORT FOR ADDITIONAL SITE SPECIFIC INFORMATION

ROLLANS SOIL & ENVIRONMENTAL SERVICES
2120 GRAHAM ROAD
MOUNT ULLA, NC 28125
PHONE/FAX: (704) 278-0989
ASHLEY ROLLANS, NC LICENSED SOIL SCIENTIST
MOBILE: (704) 746-5046
EMAIL: ROLLANSPORTCJ@AOL.COM

MAP TITLE:	SITE PLAN & DRAINFIELD AREAS
PROJECT NAME:	RIDGELINE DEVELOPMENT CORP. / ANNISTON PHASE II
LOCATION/DATE:	SHEARER CHAPEL ROAD, IREDELL COUNTY, NORTH CAROLINA, AUGUST 2005
JOB #:	01-1005
FILE:	C:\JOBS\01-1005
PROJECT MGR.:	S.A.R.
FIELD WORK:	S.A.R.
DRAWN BY:	S.A.R.