IREDELL COUNTY HEALTH DEPARTMENT

STATESVILLE 704-878-5305 MOORESVILLE 704-664-5281

IMPROVEMENT PERMIT / AUTHORIZATION TO CONSTRUCT / OPERATION PERMIT / EXISTING SYSTEM INSPECTION

PERMIT# 123279 PIN# ~~4664 61 05 75 673~~ 4664580113.000 DATE 3/3/05

OWNER OR CONTRACTOR RIDGELINE DEV. / EDWARDS CONST. PHONE: Business 753-5310 Home

ADDRESS 2419 HENRY BEACON RD

LOCATION SHEARERS RD - TL ANNESTON - 1ST ON RT

SUBDIVISION ANNESTON BLOCK / SECTION 1 LOT 12 LOT AREA .67AC SITE CLASS. PS DESIGN FLOW 450GPD L.T.A.R. - 3000 SF

Septic Tank: 1000 Gallons; STB 794 Date 8/29/05
Pump Tank: 1000 Gallons; PT 253 Date 8/29/05
Pump Make: Goulds Model WE ~~1512HH~~ Serial No. 10/05
Nitrification Field: No Fields 1 Square Feet 1200 Linear Feet 400
No Lines 4@100' Trench Width 36" Max Trench Bottom Depth 30" Gravel Depth

☑ New System ☐ Repair System Type: I, II, III, IV, V, VI
System Description: PUMP 20% REDUCTION OFFSITE
Repair System Description: LP PANEL OFFSITE
Maintenance Agreement Required: ☐ Yes ☑ No
☐ Slab ☑ Crawl Space ☑ Basement w/plumbing ☐ Basement wo/plumbing


☑ House/Mod. Home No. Bedrooms 4
☐ Mobile Home No. Bathrooms 4
☐ Business No. Employees
☐ Other

Water Supply: ☑ Individual ☐ Public ☐ Community


Comments:/Conditions:

Comments:/Conditions:

INITIAL SITE SKETCH

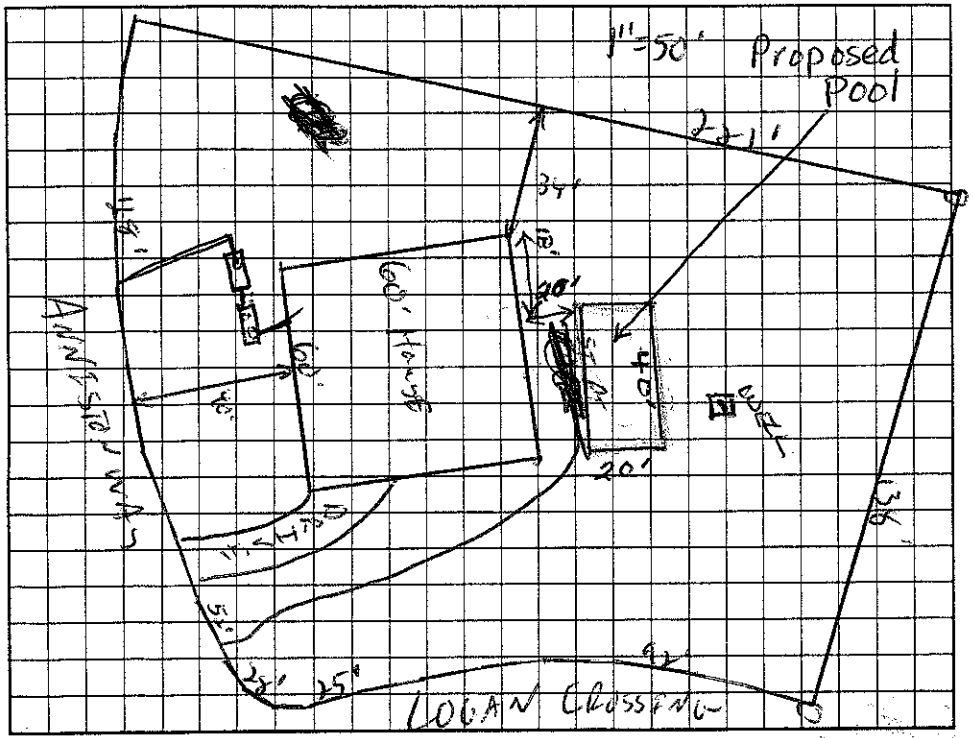

AS BUILT SKETCH 1"=60'

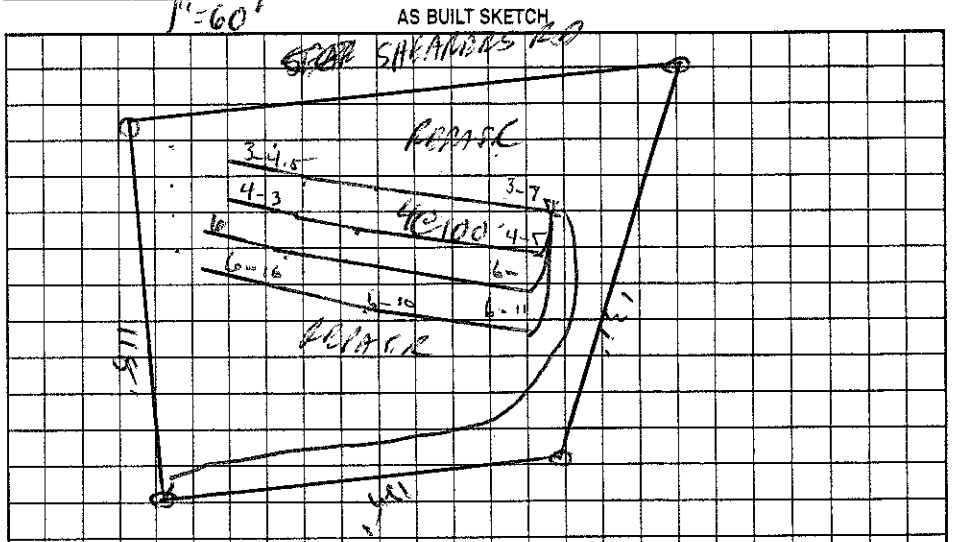

The proposed / existing Pool addition does not appear to impact the existing septic system.
**NOTE:

Judy Melville REHS
Date: 5-2-11
ICHD-Environmental Health Division

Permit can be suspended or revoked if any false information is supplied toward securing the permit/any unauthorized changes are made to the site/any unauthorized changes are made in the installation of the system. Improvement Permit with plat valid without expiration. Improvement Permit with site plan valid for sixty months. Authorization to Construct is valid for a period equal to that of Improvement Permit – not to exceed sixty months.

Signed: date 3/9/05
Improvement Permit by: RS date 3/3/05
Authorization to Construct by: RS date 3/3/05

Installed by: Marty Tucker
Operation Permit by: Wesley Sparks R.S. date 10/1/05
Existing System Inspection by: date

HEALTH DEPT. COPY: WHITE OWNER COPY (FINAL): YELLOW OWNER COPY (INITIAL): PINK