IREDELL COUNTY HEALTH DEPARTMENT

STATESVILLE 704-878-5305 MOORESVILLE 704-664-5281

IMPROVEMENT PERMIT / AUTHORIZATION TO CONSTRUCT / OPERATION PERMIT / EXISTING SYSTEM INSPECTION

PERMIT# 123263 PIN# 4664-67-0275.011 4664586195 DATE 4/19/05

OWNER OR CONTRACTOR RIDGELINE DEVELOPMENT PHONE: Business 362-5007 Home

ADDRESS 17105 KEATON DR. SUITE 207-C CORNELIUS NC 28031

LOCATION SHEARERS - TL ANNISTON - LOT ON RT - SEPTIC ON LT

SUBDIVISION ANNISTON BLOCK / SECTION 1 LOT 11 LOT AREA 1.67AC SITE CLASS. PS DESIGN FLOW 480GPD L.T.A.R. .30 EXI

Septic Tank: 1060 Gallons; STB 794 Date 3/3/06

Pump Tank: 1000 Gallons; PT 27 Date 9/30/05

Pump Make: GOULDS Model WE0-1012H Serial No. 4/06

Nitrification Field: No Fields 1 Square Feet 1200 Linear Feet 400

No Lines 4@100' Trench Width 36" Max Trench Bottom Depth 32" Gravel Depth N/A

☑ New System ☐ Repair System Type: I, II, III, IV, V, VI

System Description: PUMP 25% REDUCTION OFFSITE

Repair System Description: LP PANEL OFFSITE

Maintenance Agreement Required: ☐ Yes ☑ No

☑ House/Mod. Home No. Bedrooms 4

☐ Mobile Home No. Bathrooms 4

☐ Business No. Employees

☐ Other


☐ Slab ☐ Crawl Space ☑ Basement w/plumbing ☐ Basement wo/plumbing

Water Supply: ☑ Individual ☐ Public ☐ Community


Comments:/Conditions:

Comments:/Conditions:

INITIAL SITE SKETCH

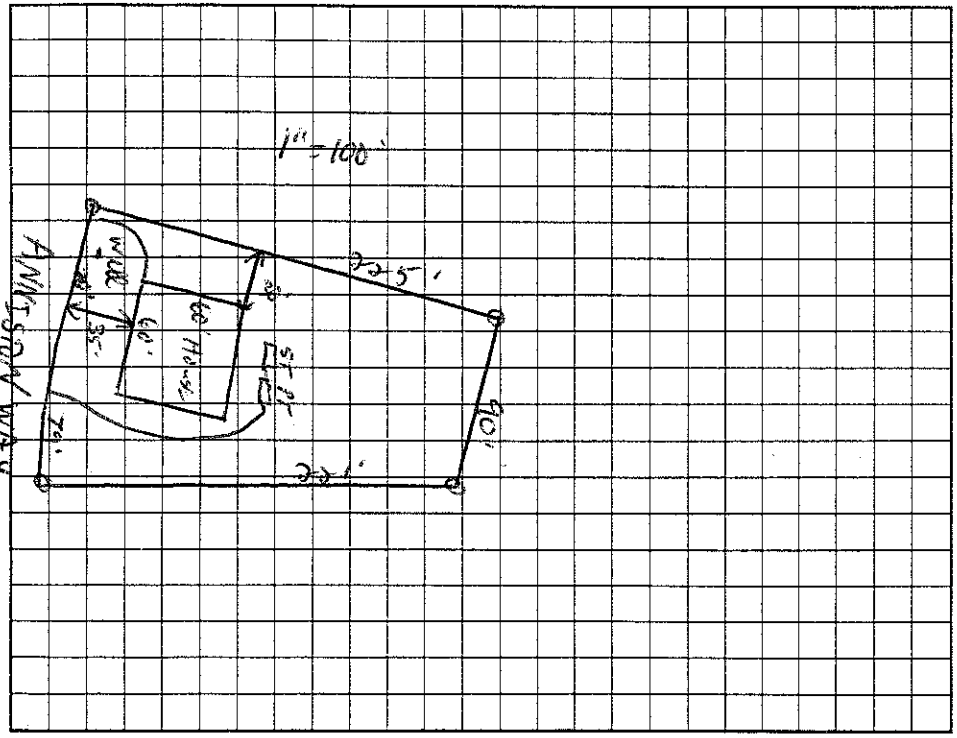

AS BUILT SKETCH

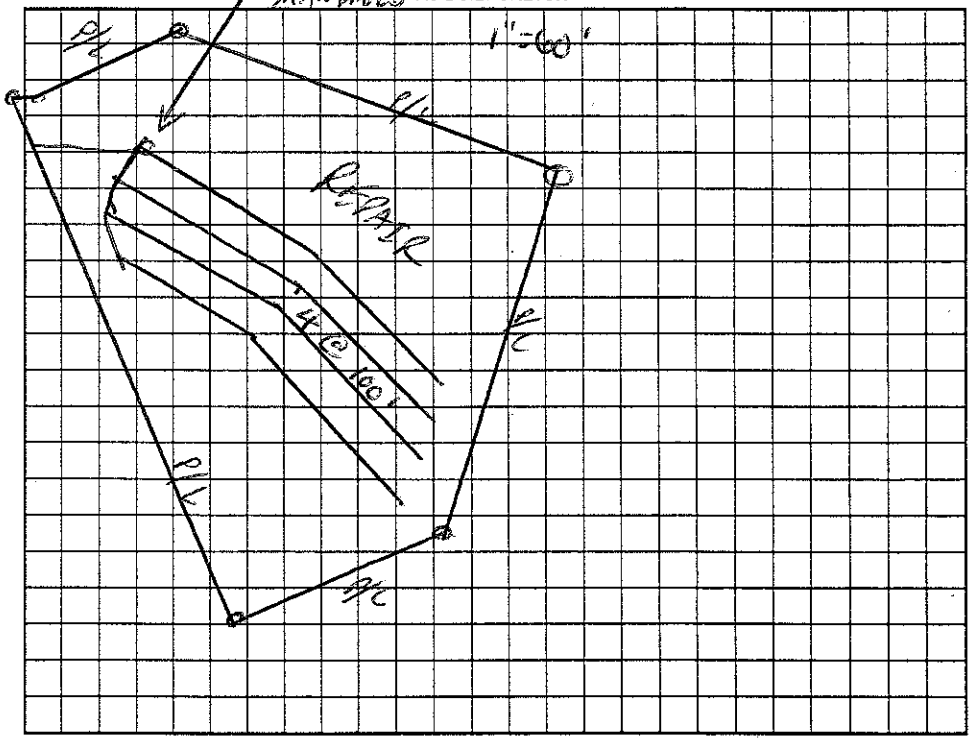

Permit can be suspended or revoked if any false information is supplied toward securing the permit/any unauthorized changes are made to the site/any unauthorized changes are made in the installation of the system. Improvement Permit with plat valid without expiration. Improvement Permit with site plan valid for sixty months. Authorization to Construct is valid for a period equal to that of Improvement Permit – not to exceed sixty months.

Signed: [signature] date 5-17-05

Improvement Permit by: C. [signature] RS date 4/19/05

Authorization to Construct by: Wesley Sparks RS. date 9/28/05

Installed by: Marty Tucker

Operation Permit by: Wesley Sparks RS. date 5/24/06

Existing System Inspection by: date

HEALTH DEPT. COPY: WHITE OWNER COPY (FINAL): YELLOW OWNER COPY (INITIAL): PINK