IREDELL COUNTY HEALTH DEPARTMENT

STATESVILLE 704-878-5305 MOORESVILLE 704-664-5281

IMPROVEMENT PERMIT / AUTHORIZATION TO CONSTRUCT / OPERATION PERMIT / EXISTING SYSTEM INSPECTION

PERMIT# 12326 PIN# 4664-67-0270.010 4664-58-2140 DATE 4/14/05

OWNER OR CONTRACTOR RIDGELINE DEVELOPMENT PHONE: Business 362-5207 Home

ADDRESS 17105 KEATON DR. SUITE 207-C CORNELIUS NC 28031

LOCATION STEARNS RD - TL ANNESTON - LOT ON RT - SEPTIC ON LEFT

SUBDIVISION ANNISTON BLOCK / SECTION 1 LOT 10 LOT AREA .64C SITE CLASS. PS DESIGN FLOW 480 L.T.A.R. N, 25 br0/Ac

Septic Tank: 1000 Gallons; STB 277 Date 12-4-06

Pump Tank: 1000 Gallons; PT 381 Date 12-16-06

Pump Make: Model Serial No.

Nitrification Field: No Fields 1 Square Feet 640 Linear Feet 345

No Lines 3 Trench Width 24" Max Trench Bottom Depth 30" Gravel Depth N/A

☑ New System ☐ Repair System Type: I, II, III, (IV), V, VI

System Description: CHAMBER OFFSITE

Repair System Description: SAME

Maintenance Agreement Required: ☑ Yes ☐ No

☐ House/Mod. Home No. Bedrooms 4

☐ Mobile Home No. Bathrooms 4

☐ Business No. Employees

☐ Other

☐ Slab ☐ Crawl Space ☐ Basement w/plumbing ☐ Basement wo/plumbing


Water Supply: ☑ Individual ☐ Public ☐ Community

Comments:/Conditions:

Comments:/Conditions:

On 1/29/07 - Marty Tucker called H.D about water in top drain line - David Hinson and Joe Alexander met on site and altered the layout to ammend problem by staying out of low area

INITIAL SITE SKETCH

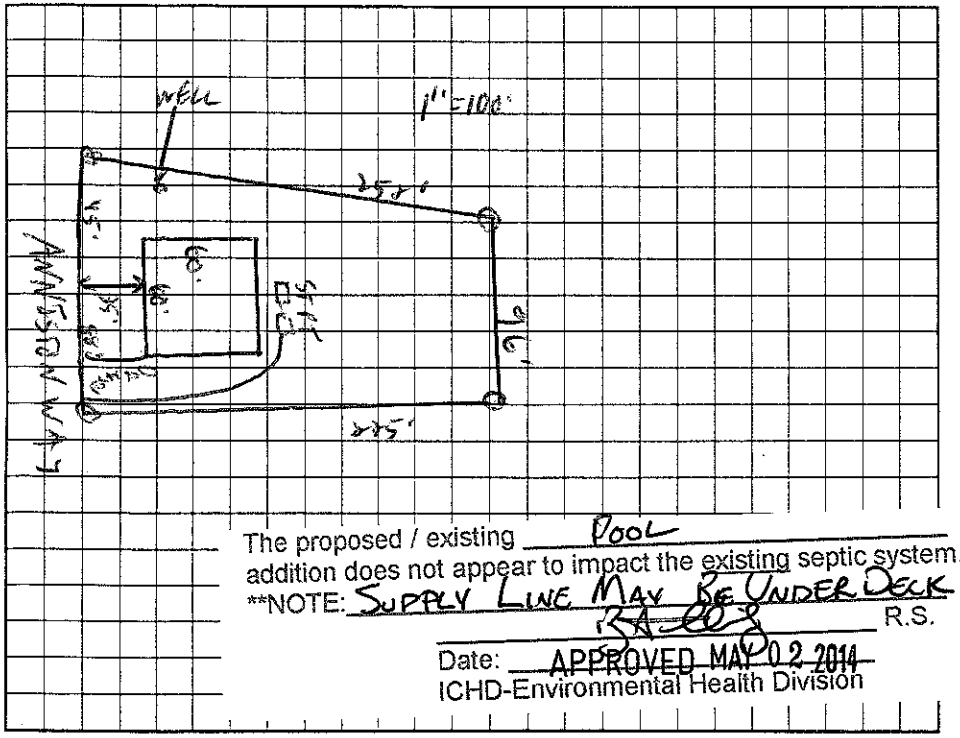

The proposed / existing POOL addition does not appear to impact the existing septic system.


**NOTE: SUPPLY LINE MAY BE UNDER DECK

R.S.

Date: APPROVED MAY 02 2014

ICHD-Environmental Health Division

AS BUILT SKETCH

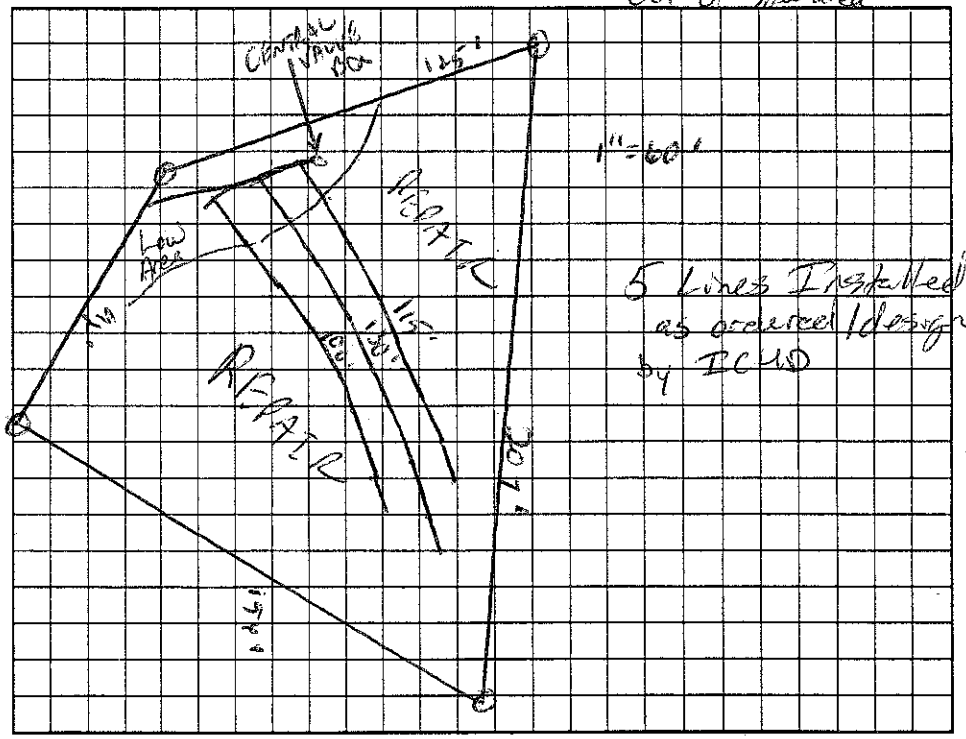

Permit can be suspended or revoked if any false information is supplied toward securing the permit/any unauthorized changes are made to the site/any unauthorized changes are made in the installation of the system. Improvement Permit with plat valid without expiration. Improvement Permit with site plan valid for sixty months. Authorization to Construct is valid for a period equal to that of Improvement Permit – not to exceed sixty months.

Signed: [signature] date 5-17-05

Improvement Permit by: [signature] RS date 4/14/05

Authorization to Construct by: [signature] RS date 2/9/06

Installed by: Marty Tucker Grading

Operation Permit by: [signature] date 2/8/07

Existing System Inspection by: date

HEALTH DEPT. COPY: WHITE OWNER COPY (FINAL): YELLOW OWNER COPY (INITIAL): PINK