IREDELL COUNTY HEALTH DEPARTMENT

STATESVILLE 704-878-5305 MOORESVILLE 704-664-5281

IMPROVEMENT PERMIT / CERTIFICATE OF COMPLETION / OPERATION PERMIT / EXISTING SYSTEM INSPECTION

PROPERTY DESCRIPTION NO. 17175 DATE 10/14/93 TAX MAP NO. 1B-2-A-27

OWNER OR CONTRACTOR PAUL W NANCE PHONE: Business 393-1774 Home

ADDRESS 4725 TANGLEBRIAR DR. CHAR. NC.

LOCATION SHEARERS RD. TL 1SE BELLEGLADE VISTADR. PW# 4664-58-3972

SUBDIVISION BELLEGLADE BLOCK / SECTION LOT 27 LOT AREA .54 SITE CLASS. P L.T.A.R. .25-.3

Water Supply: ☑ Individual ☐ Community ☐ Public

Septic Tank: 1000 Gallons; STB 794 Date 4/10/94

Pump Tank: Gallons; PT Date

Nitrification Field: No Fields 1 Square Feet 1200 Linear Feet 400

No Lines 4 Trench Width 3' Trench Depth 3' Gravel Depth 12"

☑ New System ☐ Repair System Type: I, ☑ II, IV, V, VI

System Description: CONV - DROP BOX

Repair System Description: PANEL

Maintenance Agreement Required: ☐ Yes ☑ No

☑ House/Mod. Home No. Bedrooms 3 Garbage Disposal: ☐ Yes ☑ No

☐ Mobile Home No. Bathrooms 2 Auto. Dishwasher: ☑ Yes ☐ No


☐ Business No. Employees Auto. Washing Machine: ☑ Yes ☐ No

☐ Other Other

☐ Slab ☑ Crawl Space ☐ Basement w/plumbing ☐ Basement wo/plumbing

Comments TIGHT - VERY LITTLE ROOM FOR VARIANCE
LINES TO START 24" DEEP AND FINISH NO DEEPER THAN 36"

INITIAL SITE SKETCH

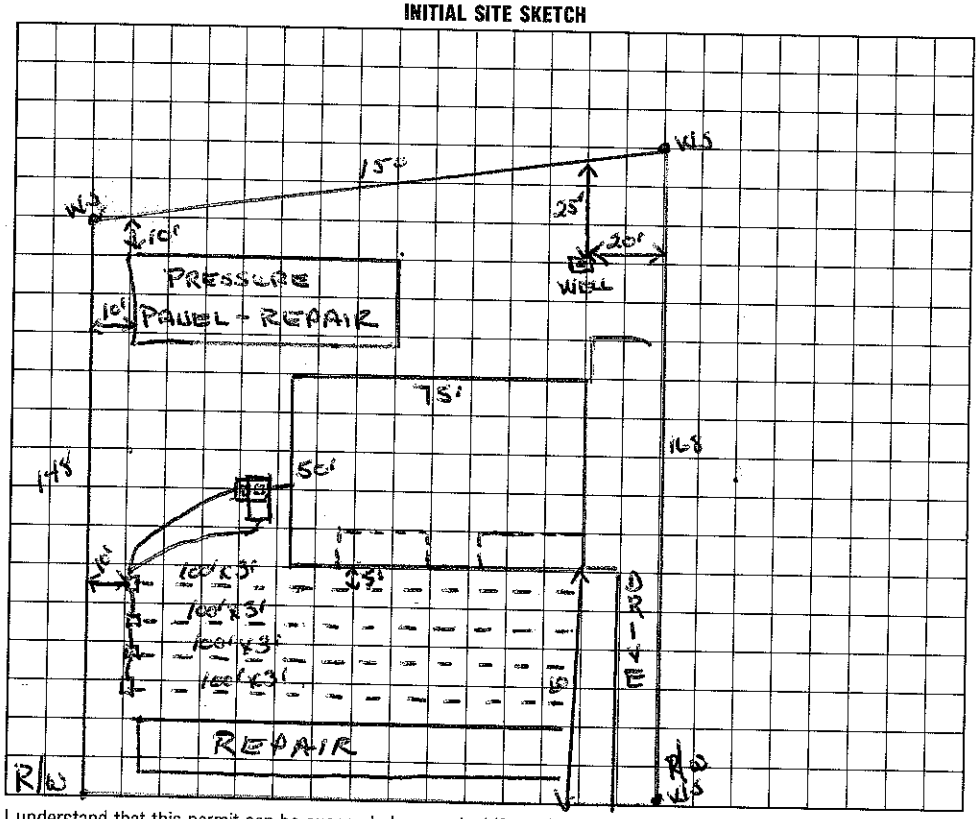

AS BUILT SKETCH

Installed as drawn.

I understand that this permit can be suspended or revoked if any false information is supplied toward securing the permit/any unauthorized changes are made to the site/any unauthorized changes are made in the installation of the system. Improvement Permit is valid for 60 months from date of issuance.

Signed: x Paul W Nance

Improvement Permit by: Wesley Sparks RS. date 10/14/93

Existing System Inspection by: date

Installed by: Norman Roach - Mecklenburg.

Certificate of Completion by: Wesley Sparks RS. 8 date 5/31/94

Operation Permit by: date

HEALTH DEPT. COPY: WHITE INSPECTION COPY (FINAL): GREEN OWNER COPY (FINAL): YELLOW INSPECTION COPY (INITIAL): PINK OWNER COPY (INITIAL): GOLD