IREDELL COUNTY HEALTH DEPARTMENT

STATESVILLE 704-878-5305 $ 20 MOORESVILLE 704-664-5281

IMPROVEMENT PERMIT / AUTHORIZATION TO CONSTRUCT / OPERATION PERMIT / EXISTING SYSTEM INSPECTION

PERMIT# 104774 PIN# 4664 58 4480 DATE 6/18/02

OWNER OR CONTRACTOR Nolan Lee Barnhardt PHONE: Business 363-8428 Home

ADDRESS 140 Villa Lane Mooresville, NC. Davidson, NC 28036

LOCATION Shearers Rd. TL Villa Lane to 8th lot on (R)

SUBDIVISION Belle Glade BLOCK / SECTION LOT 8 LOT AREA .70 SITE CLASS. PS DESIGN FLOW 360 L.T.A.R. .3

Septic Tank: EXISTING Gallons: STB Date

Pump Tank: Gallons; PT Date

Pump Make: Model Serial No.

Nitrification Field: No Fields Square Feet 405 Linear Feet 135

No Lines 1 Trench Width 3' Max Trench Bottom Depth 3' Gravel Depth 12"

[X] New System [ ] Repair System Type: I, (II), III, IV, V, VI

System Description: Add 1 line to lower trenchfield

Repair System Description:

Maintenance Agreement Required: [ ] Yes [X] No

[X] House/Mod. Home No. Bedrooms 3

[ ] Mobile Home No. Bathrooms 2

[ ] Business No. Employees

[ ] Other

[ ] Slab [X] Crawl Space [ ] Basement w/plumbing [ ] Basement wo/plumbing


Water Supply: [X] Individual [ ] Public [ ] Community

Comments:/Conditions: Cut top line off D Box - Install replacement line 9" below lowest trainline

Comments:/Conditions:

1" = 50'

INITIAL SITE SKETCH

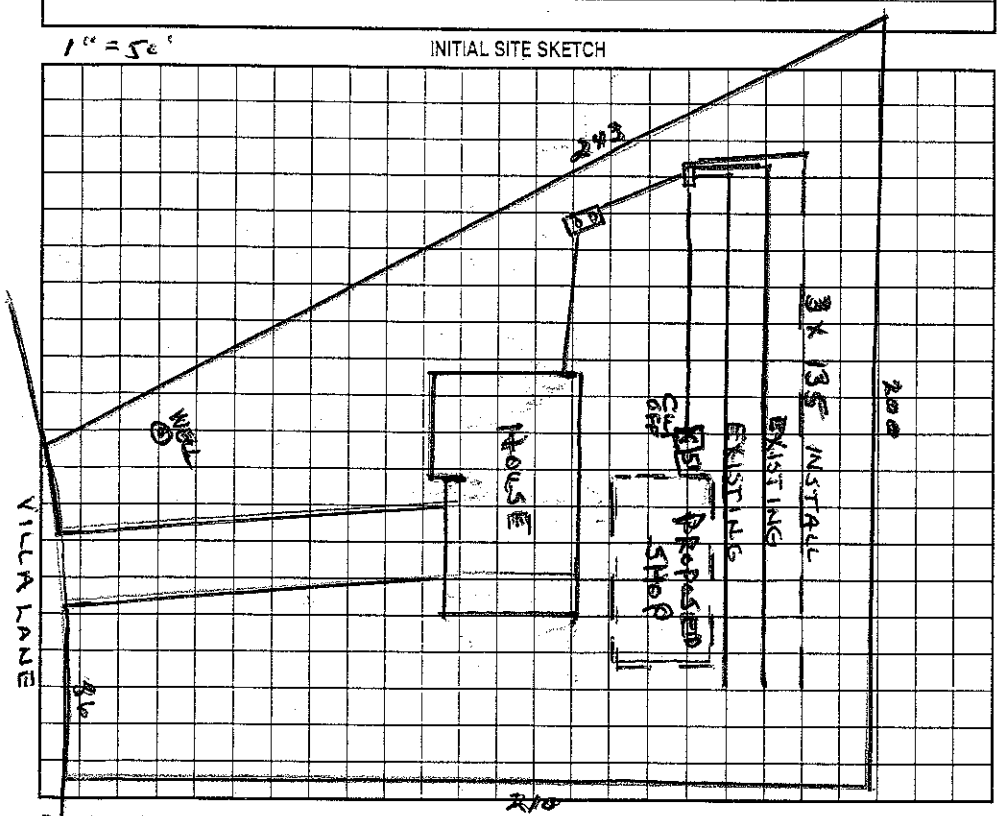

AS BUILT SKETCH

Permit can be suspended or revoked if any false information is supplied toward securing the permit/any unauthorized changes are made to the site/any unauthorized changes are made in the installation of the system. Improvement Permit with plat valid without expiration. Improvement Permit with site plan valid for sixty months. Authorization to Construct is valid for a period equal to that of Improvement Permit – not to exceed sixty months.

Signed: * Johnny D Bowen date

Improvement Permit by: Wesley Sparks RS. date 6/18/02

Authorization to Construct by: Wesley Sparks RS date 6/18/02

Installed by: Derek Tincher

Operation Permit by: Wesley Sparks RS date 6/26/02

Existing System Inspection by: date

HEALTH DEPT. COPY: WHITE OWNER COPY (FINAL): YELLOW OWNER COPY (INITIAL): PINK