4.00

IREDELL COUNTY HEALTH DEPARTMENT

STATESVILLE 704-878-5305 MOORESVILLE 704-664-5281

IMPROVEMENT PERMIT / AUTHORIZATION TO CONSTRUCT / OPERATION PERMIT / EXISTING SYSTEM INSPECTION

PERMIT# 134899 PIN# 4664584698

OWNER OR APPLICANT D.A. Johnson Construction DATE 4-27-06

ADDRESS PO Box 1065 Huntersville 28070 PHONE: Business 704-400-5066 Home

LOCATION Sheavers Rd TL Villa Ln on left at corner of Vista Dr

SUBDIVISION Belle Glade BLOCK / SECTION LOT 29 LOT AREA .636 Ac SITE CLASS. PS DESIGN FLOW 360gpd L.T.A.R. .3 gpd/ft²

Septic Tank: 1000 Gallons: STB 102 Date 2-6-06

Pump Tank: Gallons: PT Date

Pump Make: Model Serial No.

Nitrification Field: No Fields Square Feet Linear Feet

No Lines 4@75' Trench Width 36" Max Trench Bottom Depth 36" Gravel Depth NA

☒ New System ☐ Repair ☐ Expansion System Type: I II III IV V VI

System Description: 25% reduction gravity

Repair System Description: 25% reduction pump

Maintenance Agreement Required: ☐ Yes ☒ No

☒ House/Mod. Home ☐ Mobile Home ☐ Business ☐ Other

No. Bedrooms 3 No. Persons No. Employees

Water Supply: ☒ Individual ☐ Public ☐ Community

☒ Gravity ☐ Pressure ☒ Slab ☒ Crawl Space ☐ Basement w/plumbing ☐ Basement wo/plumbing


Comments/Conditions:

D-Box w/ Equalizers or speed levelers
Well must be 50'+ from septic tank & system

Comments:/Conditions:

Septic tank w/ marker
yellow ~~polylok~~ filter
infiltrator

INITIAL SITE SKETCH

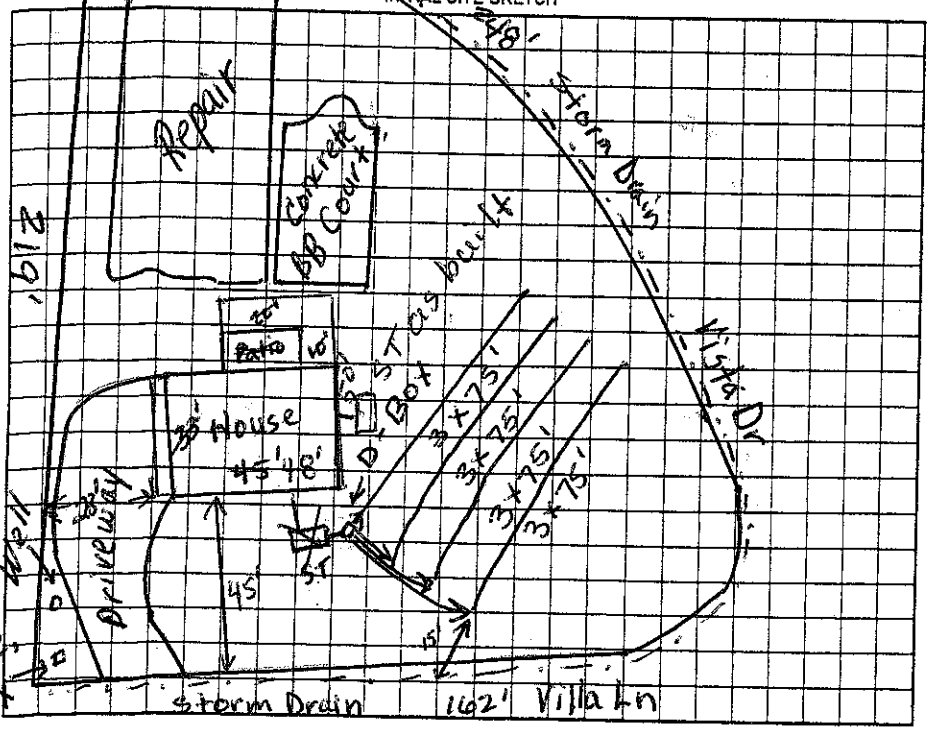

AS BUILT SKETCH

Quick 4 Std. infiltrator installed as per initial site sketch except tank on side of house as indicated

Permit can be suspended or revoked if any false information is supplied toward securing the permit/any unauthorized changes are made to the site/any unauthorized changes are made in the installation of the system. Improvement Permit with plat valid without expiration ☐ Improvement Permit with site plan valid for sixty months ☒ Authorization to Construct is valid for a period equal to that of Improvement Permit – not to exceed sixty months.

Signed: date 5-18-06 Installed by: A-1 Backhoe

Improvement Permit by: Judy Melvin date 4-27-06 Operation Permit by: Judy Melvin date 8-29-06

Authorization to Construct by: Judy Melvin date 5-25-06 Existing System Inspection by: date

HEALTH DEPT. COPY: WHITE OWNER COPY (FINAL): YELLOW OWNER COPY (INITIAL): PINK