IREDELL COUNTY HEALTH DEPARTMENT

STATESVILLE 704-878-5305 ✓ MOORESVILLE 704-664-5281

IMPROVEMENT PERMIT / CERTIFICATE OF COMPLETION / OPERATION PERMIT / EXISTING SYSTEM INSPECTION

PROPERTY DESCRIPTION NO. 14506 DATE 5/24/94 TAX MAP NO. 13-2 / 4664-58-6899 Watershed: ☑ Yes ☐ No

OWNER OR CONTRACTOR Les Backer PHONE: Business _____ Home 704-568-7057

ADDRESS Vista Dr. Mooresville, NC. 28115

LOCATION Sloans Chapel Rd, TL on Vista Dr. (1st Belle Glade) to 6th lot on L

SUBDIVISION Belle Glade BLOCK / SECTION _____ LOT 15 LOT AREA 1.11 AC SITE CLASS. P DESIGN FLOW 360 L.T.A.R. .3-.35

Septic Tank: 1000 Gallons; STB 825 Date 4/14/94

Pump Tank: _____ Gallons; PT _____ Date _____

Pump Make: _____ Model _____ Serial No. _____

Nitrification Field; No Fields 1 Square Feet 1200 Linear Feet 400

No Lines 4 Trench Width 36" Max Trench Bottom Depth 36" Gravel Depth 12"

☑ New System ☐ Repair System Type: I (1) III, IV, V, VI

System Description: DROP BOX - CONVENTIONAL

Repair System Description: _____

Maintenance Agreement Required: ☐ Yes ☐ No

☐ House/Mod. Home No. Bedrooms ____

☐ Mobile Home No. Bathrooms ____

☐ Business No. Employees ____

☐ Other _____

☐ Slab ☐ Crawl Space ☐ Basement w/plumbing ☐ Basement wo/plumbing

Water Supply: ☐ Individual ☐ Community ☐ Public

Comments:


Comments:

ENTERED

Originally installed 1992 for Les Backer

INITIAL SITE SKETCH

AS BUILT SKETCH

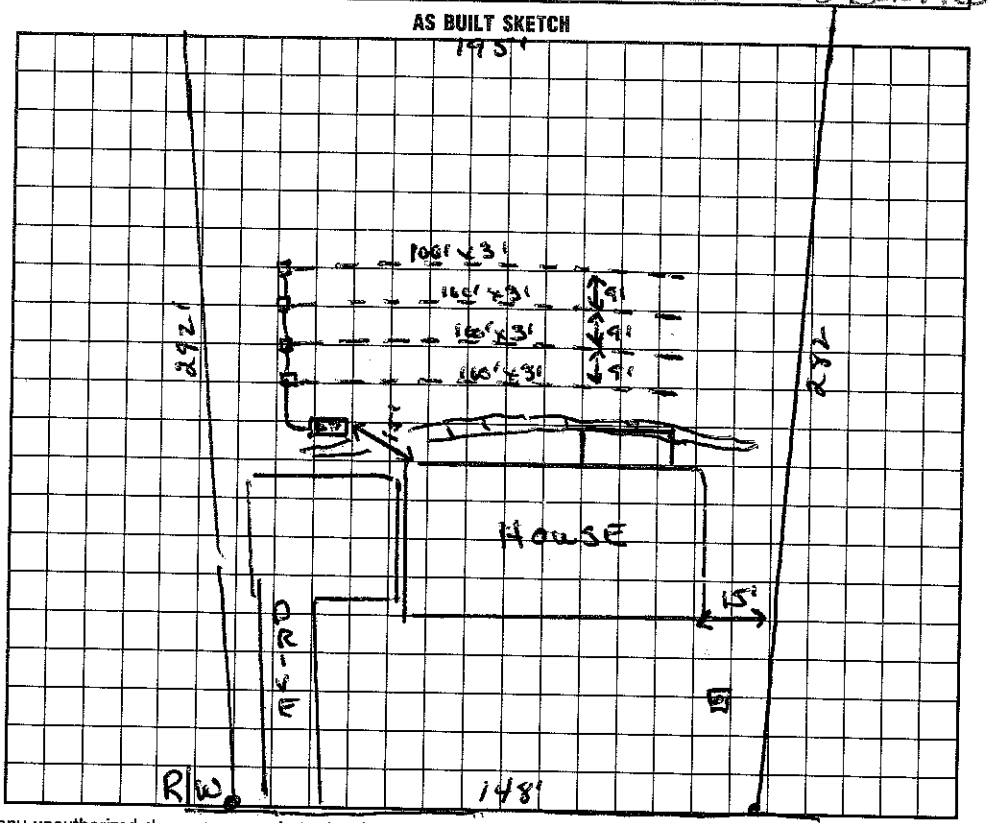

I understand that this permit can be suspended or revoked if any false information is supplied toward securing the permit/any unauthorized changes are made to the site/any unauthorized changes are made in the installation of the system. Improvement Permit is valid for 60 months from date of issuance.

Signed: _____

Improvement Permit by: _____ date _____

Existing System Inspection by: _____ date _____

Installed by: Rowan Septic Tank VISTA DR.

Certificate of Completion by: Wesley Sparks R.S. date 5/24/94

Operation Permit by: _____ date _____

HEALTH DEPT. COPY: WHITE INSPECTION COPY (FINAL): GREEN OWNER COPY (FINAL): YELLOW INSPECTION COPY (INITIAL): PINK OWNER COPY (INITIAL): GOLD