IREDELL COUNTY HEALTH DEPARTMENT

PIN # 4664-58-7325

STATESVILLE 704-878-5305 MOORESVILLE 704-664-5281

IMPROVEMENT PERMIT / CERTIFICATE OF COMPLETION / OPERATION PERMIT / EXISTING SYSTEM INSPECTION

PROPERTY DESCRIPTION NO. 17747 DATE 2/7/94 TAX MAP NO. 1B 2A Watershed: ☑ Yes ☐ No

OWNER OR CONTRACTOR NEVIL WELLS PHONE: Business _____ Home 892-3021

ADDRESS 21113 277 FRONTAGE RD. DAVIDSON, NC. 28036

LOCATION SHEARERS RD. TL VILLA LN, TO LAST 2 LOTS ON (R)

SUBDIVISION BELLE GLADE BLOCK / SECTION _____ LOT 10+11 LOT AREA ~1.11AC SITE CLASS. P. DESIGN FLOW 360 L.T.A.R. .2-.25

Septic Tank: 1000 Gallons; STB 825 Date 7/13/94

Pump Tank: _____ Gallons; PT _____ Date _____

Pump Make: _____ Model _____ Serial No. _____

Nitrification Field: No Fields 1 Square Feet 1440 Linear Feet (45'-48')

No Lines 8 4 Trench Width 3 Max Trench Bottom Depth 36" Gravel Depth 12"

☑ New System ☐ Repair System Type: I, (II), III, IV, V, VI

System Description: DROP BOX - CONV.

Repair System Description: SAME

Maintenance Agreement Required: ☐ Yes ☐ No

☐ House/Mod. Home No. Bedrooms 3

☐ Mobile Home No. Bathrooms 2.5

☐ Business No. Employees _____

☐ Other _____


☐ Slab ☑ Crawl Space ☐ Basement w/plumbing ☐ Basement wo/plumbing

Water Supply: ☑ Individual ☐ Community ☐ Public

Comments: WELL LOCATED NO CLOSER THAN 50' TO ANY PART OF SEPTIC TANK SYSTEM.


INITIAL SITE SKETCH

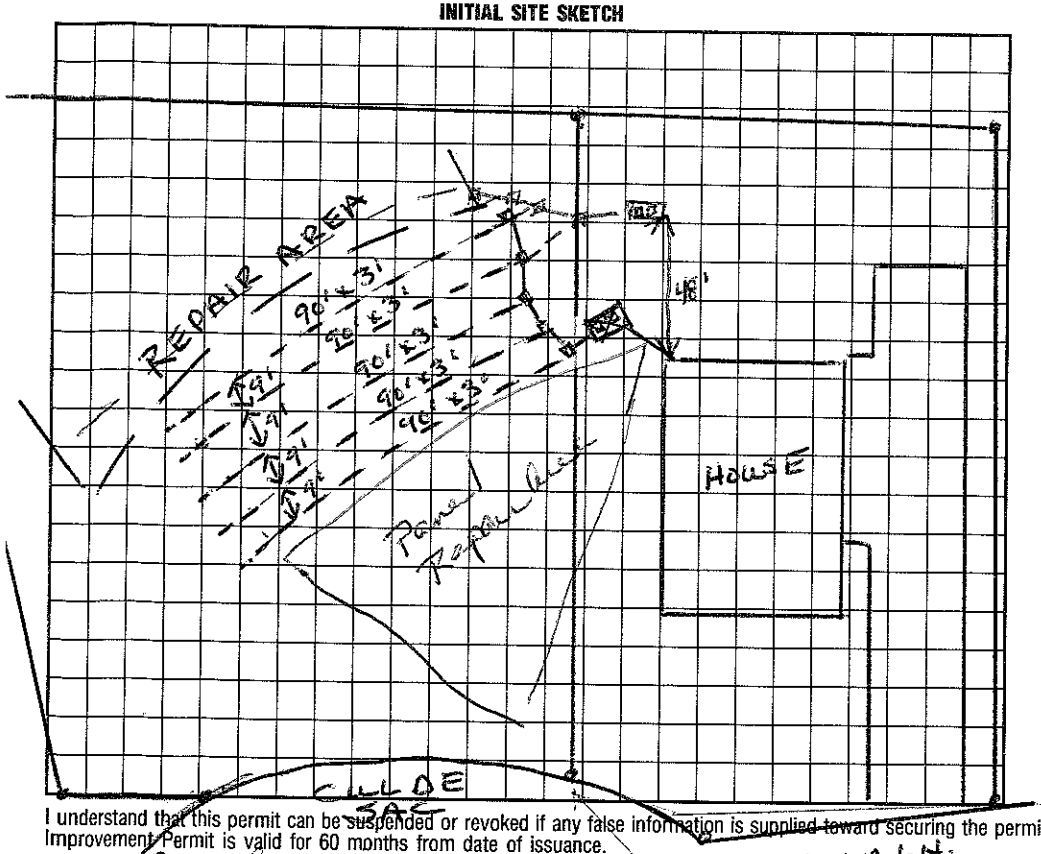

AS BUILT SKETCH

I understand that this permit can be suspended or revoked if any false information is supplied toward securing the permit/any unauthorized changes are made to the site/any unauthorized changes are made in the installation of the system. Improvement Permit is valid for 60 months from date of issuance.

Signed: Susan Crowe

Improvement Permit by: Wesley Sparks R.S. date 2/9/94

Existing System Inspection by: _____ date _____

Installed by: Foster Pool Co.

Certificate of Completion by: Wesley Sparks R.S. date 12/21/94

Operation Permit by: _____ date _____

HEALTH DEPT. COPY: WHITE INSPECTION COPY (FINAL): GREEN OWNER COPY (FINAL): YELLOW INSPECTION COPY (INITIAL): PINK OWNER COPY (INITIAL): GOLD