IREDELL COUNTY HEALTH DEPARTMENT

STATESVILLE 704-878-5305 ✓ (2130) MOORESVILLE 704-664-5281

IMPROVEMENT PERMIT / CERTIFICATE OF COMPLETION / OPERATION PERMIT / EXISTING SYSTEM INSPECTION

PROPERTY DESCRIPTION NO. 066482 DATE 5/29/97 TAX MAP NO. 4664587732 Watershed: ☐ Yes ☐ N

OWNER OR CONTRACTOR David Heinz PHONE: Business 663-0322 Home 663-0181

ADDRESS 136 Ervin Rd

LOCATION Hwy 115 S. to Presbyterian Rd. TL proceed to Belle Glade subdivision 2nd lot from cul-de-sac (Vista D)

SUBDIVISION Belle Glade BLOCK / SECTION ____ LOT 14 LOT AREA .97 Acre SITE CLASS. PS DESIGN FLOW 360 gpd L.T.A.R. .3

Septic Tank: 1000 Gallons; STB 794 Date 10/30/97
Pump Tank: ____ Gallons; PT 29 Date 12/16/97
Pump Make: ____ Model ____ Serial No. ____
Nitrification Field: No Fields 1 Square Feet 400 Linear Feet 200'
No Lines 3' Trench Width 24" Max Trench Bottom Depth 30" Gravel Depth N/A

☒ New System ☐ Repair System Type: I, II, III, IV, V, VI
System Description: Pump to Panel Blk.
Repair System Description: Pump to Panel Blk
Maintenance Agreement Required: ☐ Yes ☒ No

☒ House/Mod. Home No. Bedrooms 3
☐ Mobile Home No. Bathrooms 2.5
☐ Business No. Employees ____
☐ Other ____
☐ Slab ☐ Crawl Space ☒ Basement w/plumbing ☐ Basement wo/plumbing

Water Supply: ☒ Individual ☐ Community ☐ Public


Comments: Must keep Septic Systems at least 50' from wells & 25' Setback for Basement

Scale = 1:60

Comments: (LINES, PRESSURE, TANKS CHECKED)

ENTERED

INITIAL SITE SKETCH

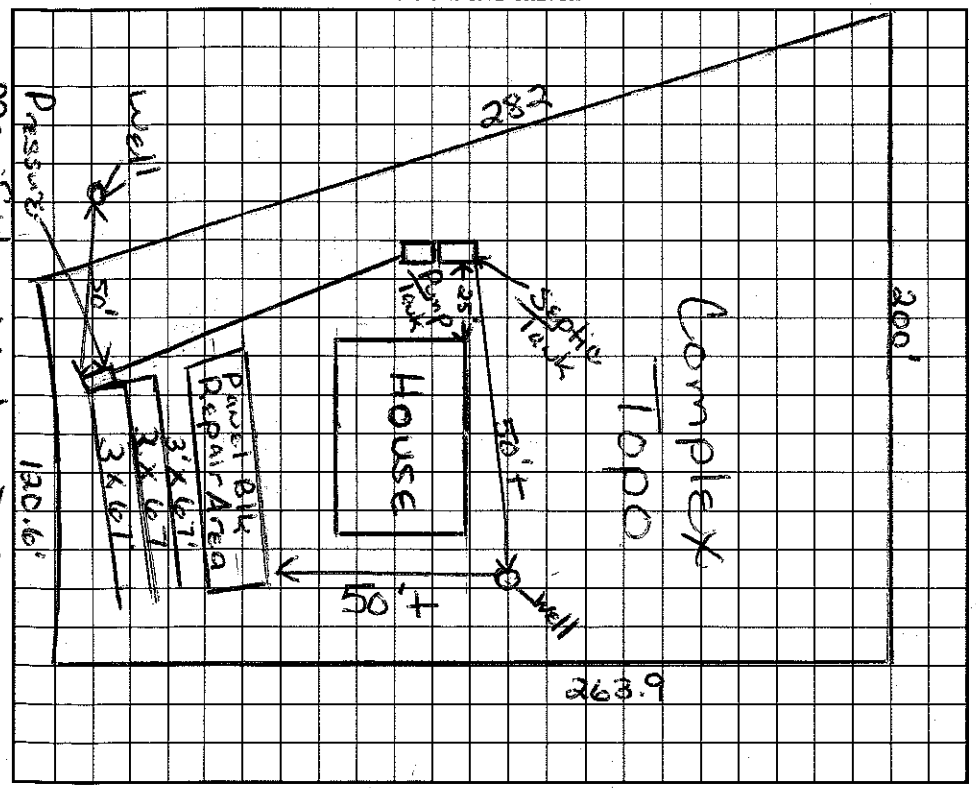

AS BUILT SKETCH

I understand that this permit can be suspended or revoked if any false information is supplied toward securing the permit/any unauthorized changes are made to the site/any unauthorized changes are made in the installation of the system. Improvement Permit is valid for 60 months from date of issuance.

Signed: ____

Installed by: LARRY BEAM

Improvement Permit by: Maria H.H. Dotson date 5/29/97
Auth to Construct

~~Existing System~~ Inspection by: Maria H.H. Dotson date 5/29/97

Certificate of Completion by: ____ date ____

Operation Permit by: ____ date 7/6/98

HEALTH DEPT. COPY: WHITE INSPECTION COPY (FINAL): GREEN OWNER COPY (FINAL): YELLOW INSPECTION COPY (INITIAL): PINK OWNER COPY (INITIAL): GOLD