IREDELL COUNTY HEALTH DEPARTMENT

STATESVILLE 704-878-5305 MOORESVILLE 704-664-5281

IMPROVEMENT PERMIT / CERTIFICATE OF COMPLETION / OPERATION PERMIT / EXISTING SYSTEM INSPECTION

PROPERTY DESCRIPTION NO. 18224 DATE 4/19/94 TAX MAP NO. 1B-2-A-12/4664-58-9444 Watershed: ☐ Yes ☒ No

OWNER OR CONTRACTOR Robert S. Luckey PHONE: Business _____ Home 664-9006

ADDRESS 738 Edgemoor Mooresville, NC. 28115

LOCATION Sheeus Rd, TL 2nd entrance, to cul de sac, Lot straight ahead

SUBDIVISION Bella Glade BLOCK / SECTION _____ LOT 12 LOT AREA ~ 1.03 Ac SITE CLASS. P DESIGN FLOW 360 L.T.A.R. .25

Septic Tank: 1000 Gallons; STB 794 Date 7/20/94
Pump Tank: _____ Gallons; PT _____ Date _____
Pump Make: _____ Model _____ Serial No. _____
Nitrification Field: No Fields 1 Square Feet 1440 Linear Feet 480
No Lines 4 Trench Width 3' Max Trench Bottom Depth 28-30" Gravel Depth 12"

☒ New System ☐ Repair System Type: I, (II), III, IV, V, VI
System Description: CONV - DROP BOX
Repair System Description: _____
Maintenance Agreement Required: ☐ Yes ☐ No


☒ House/Mod. Home No. Bedrooms 3
☐ Mobile Home No. Bathrooms 3
☐ Business No. Employees _____
☐ Other _____
☐ Slab ☐ Crawl Space ☒ Basement w/plumbing ☐ Basement wo/plumbing

Water Supply:
☒ Individual
☐ Community
☐ Public

Comments: Trench depth no greater than 30" - Lines on slope contour in direction shown.

Comments: Installed as shown.

INITIAL SITE SKETCH

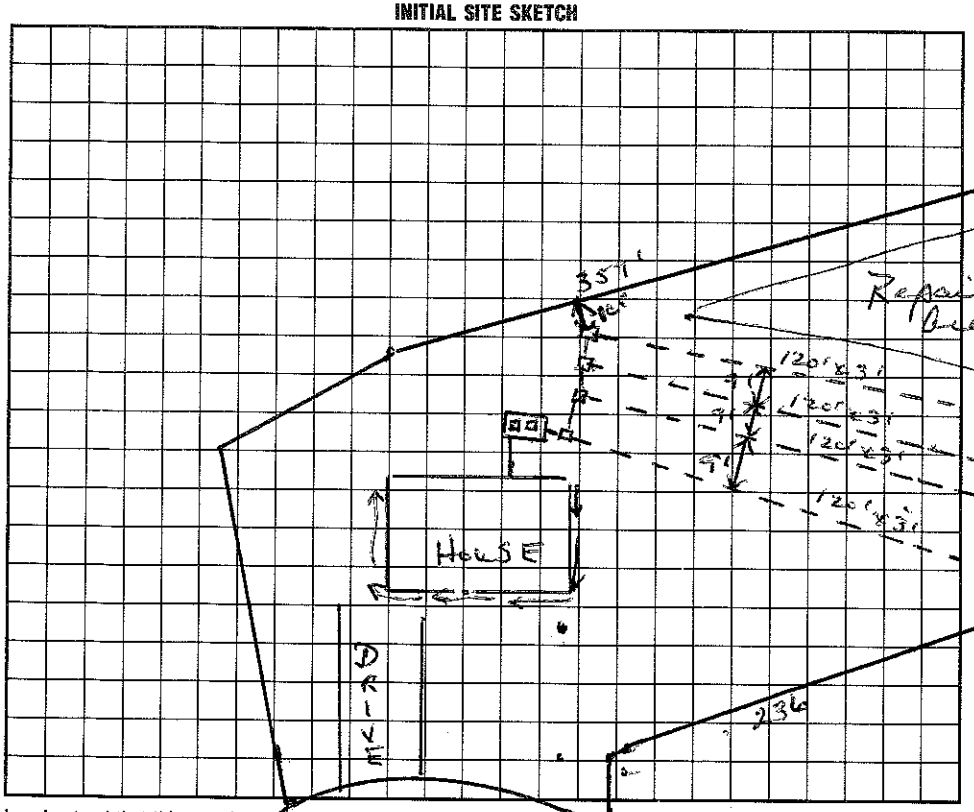

AS BUILT SKETCH

I understand that this permit can be suspended or revoked if any false information is supplied toward securing the permit/any unauthorized changes are made to the site/any unauthorized changes are made in the installation of the system. Improvement Permit is valid for 60 months from date of issuance.

Signed: Robert S Luckey

Improvement Permit by: Wesley Sparks R.S. date 4/19/94

Existing System Inspection by: _____ date _____

Installed by: Boyd Christenbury

Certificate of Completion by: Wesley Sparks R.S. date 9/10/94

Operation Permit by: _____ date _____

HEALTH DEPT. COPY: WHITE INSPECTION COPY (FINAL): GREEN OWNER COPY (FINAL): YELLOW INSPECTION COPY (INITIAL): PINK OWNER COPY (INITIAL): GOLD