IREDELL COUNTY HEALTH DEPARTMENT

STATESVILLE 704-878-5305 MOORESVILLE 704-664-5281

IMPROVEMENT PERMIT / CERTIFICATE OF COMPLETION / OPERATION PERMIT / EXISTING SYSTEM INSPECTION

PROPERTY DESCRIPTION NO. 16919 DATE 8/30/93 TAX MAP NO. 1B 2A 19+20

OWNER OR CONTRACTOR RONALD H WALDRON PHONE: Business 664-1490 Home ANE 4664-59-3399

ADDRESS Rt 2 Box 5ND MOORESVILLE, NC. 28115

LOCATION SHEARERS CHAPEL RD, TL ON VISTA DR TO 3+4 LOTS ON (R)

SUBDIVISION BELLEGLADE BLOCK / SECTION ____ LOT 19+20 LOT AREA 1.8 AC. SITE CLASS. P L.T.A.R. .25-.3

Water Supply: ☑ Individual ☐ Community ☐ Public

Septic Tank: 1000 Gallons; STB 358 Date 12/6/93

Pump Tank: ____ Gallons; PT ____ Date ____

Nitrification Field: No Fields 1 Square Feet 1200 Linear Feet 400

No Lines 4 Trench Width 36" Trench Depth 36" Gravel Depth 12"

☑ New System ☐ Repair System Type: I (II) II, IV, V, VI

System Description: CONV.

Repair System Description: CONV.

Maintenance Agreement Required: ☐ Yes ☐ No

☑ House/Mod. Home No. Bedrooms 3 Garbage Disposal: ☐ Yes ☑ No

☐ Mobile Home No. Bathrooms 2 Auto. Dishwasher: ☑ Yes ☐ No


☐ Business No. Employees ____ Auto. Washing Machine: ☑ Yes ☐ No

☐ Other ____ Other ____

☐ Slab ☑ Crawl Space ☐ Basement w/plumbing ☐ Basement wo/plumbing

Comments: TRENCHES ON SLOPE CONTOUR IN DIRECTION SHOWN. LINES INSTALLED IN DIRECTION SHOWN.

INITIAL SITE SKETCH

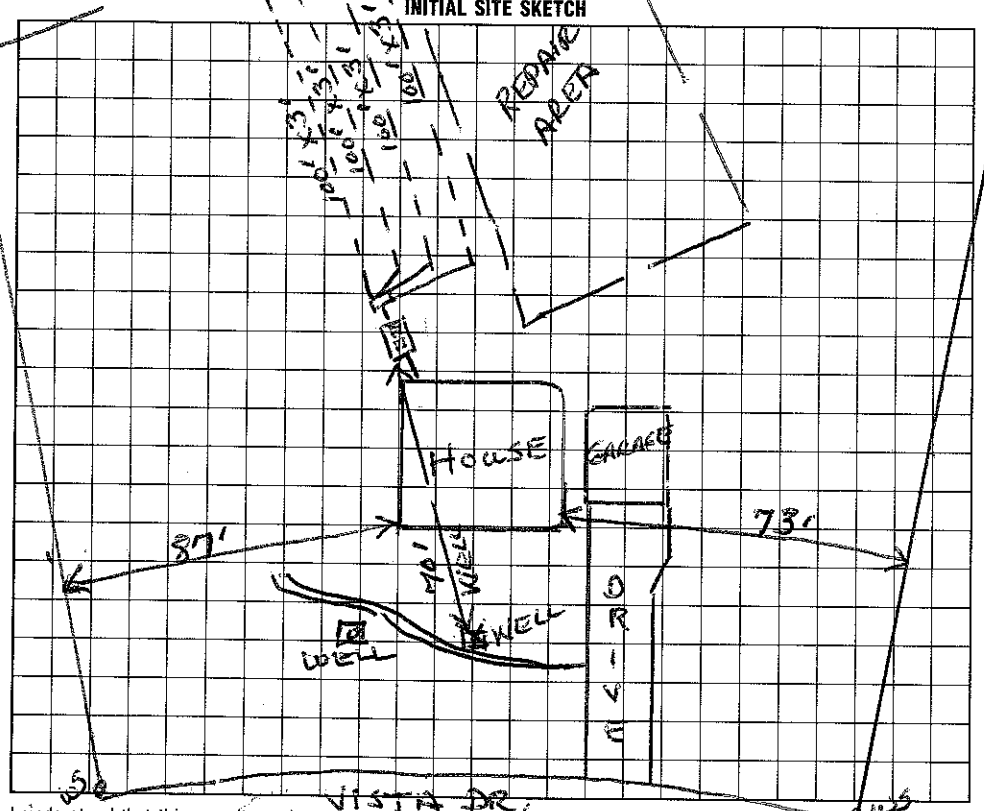

AS BUILT SKETCH

Installed Essentially As Shown

I understand that this permit can be suspended or revoked if any false information is supplied toward securing the permit/any unauthorized changes are made to the site/any unauthorized changes are made in the installation of the system. Improvement Permit is valid for 60 months from date of issuance.

Signed: X Ronald H Waldron

Improvement Permit by: Wesley Sparks R.S. date 8/30/93

Existing System Inspection by: ____ date ____

Installed by: Lavon Boston

Certificate of Completion by: Wesley Sparks R.S. date 3/14/94

Operation Permit by: ____ date ____

HEALTH DEPT. COPY: WHITE INSPECTION COPY (FINAL): GREEN OWNER COPY (FINAL): YELLOW INSPECTION COPY (INITIAL): PINK OWNER COPY (INITIAL): GOLD