IREDELL COUNTY HEALTH DEPARTMENT

STATESVILLE 704-878-5305 MOORESVILLE 704-664-5281

IMPROVEMENT PERMIT / CERTIFICATE OF COMPLETION / OPERATION PERMIT / EXISTING SYSTEM INSPECTION

PROPERTY DESCRIPTION NO. 17732 DATE 2/25/94 TAX MAP NO. 1B 2A 18 Watershed: ☑ Yes ☐ No

OWNER OR CONTRACTOR CRAIG MICALLEF PHONE: Business 4664-59-4390 Home 704-573-9581

ADDRESS VISTA DRIVE MOORESVILLE, NC.

LOCATION SHEARERS RD TL VISTA DR To 5th lot on (L)

SUBDIVISION BELLE GLADE BLOCK / SECTION 1 LOT 18 LOT AREA ~1.14AC SITE CLASS. P DESIGN FLOW 360 L.T.A.R. .2-.25

Septic Tank: 1000 Gallons; STB 794 Date 7/27/94

Pump Tank: 1000 Gallons; PT 27 Date 7/27/94

Pump Make: MYERS Model ME-40-4 Serial No. 994

Nitrification Field: No Fields 1 Square Feet 1440 Linear Feet *240

No Lines 4 Trench Width 2' Max Trench Bottom Depth 36" Gravel Depth 6" SAND

☑ New System ☐ Repair System Type: I, II, III, (IV), V, VI

System Description: PRESSURE PANEL

Repair System Description: GRAVITY PANEL

Maintenance Agreement Required: ☑ Yes ☐ No

☑ House/Mod. Home No. Bedrooms 3

☐ Mobile Home No. Bathrooms 2

☐ Business No. Employees ____

☐ Other ____


☐ Slab ☑ Crawl Space ☐ Basement w/plumbing ☐ Basement wo/plumbing

Water Supply: ☑ Individual ☐ Community ☐ Public

Comments: *.5 REDUCTION FOR 16" PP BAS SYSTEM

Comments: 9/29/94 S/T - P/T OK'd - LOCATION OK'd

INITIAL SITE SKETCH

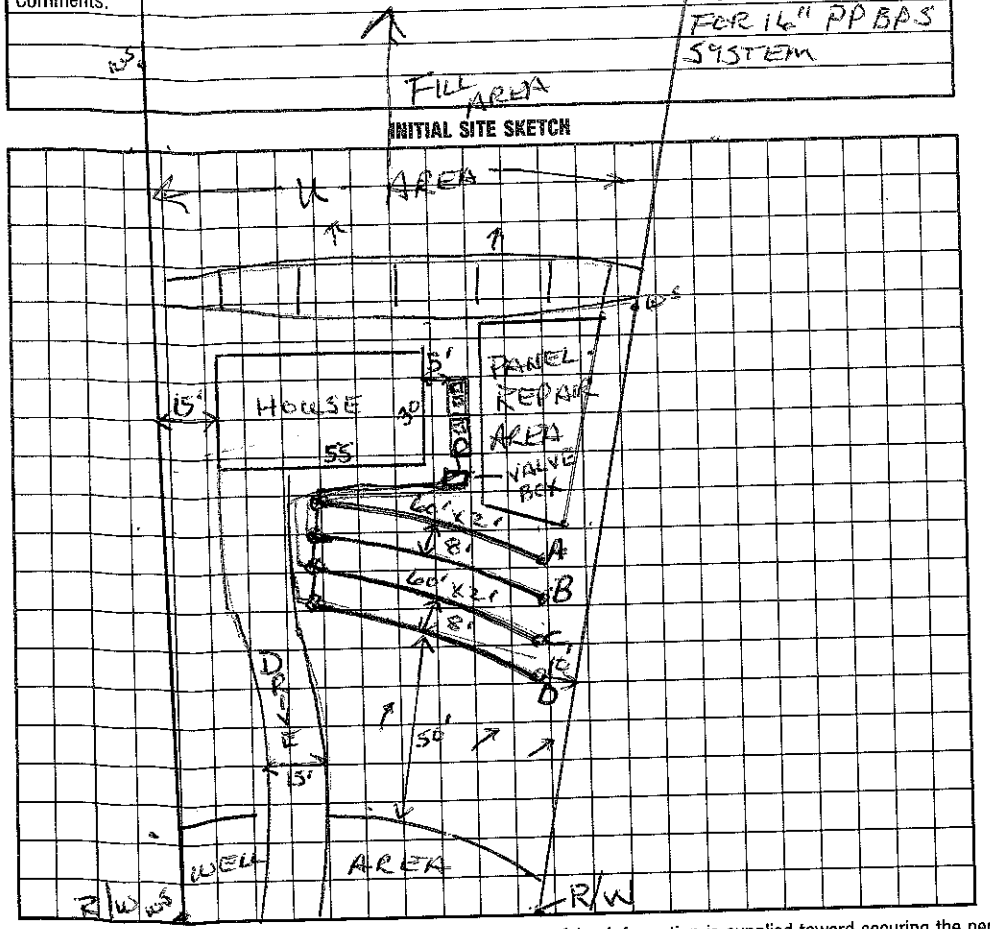

AS BUILT SKETCH

I understand that this permit can be suspended or revoked if any false information is supplied toward securing the permit/any unauthorized changes are made to the site/any unauthorized changes are made in the installation of the system. Improvement Permit is valid for 60 months from date of issuance.

Signed: [signature] Installed by: Ken Christina

Improvement Permit by: Wesley Sparks R.S. date 2/25/94 Certificate of Completion by: Wesley Sparks R.S. date 10/31/94

Existing System Inspection by: ____ date ____ Operation Permit by: ____ date ____

HEALTH DEPT. COPY: WHITE INSPECTION COPY (FINAL): GREEN OWNER COPY (FINAL): YELLOW INSPECTION COPY (INITIAL): PINK OWNER COPY (INITIAL): GOLD