IREDELL COUNTY HEALTH DEPARTMENT

STATESVILLE 704-878-5305 MOORESVILLE 704-664-5281

IMPROVEMENT PERMIT / AUTHORIZATION TO CONSTRUCT / OPERATION PERMIT / EXISTING SYSTEM INSPECTION

PERMIT# 129871 PIN# 4664 65 4407 DATE 1/6/06

OWNER OR APPLICANT James Perryman PHONE: Business 704 892 4730 Home

ADDRESS 135 Royal Oak Way Mooresville, NC. 28115

LOCATION Shearers Rd. to D just before Wilson Farm sign to end of road

SUBDIVISION N/A BLOCK / SECTION LOT 1 LOT AREA 30+ AC SITE CLASS. PS DESIGN FLOW 100 L.T.A.R. .3

Septic Tank: 1000 Gallons; STB 350 Date 10/06 ☒ New System ☐ Repair ☐ Expansion System Type: I (II) III IV V VI ☐ House/Mod. Home No. Bedrooms ___ Water Supply: ☒ Individual

Pump Tank: ___ Gallons; PT ___ Date ___ System Description: GRAV - CONVENTIONAL ☐ Mobile Home No. Persons ___ ☐ Public


Pump Make: ___ Model ___ Serial No. ___ Repair System Description: SAME ☐ Business No. Employees ___ ☐ Community

Nitrification Field: No Fields ___ Square Feet 330 Linear Feet 110 Maintenance Agreement Required: ☐ Yes ☒ No ☒ Other LARGE GARAGE BLDG

No Lines 2 @ 55' Trench Width 3' Max Trench Bottom Depth 3' Gravel Depth 12" ☒ Gravity ☐ Pressure ☐ Slab ☐ Crawl Space ☐ Basement w/plumbing ☐ Basement wo/plumbing

Comments:/Conditions:

INITIAL SITE SKETCH

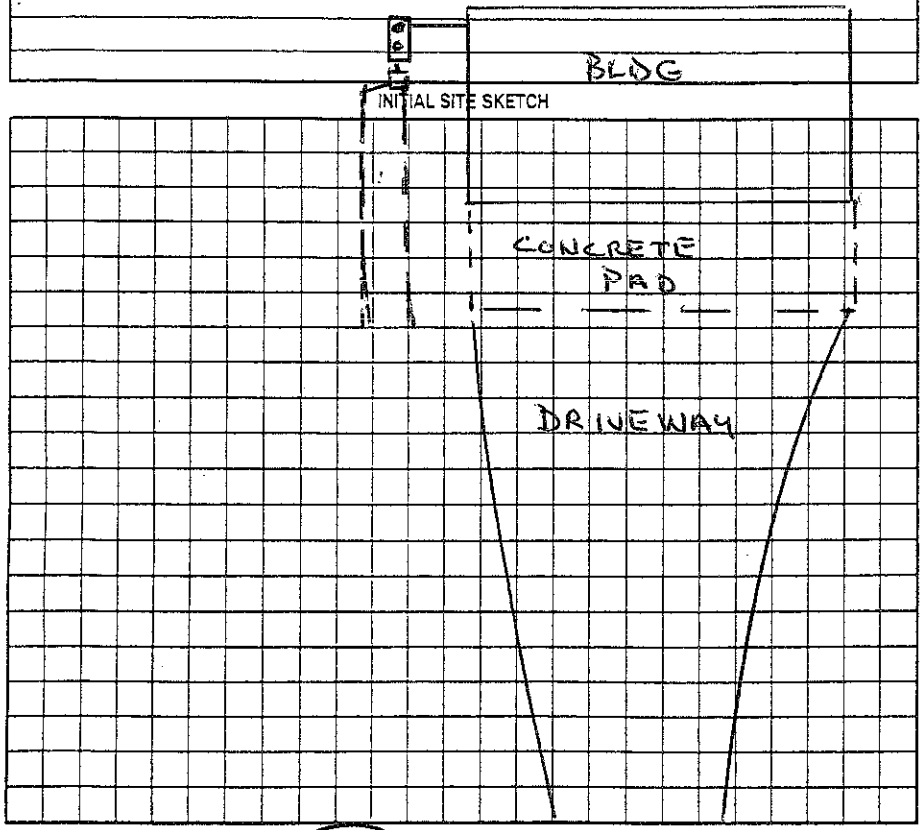

Comments:/Conditions:

AS BUILT SKETCH

Permit can be suspended or revoked if any false information is supplied toward securing the permit/any unauthorized changes are made to the site/any unauthorized changes are made in the installation of the system. Improvement Permit with plat valid without expiration ☐ Improvement Permit with site plan valid for sixty months ☐ Authorization to Construct is valid for a period equal to that of Improvement Permit – not to exceed sixty months.

Signed: James Perryman date 1/13/06 Installed by: Piedmont

Improvement Permit by: Wesley Sparks R.S. date 1/6/06 Operation Permit by: Wesley Sparks R.S. date 4/13/06

Authorization to Construct by: Wesley Sparks R.S. date 1/6/06 Existing System Inspection by: ___ date ___

HEALTH DEPT. COPY: WHITE OWNER COPY (FINAL): YELLOW OWNER COPY (INITIAL): PINK