IREDELL COUNTY HEALTH DEPARTMENT

STATESVILLE 704-878-5305 MOORESVILLE 704-664-5281

IMPROVEMENT PERMIT / AUTHORIZATION TO CONSTRUCT / OPERATION PERMIT / EXISTING SYSTEM INSPECTION

PERMIT# 130792 PIN# 4664 372559.026 4664-66-0425 DATE 2/21/07

OWNER OR APPLICANT Edwards Construction PHONE: Business Home

ADDRESS

LOCATION Shearers Rd South, Lt Amister Way Rt Logen Crossing, on Lt near end

SUBDIVISION Amister BLOCK / SECTION LOT 26/26A LOT AREA SITE CLASS P.S. (easement) DESIGN FLOW 480gpd L.T.A.R. .25 (easement) acts to

Septic Tank: 1000 Gallons; STB 704 Date 5/4/07

Pump Tank: 1000 Gallons; PT 27 Date 6/5/07

Pump Make Goulds Model WE 1512 HH Serial No.

Nitrification Field: No Fields 1 Square Feet 960 Linear Feet 320

No Lines 5 Trench Width 24"/36" Max Trench Bottom Depth 36" Gravel Depth N4 ☐ Gravity ☒ Pressure

☒ New System ☐ Repair ☐ Expansion System Type: I II III IV V VI

System Description: Low Pressure Pipe Block

Repair System Description: Same

Maintenance Agreement Required: ☒ Yes ☐ No

☒ House/Mod. Home No. Bedrooms 4

☐ Mobile Home No. Persons

☐ Business No. Employees

☐ Other

Water Supply: ☒ Individual ☐ Public ☐ Community


☐ Slab ☒ Crawl Space ☐ Basement w/plumbing ☐ Basement wo/plumbing

Comments:/Conditions:


- Tie CVB into pre-plumbed supply line
- Leave Repair Area undisturbed

Comments:/Conditions: This sketch is correct shape of Lot 26A original sketch is actually 25A see plat. AC drainlines checked 10/12 & 10/15/07

INITIAL SITE SKETCH

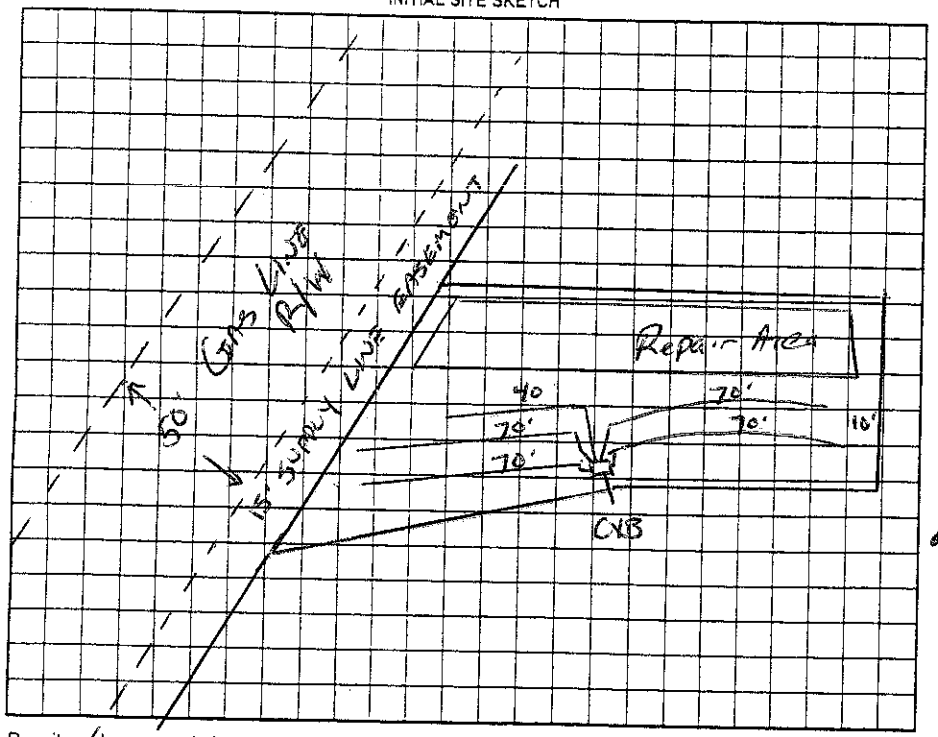

AS BUILT SKETCH

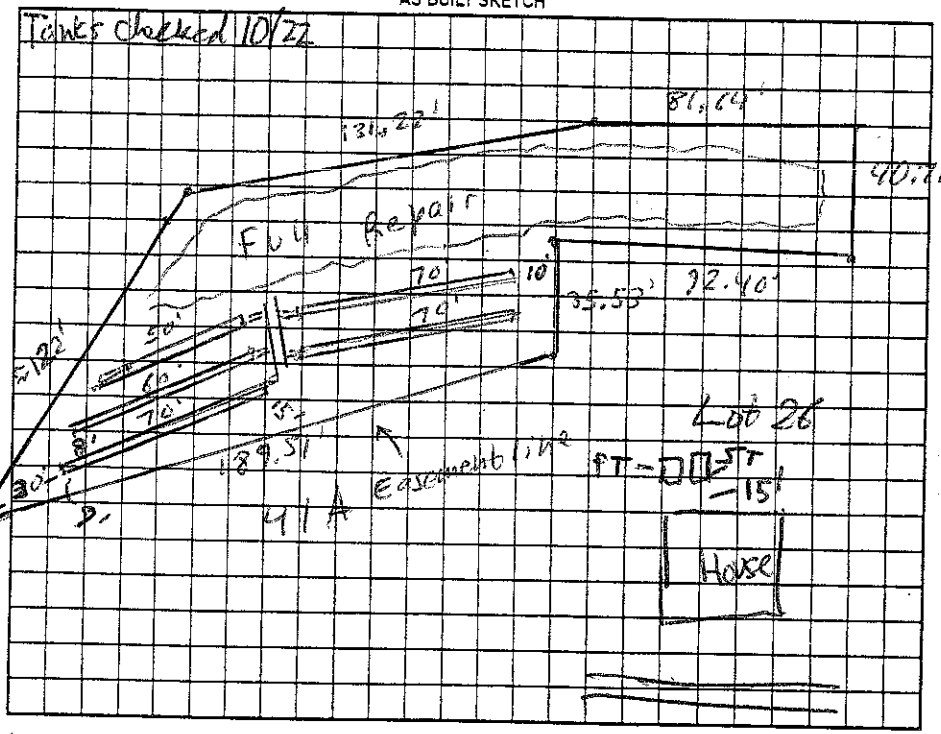

Permit can be suspended or revoked if any false information is supplied toward securing the permit/any unauthorized changes are made to the site/any unauthorized changes are made in the installation of the system. Improvement Permit with plat valid without expiration ☐ Improvement Permit with site plan valid for sixty months ☒ Authorization to Construct is valid for a period equal to that of Improvement Permit – not to exceed sixty months.

Signed: Ann A Edwards date 3-30-07

Improvement Permit by: John E Alph date 2/21/07

Authorization to Construct by: John E Alph date 2/22/07

Installed by:

Operation Permit by: Anthony Coleen Jr. date 10/24/07

Existing System Inspection by: date

HEALTH DEPT. COPY: WHITE OWNER COPY (FINAL): YELLOW OWNER COPY (INITIAL): PINK