# IREDELL COUNTY HEALTH DEPARTMENT

Statesville Office (704) 878-5305 | Mooresville Office (704) 660-3625 | PERMIT # 202358

## IMPROVEMENT PERMIT / AUTHORIZATION TO CONSTRUCT / OPERATION PERMIT / EXISTING SYSTEM

PIN # 4004-66-5007

APPLICANT: JUSTIN BOYER | APPLICANT ADDRESS: HUNTERSVILLE NC

SITE ADDRESS: 221 LOGAN CROSSING V | PHONE: 518-928-7303 | ALT. PHONE:

SITE DIRECTIONS: SHEARERS, TL ANNISTON, TR LOGAN CROSSING, C END

SUBDIVISION: ANNISTON | SECTION: 1 | LOT # 28 | LOT AREA: 5.787 AC | DESIGN FLOW: 480 | L.T.A.R.: .3


| | | | | | | | | | |
|---|---|---|---|---|---|---|---|---|---|
| Septic Tank | 1000 (gal) | STB | 794 | Date | 3-4-16 | ☒ New System ☐ Repair ☐ Expansion | System Type: I II III IV V VI | ☒ Residence | No. Bedrooms 4 |
| Pump Tank | 1000 (gal) | PT | 283 | Date | 3-4-16 | System Description: | PM 25% RED. | ☐ Business | No. Persons |
| Pump Make | ZOELLER | Model | 0165-C | Serial # | | Repair System Description: | LP PANEL BLOCK | ☐ Other | No. Employees |
| # Nitrification Fields | 1 | # Lines | 5 C 80' | Linear Ft: | 400' | Maintenance Agreement Required: | ☐ YES ☒ NO | ☐ Slab | ☐ Crawl Space |
| Trench Width | 36" | Max. Trench Bottom Depth | ~30" | Gravel Depth | — | | ☐ GRAVITY ☒ PRESSURE | ☒ Basement w/plumbing | ☐ Basement w/o plumbing |

Water Supply: ☒ Private ☐ Public ☐ Community

Comments / Conditions: 1/2" SCH40 TAPS

CHECKED LINES, TANKS, & PM 4-5-16
CHECKED ELEC. ALARM, SET 2' PM SA
5-13-16 BA

INITIAL SITE SKETCH

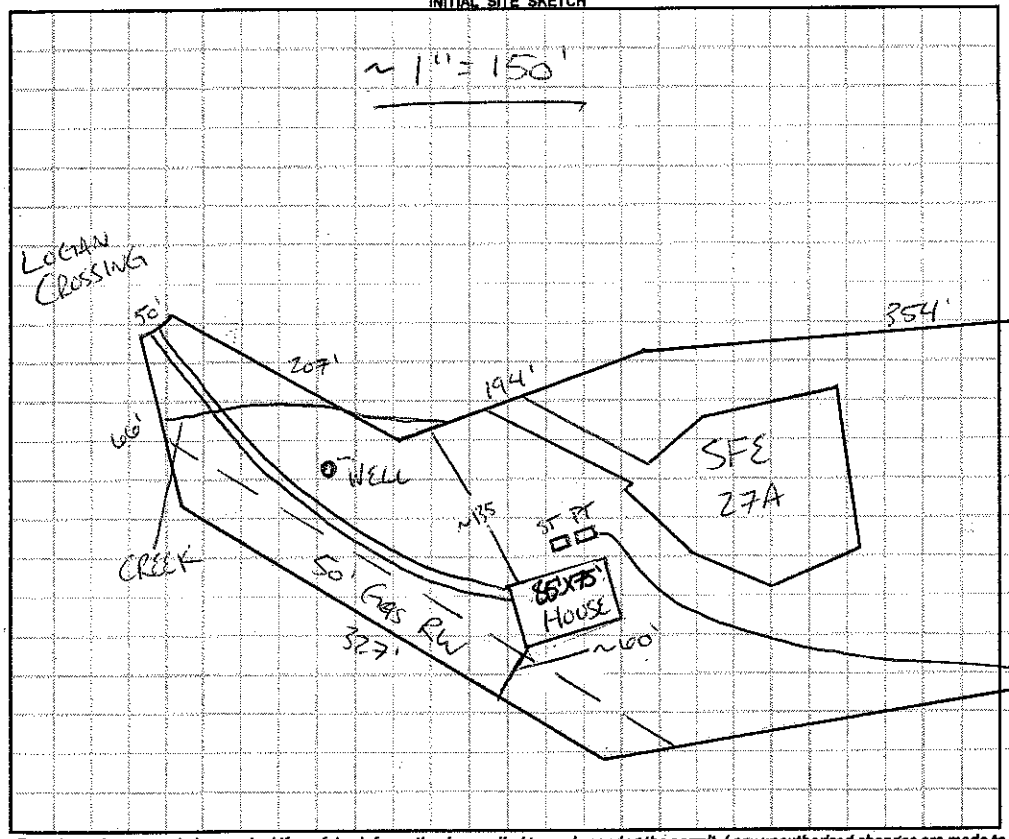


AS BUILT SKETCH

*Permit can be suspended or revoked if any false information is supplied toward securing the permit / any unauthorized changes are made to the site / any unauthorized changes are made in the installation of the system.* **CONTACT A LOCATOR SERVICE PRIOR TO ANY EXCAVATION**

☐ **IMPROVEMENT PERMIT** *with plat valid without expiration.* ☒ **IMPROVEMENT PERMIT** *with site plan valid for 60 mos.* ☒ **AUTHORIZATION TO CONSTRUCT** *valid for period equal to IMPROVEMENT PERMIT--not to exceed 60 mo.*

Owner / Applicant Signature: BA | Date: 4/15/15 | Installed by: BASS GRADING

IMPROVEMENT PERMIT by: BA | Date: APPROVED APR 13 2015 | OPERATION PERMIT by: BA | Date: 5-13-16

AUTHORIZATION TO CONSTRUCT by: BA | Date: APPROVED JUN 05 2015 | Existing System Inspected by: | Date:

Health Dept. Copy - WHITE  Applicant (Final Approval) - YELLOW  Applicant (Conditional Approval) - PINK