IREDELL COUNTY HEALTH DEPARTMENT

STATESVILLE 704-878-5305 MOORESVILLE 704-664-5281

IMPROVEMENT PERMIT / AUTHORIZATION TO CONSTRUCT / OPERATION PERMIT / EXISTING SYSTEM INSPECTION

PERMIT# 136823 PIN# 4664678995,074 4664-67-5657 DATE 9-7-07

OWNER OR APPLICANT Biuto Builders PHONE: Business 704-782-6216 Home

ADDRESS 1007 Central Dr Concord NC 28027

LOCATION Shearers Rd S Th Anniston Way TR Burnell Place 2nd on right

SUBDIVISION Anniston BLOCK / SECTION 2 LOT 74 LOT AREA 1.9 Ac SITE CLASS. PS DESIGN FLOW 480 gpd L.T.A.R. .25 gpd/ft²

Septic Tank: 1000 Gallons: STB 749 Date 2/28/07

Pump Tank: 1000 Gallons: PT 283 Date 7/20/07

Pump Make: Model Serial No.

Nitrification Field: No Fields 1 Square Feet 969 Linear Feet 323

No Lines 6 Trench Width 36" Max Trench Bottom Depth 36"

☒ New System ☐ Repair ☐ Expansion System Type: I II III (IV) V VI

System Description: LPPPBPS

Repair System Description: LPPPBPS

Maintenance Agreement Required: ☒ Yes ☐ No

☒ House/Mod. Home ☐ Mobile Home ☐ Business ☐ Other

No. Bedrooms 4 No. Persons 8 No. Employees

Water Supply: ☒ Individual ☐ Public ☐ Community


Gravel Depth NA ☐ Gravity ☒ Pressure ☐ Slab ☐ Crawl Space ☒ Basement w/plumbing ☐ Basement wo/plumbing

Comments:/Conditions: Redraw based on plan from Rollans Soil & Environmental Services
* per plan specs
Tank to be placed no deeper than 3' below finished grade


Comments:/Conditions: 3' Ditches - 5/32" ho Lo
House drawn as staked
Pressure set 11/13/07 AC

INITIAL SITE SKETCH

1" = 60'

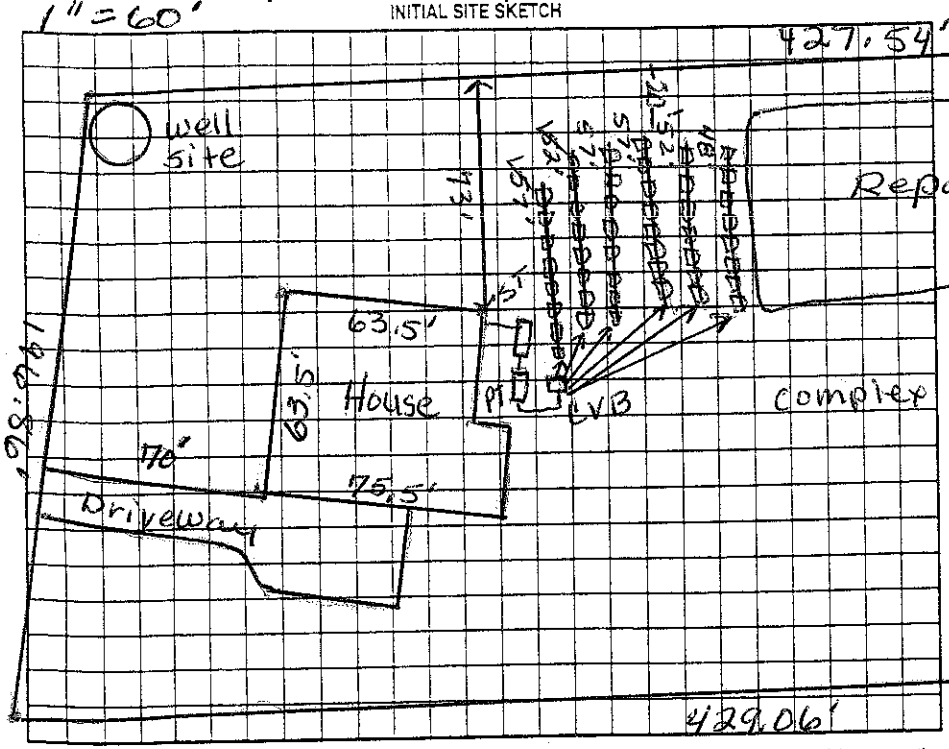

AS BUILT SKETCH

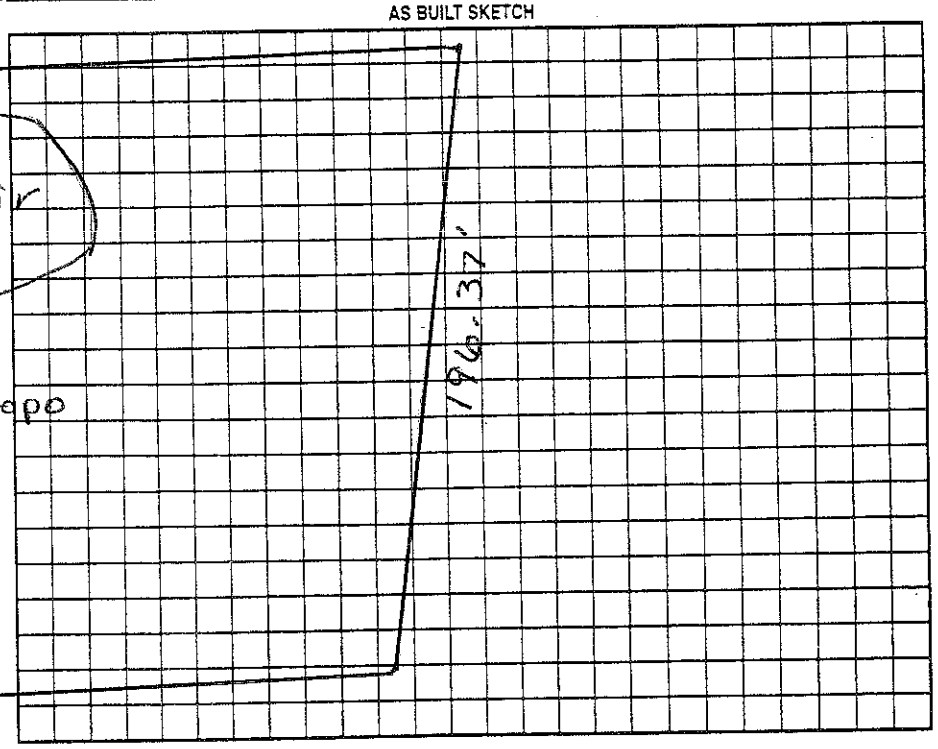

Permit can be suspended or revoked if any false information is supplied toward securing the permit/any unauthorized changes are made to the site/any unauthorized changes are made in the installation of the system. Improvement Permit with plat valid without expiration ☐ Improvement Permit with site plan valid for sixty months ☒ Authorization to Construct is valid for a period equal to that of Improvement Permit – not to exceed sixty months.

Signed: date 9-12-07 Installed by: A-1

Improvement Permit by: Cindy McNeill date 9-10-07 Operation Permit by: date 5-19-08

Authorization to Construct by: Cindy McNeill date 9-10-07 Existing System Inspection by: date

HEALTH DEPT. COPY: WHITE OWNER COPY (FINAL): YELLOW OWNER COPY (INITIAL): PINK