IREDELL COUNTY HEALTH DEPARTMENT

185 Anniston Way - Davidson

STATESVILLE 704-878-5305 MOORESVILLE 704-664-5281

10.00

IMPROVEMENT PERMIT / AUTHORIZATION TO CONSTRUCT / OPERATION PERMIT / EXISTING SYSTEM INSPECTION

PERMIT# 123253 PIN# 4664670278.002 9664-68-0192 DATE 4/15/05

OWNER OR CONTRACTOR RIDGELINE DEVELOPMENT / Edwards Construction PHONE (Business) 362-5007 Home

ADDRESS 17105 KEATON DR. SUITE 207-6 CORNELIUS NC 28031

LOCATION SHEARERS RD - TL ANNISTON WAY - ON LT

SUBDIVISION ANNISTON BLOCK / SECTION 1 LOT 2 LOT AREA 1.32Ac SITE CLASS. PS DESIGN FLOW 480GPD L.T.A.R. .25 GPD/FT2

Septic Tank: 1000 Gallons; STB 744 Date 12/29/07

Pump Tank: 1000 Gallons; PT 233 Date 1/26/09

Pump Make: Goulds Model WE1512HH Serial No.

Nitrification Field: No Fields 1 Square Feet 660 Linear Feet ~~320~~ 330

No Lines 4 Trench Width 24" Max Trench Bottom Depth 36" Gravel Depth N/A

☑ New System ☐ Repair System Type: I, II, III, (IV), V, VI

System Description: LP PANEL

Repair System Description: SAME

Maintenance Agreement Required: ☑ Yes ☐ No

☑ House/Mod. Home No. Bedrooms 4

☐ Mobile Home No. Bathrooms 4

☐ Business No. Employees


☐ Other

☐ Slab ☑ Crawl Space ☐ Basement w/plumbing ☐ Basement wo/plumbing

Water Supply: ☐ Individual ☑ Public ☐ Community

Comments:/Conditions:

1" = 60' INITIAL SITE SKETCH

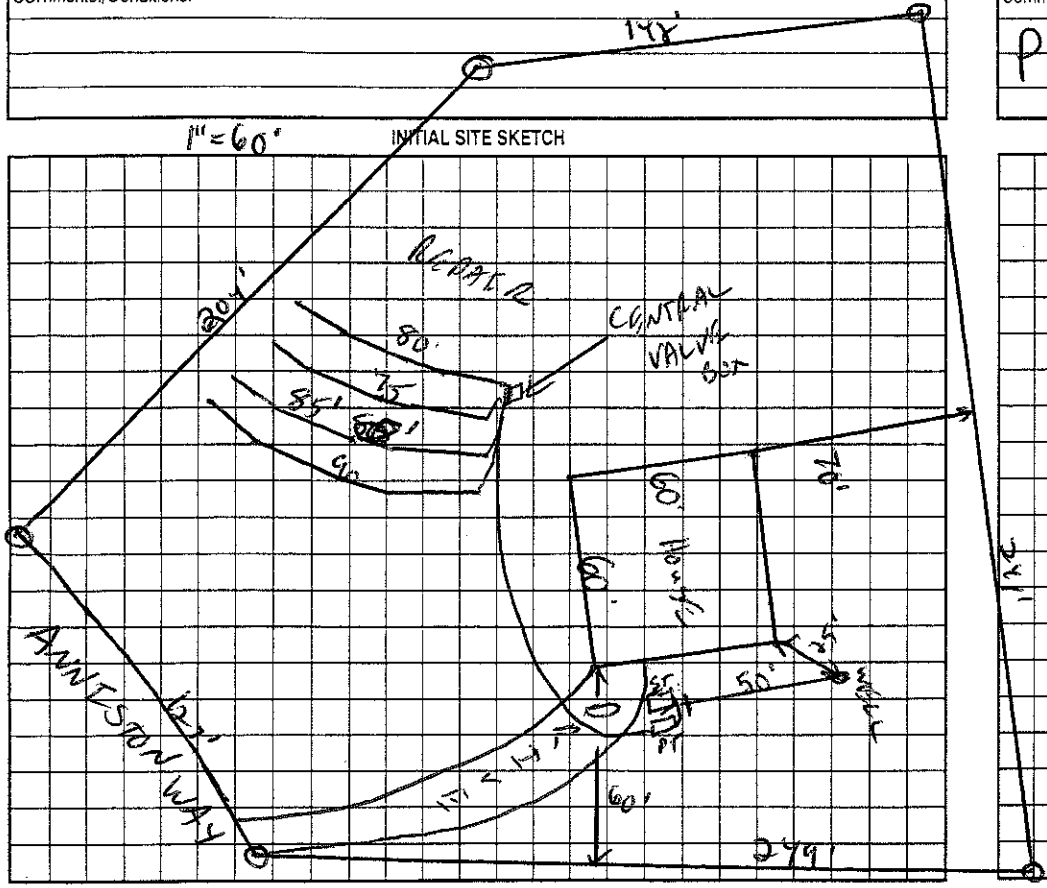

Comments:/Conditions: Reviewed Building plans & site plan; essentially in compliance with I.P.

AS BUILT SKETCH

-4 lines (Panel) installed @ 75' each due to pre-grading of site causing steep ~10' embankment side sloping towards driveway

-Installer left 15' between trenches and side slope; if any further cutting/shaving of embankment after final grading for landscaping etc, then permit will be revoked no room to spare

Permit can be suspended or revoked if any false information is supplied toward securing the permit/any unauthorized changes are made to the site/any unauthorized changes are made in the installation of the system. Improvement Permit with plat valid without expiration. Improvement Permit with site plan valid for sixty months. Authorization to Construct is valid for a period equal to that of Improvement Permit – not to exceed sixty months.

Signed: Keri Jomashwolu date 5-17-05 Installed by: Marty Tucker

Improvement Permit by: RS date 4/15/05 Operation Permit by: date 3/13/09

Authorization to Construct by: RS date 8/25/05 Existing System Inspection by: date

HEALTH DEPT. COPY: WHITE OWNER COPY (FINAL): YELLOW OWNER COPY (INITIAL): PINK