IREDELL COUNTY HEALTH DEPARTMENT

Statesville Office (704) 878-5305 Mooresville Office (704) 660-3625 PERMIT # 172557

IMPROVEMENT PERMIT / AUTHORIZATION TO CONSTRUCT / OPERATION PERMIT / EXISTING SYSTEM

PIN # 4664684128

APPLICANT: MONTON GENERAL CONTRACTING APPLICANT ADDRESS: 9409 TITUS LN HUNTERSVILLE NC 28078

SITE ADDRESS: 203 ANNISTON WAY DAVIDSON NC 28036 PHONE: ALT. PHONE: 704 877 2077

SITE DIRECTIONS: SHEARERS RD - TL ANNISTON WAY - ON LT

SUBDIVISION: ANNISTON SECTION: 1 LOT # 47 LOT AREA: .92AC DESIGN FLOW: 480 L.T.A.R.: .25

Septic Tank	1000 (gal)	STB	360	Date	1-18	☑ New System ☐ Repair ☐ Expansion System Type: I II (III) IV V VI		☑ Residence	No. Bedrooms	4	Water Supply
Pump Tank	1000 (gal)	PT	303	Date	9-24	System Description: PUMP 25% REDUCTION		☐ Business	No. Persons	8	☑ Private
Pump Make	GOULDS	Model	WE1012H	Serial #		Repair System Description: LIPPERS		☐ Other	No. Employees		☐ Public
# Nitrification Fields	1	# Lines	6	Linear Ft:	480	Maintenance Agreement Required: ☐ YES ☑ NO		☐ Slab	☑ Crawl Space		☐ Community
Trench Width	36"	Max. Trench Bottom Depth	36"	Gravel Depth	N/A	☐ GRAVITY ☑ PRESSURE		☐ Basement w/plumbing	☐ Basement w/o plumbing		

Comments / Conditions:

INITIAL SITE SKETCH

SEE ROLANS SOIL

& ENVIRONMENTAL'S PLAN

AS BUILT SKETCH

CHECKED APR 03 2014

TANKS

LINES

SET 2' PH

CHECKED ELEC / SUPPLY LINE BA

Permit can be suspended or revoked if any false information is supplied toward securing the permit / any unauthorized changes are made to the site / any unauthorized changes are made in the installation of the system. **CONTACT A LOCATOR SERVICE PRIOR TO ANY EXCAVATION**


☐ **IMPROVEMENT PERMIT** *with plat valid without expiration.* ☐ **IMPROVEMENT PERMIT** *with site plan valid for 60 mos.* ☒ **AUTHORIZATION TO CONSTRUCT** *valid for period equal to IMPROVEMENT PERMIT--not to exceed 60 mo.*

Owner / Applicant Signature: [signature] Date: 2/5/14 Installed by: A-1

IMPROVEMENT PERMIT by: [signature] Date: 2/4/14 OPERATION PERMIT by: BA Date: 8-26-14

AUTHORIZATION TO CONSTRUCT by: [signature] Date: 2/4/14 Existing System Inspected by: Date:

Health Dept. Copy - WHITE Applicant (Final Approval) - YELLOW Applicant (Conditional Approval) - PINK

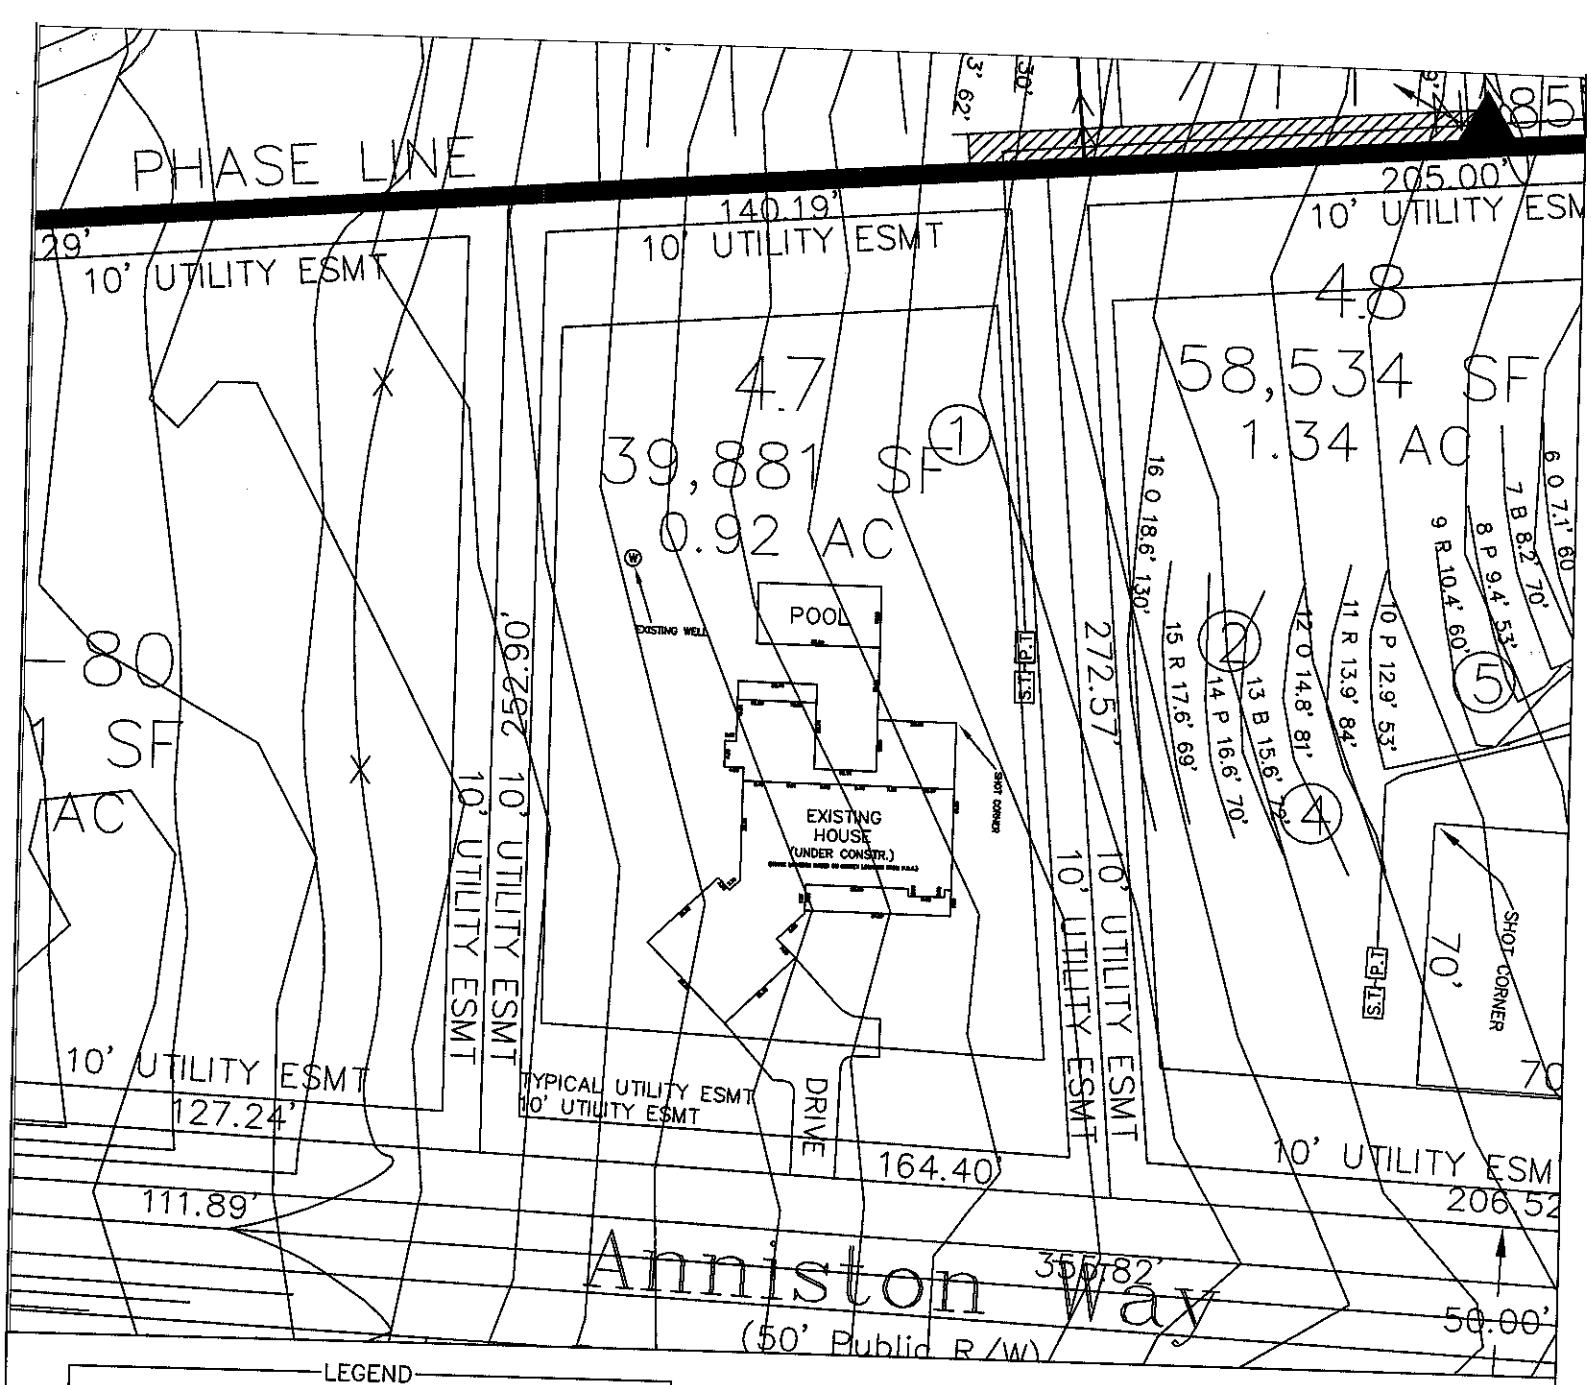

LEGEND

- Areas contain soils with 24 inches or more of useable material and have potential for conventional, modified conventional and low-pressure pipe (lpp) septic systems.
- House Footprint
- System lines.
- Repair lines.
- Temporary Bench Mark (TBM)
- (W) Well Location.
- (25) Pit/Boring Location.

GRAPHIC SCALE
1" = 50'

50 0 50 100

FOR PRELIMINARY PLANNING PURPOSES ONLY. ALL LOTS WILL REQUIRE FINAL APPROVAL BY THE COUNTY HEALTH DEPARTMENT ON A LOT BY LOT BASIS. THIS MAP SHOULD BY USED AS A GENERAL GUIDE, SOME ADJUSTMENTS WILL BE NECESSARY IN THE FIELD DUE TO SOIL VARIABILITY AND COMPLEX TOPOGRAPHIC FEATURES. THIS MAP ONLY REFLECTS EXISTING SOIL SUITABILITY FOR ON-SITE SEPTIC TANK SYSTEMS.

PLEASE REFER TO ATTACHED SOIL REPORT FOR ADDITIONAL SITE SPECIFIC INFORMATION


ROLLANS SOIL & ENVIRONMENTAL SERVICES, PA
P.O. BOX 832
MOORESVILLE, NC 28115
PHONE/FAX: (704) 278 - 0989
ASHLEY ROLLANS, NC LICENSED SOIL SCIENTIST
MOBILE: (704) 746 - 5046
EMAIL: rollans.ashley@yahoo.com

MAP TITLE: SITE PLAN & DRAINFIELD AREAS

PROJECT NAME: GREG MOTON / ANNISTON SUBDIVISION LOT 47

LOCATION/DATE: SHEARER CHAPEL ROAD, IREDELL COUNTY, NORTH CAROLINA, JANUARY 2014

JOB # : 01-1952
FILE: C:\JOBS\01-1952
PROJECT MGR.: S.A.R.
FIELD WORK: S.A.R.
DRAWN BY: S.A.R.

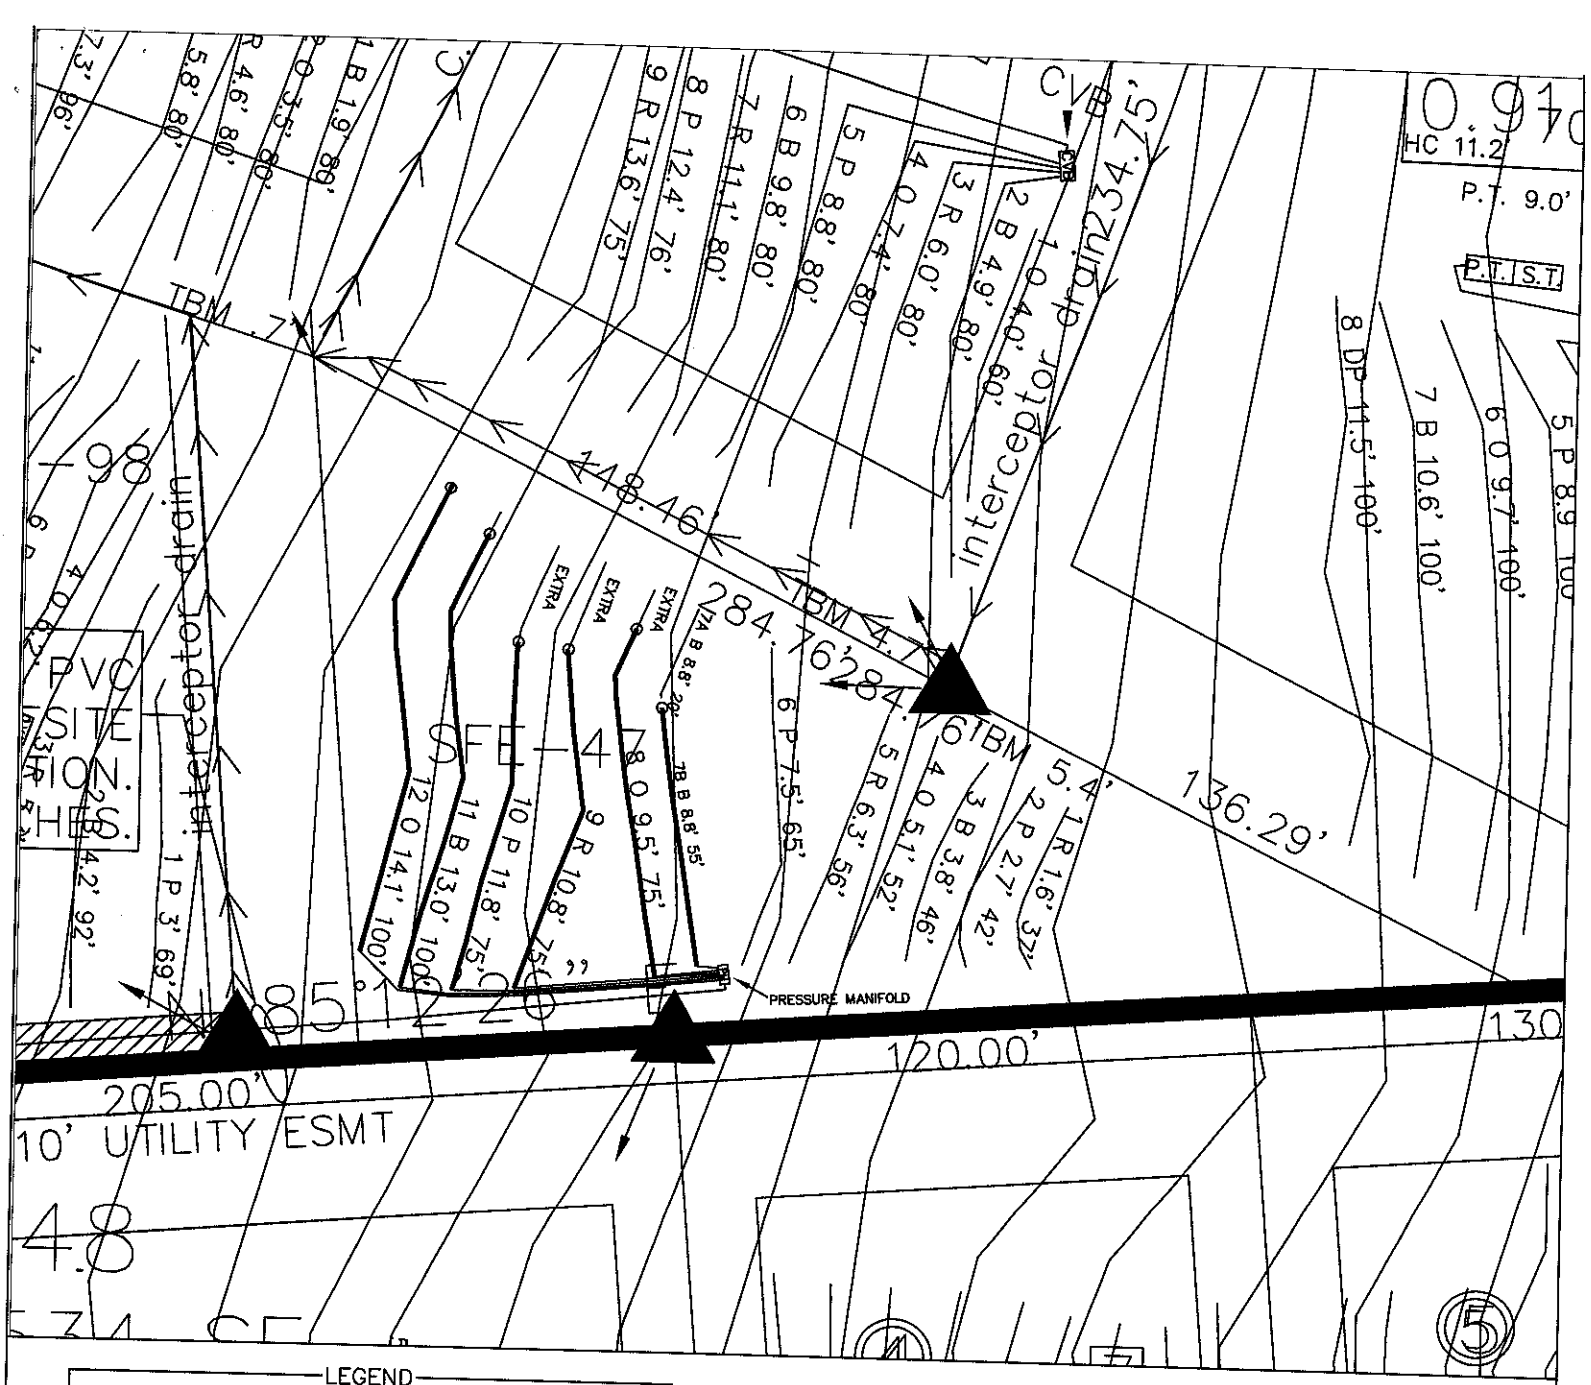

LEGEND

- Areas contain soils with 24 inches or more of useable material and have potential for conventional, modified conventional and low-pressure pipe (lpp) septic systems.
- House Footprint
- System lines.
- Repair lines.
- Temporary Bench Mark (TBM)
- (W) Well Location. (25) Pit/Boring Location.

GRAPHIC SCALE
1" = 40'

40 0 40 80

FOR PRELIMINARY PLANNING PURPOSES ONLY. ALL LOTS WILL REQUIRE FINAL APPROVAL BY THE COUNTY HEALTH DEPARTMENT ON A LOT BY LOT BASIS. THIS MAP SHOULD BY USED AS A GENERAL GUIDE, SOME ADJUSTMENTS WILL BE NECESSARY IN THE FIELD DUE TO SOIL VARIABILITY AND COMPLEX TOPOGRAPHIC FEATURES. THIS MAP ONLY REFLECTS EXISTING SOIL SUITABILITY FOR ON-SITE SEPTIC TANK SYSTEMS.

PLEASE REFER TO ATTACHED SOIL REPORT FOR ADDITIONAL SITE SPECIFIC INFORMATION

ROLLANS SOIL & ENVIRONMENTAL SERVICES, PA
P.O. BOX 832
MOORESVILLE, NC 28115
PHONE/FAX: (704) 278 - 0989
ASHLEY ROLLANS, NC LICENSED SOIL SCIENTIST
MOBILE: (704) 746 - 5046
EMAIL: rollans.ashley@yahoo.com

MAP TITLE: SITE PLAN & DRAINFIELD AREAS

PROJECT NAME: GREG MOTON / ANNISTON SUBDIVISION LOT 47

LOCATION/DATE: SHEARER CHAPEL ROAD, IREDELL COUNTY, NORTH CAROLINA, JANUARY 2014

JOB # : 01-1952
FILE: C:\JOBS\01-1952
PROJECT MGR.: S.A.R.
FIELD WORK: S.A.R.
DRAWN BY: S.A.R.