IREDELL COUNTY HEALTH DEPARTMENT - *ENVIRONMENTAL HEALTH* ☐ STATESVILLE OFFICE 704-878-5305 ☐ MOORESVILLE OFFICE 704-664-5281

IMPROVEMENT PERMIT / AUTHORIZATION TO CONSTRUCT / OPERATION PERMIT / EXISTING SYSTEM INSPECTION

PERMIT # 170895 PIN # 4664468615 8 DATE 3-13-2012

OWNER Robert Berini APPLICANT: Pool By Design PHONE: Home/Cell # 704660 8187 Business # 704333-7446

SITE ADDRESS 211 Anniston Way OWNER / APPLICANT ADDRESS 217 Fairwood Ave. Charlotte, NC 28211

SITE DIRECTIONS Shearers Rd South TL Anniston Way Cross Creek on left

SUBDIVISION Anniston BLOCK / SECTION LOT # 48 LOT AREA 1.344Ac DESIGN FLOW 480gpd L.T.A.R. .225

Septic Tank 1000 Gallons: STB Date

Pump Tank 1000 Gallons: PT Date

Pump Make Model Serial #

No. Nitrification Fields: 1 No. Lines 10 Linear Feet 530

Trench Width 36" Max. Trench Bottom Depth 36" Gravel Depth N/A

☐ New System ☐ Repair ☐ Expansion System Type I II (III) IV V VI

System Description: Exist Pump-PM-25% Reduction

Repair System Description: LP - PPBPS

Maintenance Agreement Required ☐ YES ☒ NO

☐ GRAVITY ☒ PRESSURE


☒ Residence No. Bedrooms 4 ☐ Business No. Persons ☐ Other No. Employees ☐ Slab ☒ Crawl Space ☐ Basement w/plumbing ☐ Basement w/o plumbing

Water Supply: ☒ Private ☐ Public ☐ Community

Comments / Conditions: Existing System "appears" to be Functioning Okay at time of inspection In ground Swimming pool Should not impact Septic System


★ Must keep pool "Cut" at least 15FT From Septic Drainfield & 10FT From Supply line (Approx location of Supply line Marked in field) Located using Site map & probing with iron rod, there's a chance that this was not exact)

INITIAL SITE SKETCH

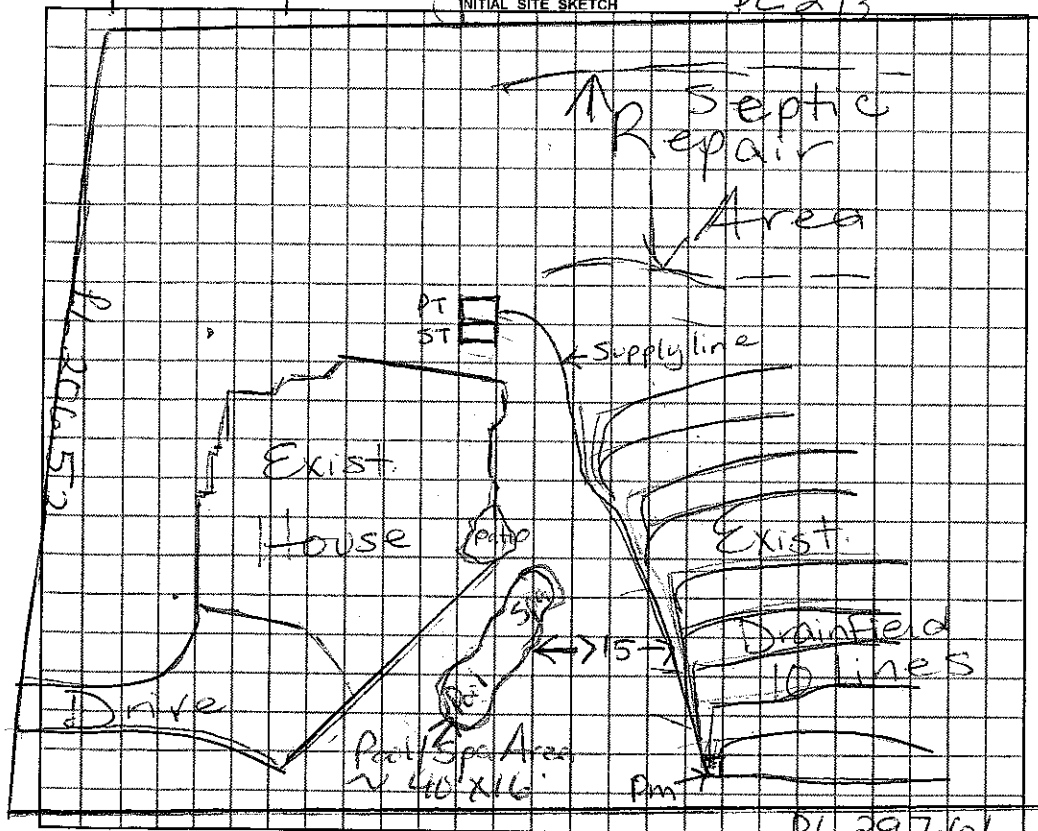

AS BUILT SKETCH

Scale 1:50

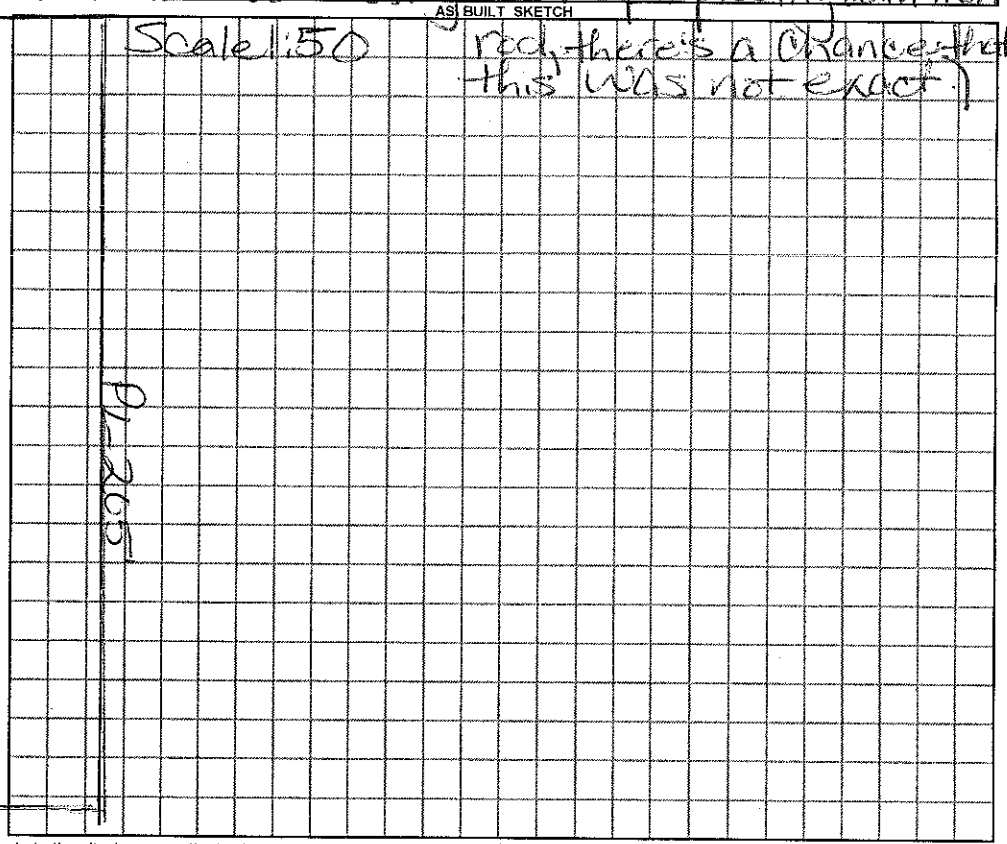

Permit can be suspended or revoked if any false information is supplied toward securing the permit / any unauthorized changes are made to the site / any unauthorized changes are made in the installation of the system.

☐ ***IMPROVEMENT PERMIT*** with plat valid without expiration. ☒ ***IMPROVEMENT PERMIT*** with plat valid without expiration. site plan valid 60 mo. ☐ ***AUTHORIZATION TO CONSTRUCT*** valid for period equal to IMPROVEMENT PERMIT–not to exceed 60 mo.

Owner / Applicant Signature: Carolyn Jones Date 3/21/12 Installed by:

IMPROVEMENT PERMIT by: REHS Date

AUTHORIZATION TO CONSTRUCT by: REHS Date

OPERATION PERMIT by: REHS Date

Existing System Inspected by: Maria H. Colson REHS Date 3/13/2012

YOU SHOULD CONTACT A LOCATOR SERVICE PRIOR TO ANY EXCAVATION

White Copy – Environmental Health YELLOW COPY (Final) Owner / Applicant PINK COPY (Initial) Owner / Applicant