IREDELL COUNTY HEALTH DEPARTMENT

Statesville Office (704) 878-5305 Mooresville Office (704) 660-3625 PERMIT # 138095 RF

IMPROVEMENT PERMIT / AUTHORIZATION TO CONSTRUCT / OPERATION PERMIT / EXISTING SYSTEM

PIN # 4664695083

APPLICANT: WHB Inc. APPLICANT ADDRESS: P.O. Box 4301 Mooresville NC 28117

SITE ADDRESS: 136 Shearers Davidson, NC PHONE: ALT. PHONE:

SITE DIRECTIONS: Shearers Rd TL Anniston Way TL Timberside Dr. TL Honover Ln at end (Offsite Easement located behind)

SUBDIVISION: Anniston SECTION: LOT # 98 LOT AREA: 3.7Ac DESIGN FLOW: 480gpd L.T.A.R.: .25 211 Anniston


Septic Tank	1000	(gal)	STB	194	Date	3-14-14	☒ New System	☐ Repair	☐ Expansion	System Type: I II (III) IV V VI	☒ Residence	No. Bedrooms	4	Water Supply	
Pump Tank	1000	(gal)	PT	21	Date	2-2014	System Description:	Pump-PM-25% Reduction			☐ Business	No. Persons	8	☒ Private	
Pump Make	Myers	Model	~~PE50~~ PF102		Serial #		Repair System Description:	LP PPBPS			☐ Other	No. Employees		☐ Public	
# Nitrification Fields	1	# Lines	4		Linear Ft:	480'	Maintenance Agreement Required:	☐ YES	☒ NO Not Initially		☐ Slab	☒ Crawl Space		☐ Community	
Trench Width	36"	Max. Trench Bottom Depth	36"		Gravel Depth	N/A		☐ GRAVITY	☒ PRESSURE		☐ Basement w/plumbing		☐ Basement w/o plumbing		

Comments / Conditions: ☒ Per original Septic Plan, interceptor "French drain" required around drainfield Area. PL02 Myers pump. Original Septic Assessment & plan prepared by Rollins Soil & Env. Services

5/6/14 Cheekeel tanks, drainlines, & Supply Line. Note: Supply line from Lot 97 running on Lot #98 offsite Easement.

INITIAL SITE SKETCH

Scale 1:100

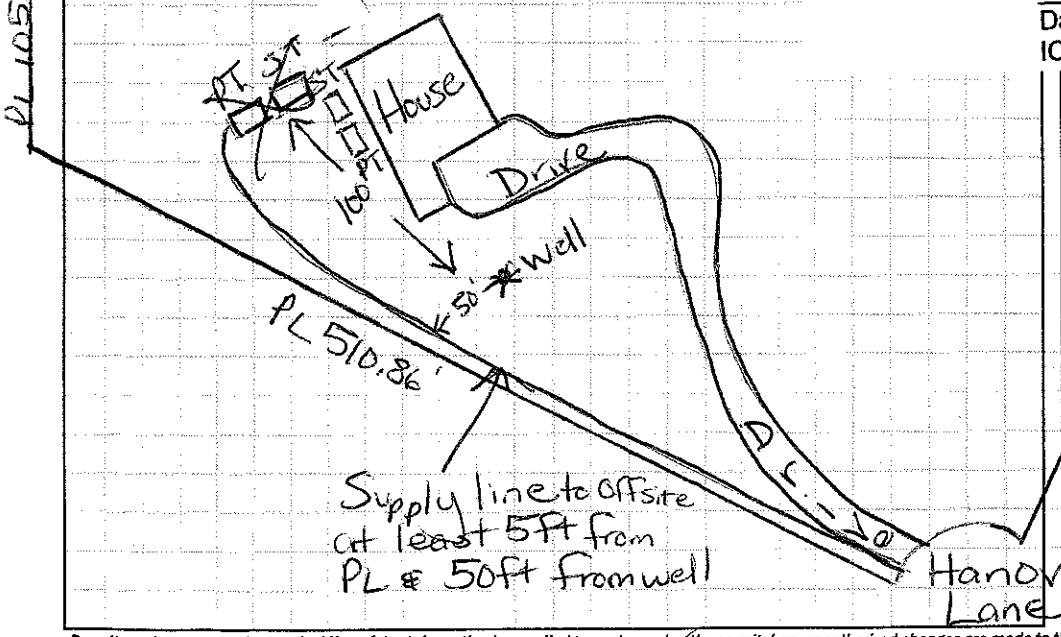

The proposed / existing Inground Swimming Pool addition does not appear to impact the existing septic system.

**NOTE: Must keep Pool at/at least 15Ft from Septic


Maria Dotson R.S.

Date: 5/7/14

ICHD-Environmental Health Division

AS BUILT SKETCH

Scale 1:50

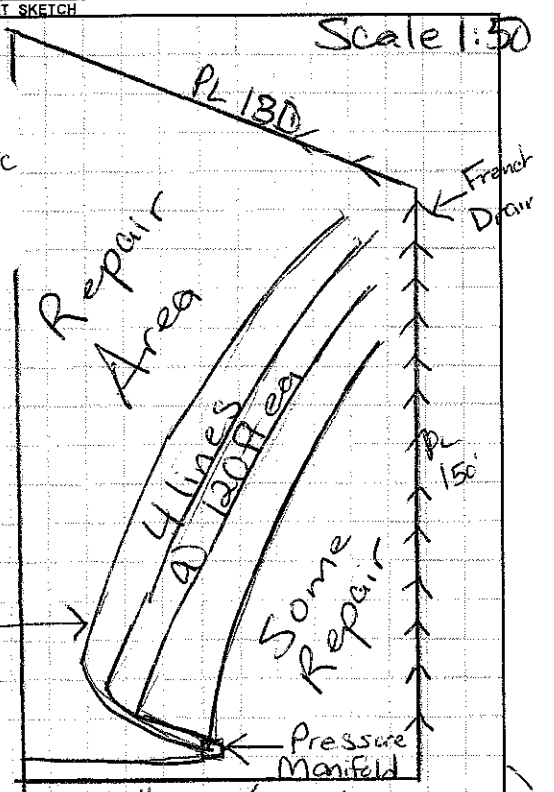

Permit can be suspended or revoked if any false information is supplied toward securing the permit / any unauthorized changes are made to the site / any unauthorized changes are made in the installation of the system. **CONTACT A LOCATOR SERVICE PRIOR TO ANY EXCAVATION**

☐ **IMPROVEMENT PERMIT** *with plat valid without expiration* ☑ **IMPROVEMENT PERMIT** *with site plan valid for 60 mos.* ☐ **AUTHORIZATION TO CONSTRUCT** *valid for period equal to IMPROVEMENT PERMIT--not to exceed 60 mo.*

Owner / Applicant Signature: Date: 9/6/13

IMPROVEMENT PERMIT by: Maria Dotson RS Date: 8/29/13

AUTHORIZATION TO CONSTRUCT by: Maria Dotson RS Date: 8/29/13

Installed by: R & H RS

OPERATION PERMIT by: Maria Dotson Date: 7/28/14

Existing System Inspected by: Date:

Health Dept. Copy - WHITE Applicant (Final Approval) - YELLOW Applicant (Conditional Approval) - PINK