IREDELL COUNTY HEALTH DEPARTMENT

Statesville Office (704) 878-5305 Mooresville Office (704) 660-3625 PERMIT # 14215

IMPROVEMENT PERMIT / AUTHORIZATION TO CONSTRUCT / OPERATION PERMIT / EXISTING SYSTEM

PIN # 4664 76 2701

APPLICANT: Linnane Homes APPLICANT ADDRESS: P.O. Box 472165 Charlotte, NC 28247

SITE ADDRESS: 106 Walking Horse Trail PHONE: ALT. PHONE:

SITE DIRECTIONS: Shearers Rd south TL Anniston Way TR Burnell TL Walking Horse on R

SUBDIVISION: Anniston SECTION: 2 LOT # 64 LOT AREA: .90 Ac DESIGN FLOW: 480 gpd L.T.A.R.: .3

Septic Tank	1000 (gal)	STB	794	Date	12-2-13	☒ New System	☐ Repair	☐ Expansion	System Type: I II III IV V VI	☒ Residence	No. Bedrooms 4
Pump Tank	1000 (gal)	PT	27	Date	12-20-13	System Description:	Pump-PM 25% Reduction			☐ Business	No. Persons
Pump Make	Goulds	Model	WE0312MU	Serial #		Repair System Description:	LPP-PPBPS			☐ Other	No. Employees
# Nitrification Fields	1	# Lines	4	Linear Ft:	400Ft	Maintenance Agreement Required:	☐ YES	☒ NO		☐ Slab	☒ Crawl Space
Trench Width	36"	Max. Trench Bottom Depth	36"	Gravel Depth	N/A		☐ GRAVITY	☒ PRESSURE		☐ Basement w/plumbing	☐ Basement w/o plumbing


Water Supply: ☒ Private ☐ Public ☐ Community

Comments / Conditions: Original Assessment & Septic report prepared by Rollans Soil & Env. Services.


This replaces previous permit dg-Feb 7/20/2007

*Note: Start drainlines towards back of lot as shown & leave area directly behind house open.

INITIAL SITE SKETCH

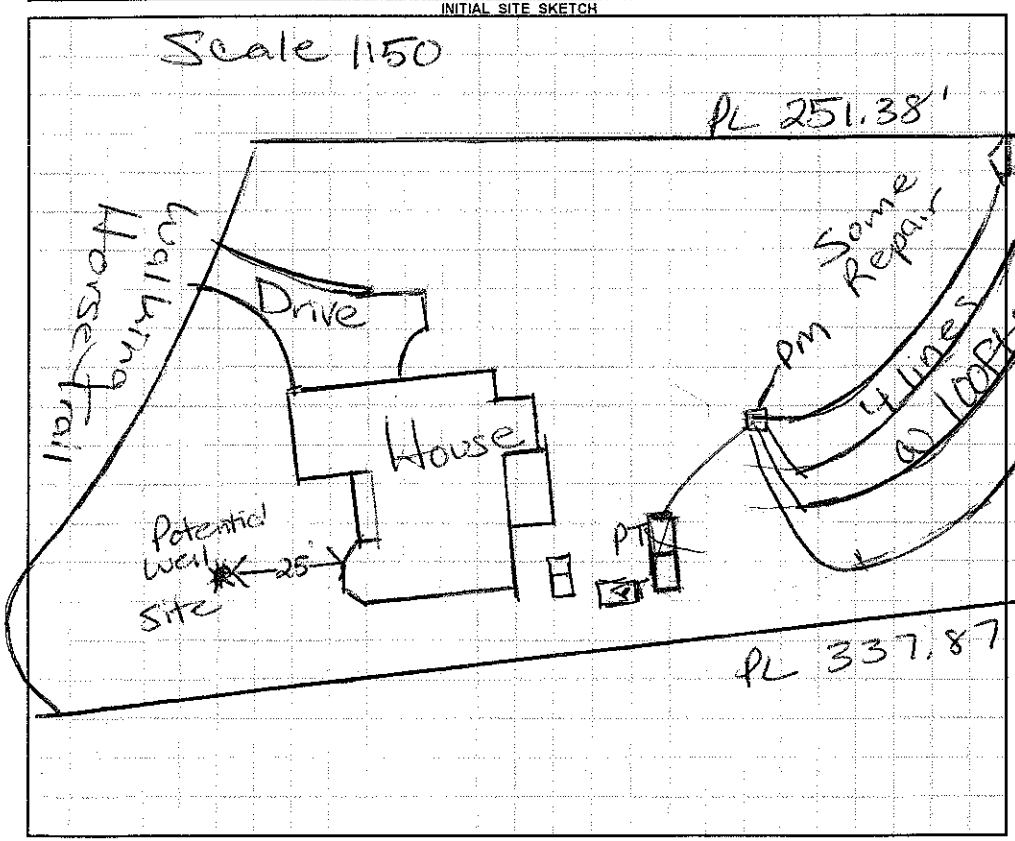

AS BUILT SKETCH

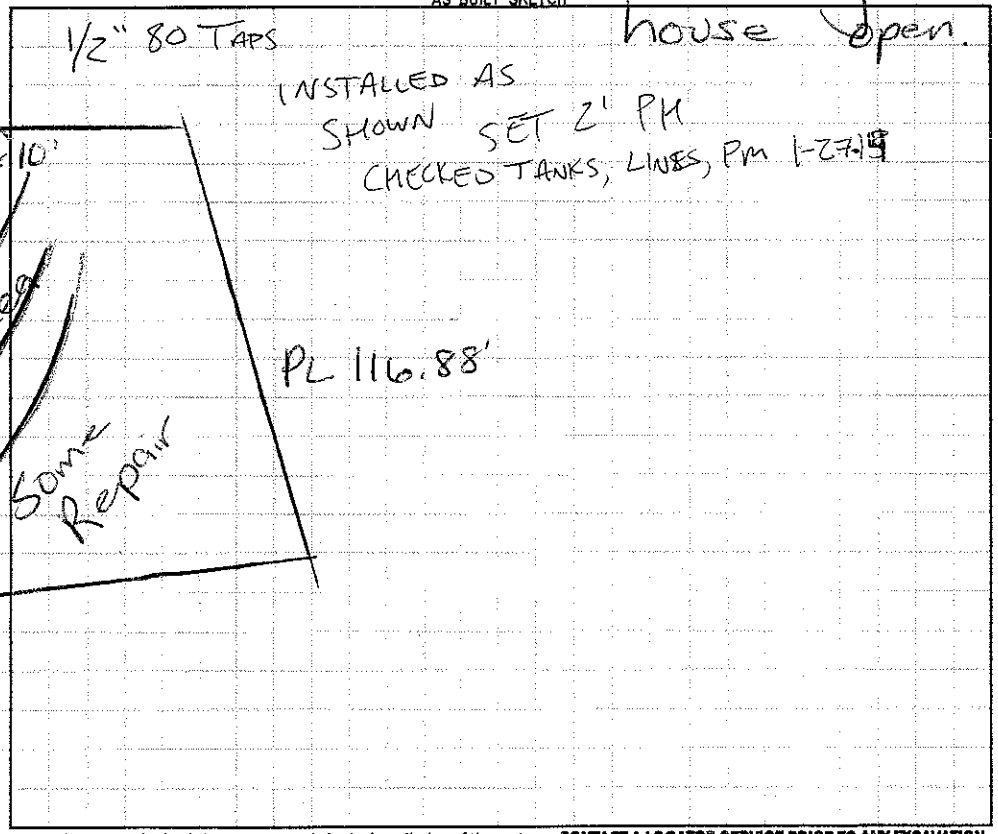

Permit can be suspended or revoked if any false information is supplied toward securing the permit / any unauthorized changes are made to the site / any unauthorized changes are made in the installation of the system. **CONTACT A LOCATOR SERVICE PRIOR TO ANY EXCAVATION**

☐ **IMPROVEMENT PERMIT** *with plat valid without expiration* ☒ **IMPROVEMENT PERMIT** *with site plan valid for 60 mos.* ☒ **AUTHORIZATION TO CONSTRUCT** *valid for period equal to IMPROVEMENT PERMIT--not to exceed 60 mo.*

Owner / Applicant Signature: David Dillard Date: 9-10-13 Installed by: ORBISON

IMPROVEMENT PERMIT by: RS Date: 9/6/13 OPERATION PERMIT by: Date:

AUTHORIZATION TO CONSTRUCT by: RS Date: 9/6/13 Existing System Inspected by: Date:

APPROVED FEB 21 2014

Health Dept. Copy - WHITE Applicant (Final Approval) - YELLOW Applicant (Conditional Approval) - PINK