4664-76-2872

IREDELL COUNTY HEALTH DEPARTMENT

STATESVILLE 704-878-5305 MOORESVILLE 704-664-5281

IMPROVEMENT PERMIT / AUTHORIZATION TO CONSTRUCT / OPERATION PERMIT / EXISTING SYSTEM INSPECTION

PERMIT# 142153 PIN# ~~4664-76-7977-0000~~ DATE 2-11-08

OWNER OR APPLICANT James Moore / Blue Ridge PHONE: Business 782-6216 Home

ADDRESS 1007 Central Dr Concord NC 28027

LOCATION Shearers Rd TL Anniston Way TR Burnett Place TL Walking Horse on Rt.

SUBDIVISION Anniston BLOCK / SECTION LOT 63 LOT AREA .73 Acre SITE CLASS PS DESIGN FLOW 480gpd L.A.R. 1.3

Septic Tank: 1000 Gallons; STB 794 Date 8/19/07

Pump Tank: 1000 Gallons; PT 1083 Date 7/20/08

Pump Make: Goulds Model WC0312MU Serial No. #08B898

Nitrification Field: No Fields 1 Square Feet 510 Linear Feet 285

No Lines 5 Trench Width 24" min Max Trench Bottom Depth 36" Gravel Depth N/A

☒ New System ☐ Repair ☐ Expansion System Type: I II III IV V VI

System Description: Pump – LP – Panel Blk

Repair System Description: Same

Maintenance Agreement Required: ☒ Yes ☐ No

☒ House/Mod. Home No. Bedrooms 4

☐ Mobile Home No. Persons

☐ Business No. Employees

☐ Other


Water Supply: ☒ Individual ☐ Public ☐ Community

☐ Gravity ☒ Pressure ☐ Slab ☒ Crawl Space ☐ Basement w/plumbing ☐ Basement wo/plumbing

Comments:/Conditions: ☒ Must keep Pool 15ft from Septic System

Comments:/Conditions: ☒ Use Inline Filter in PT

INITIAL SITE SKETCH Scale 1:50

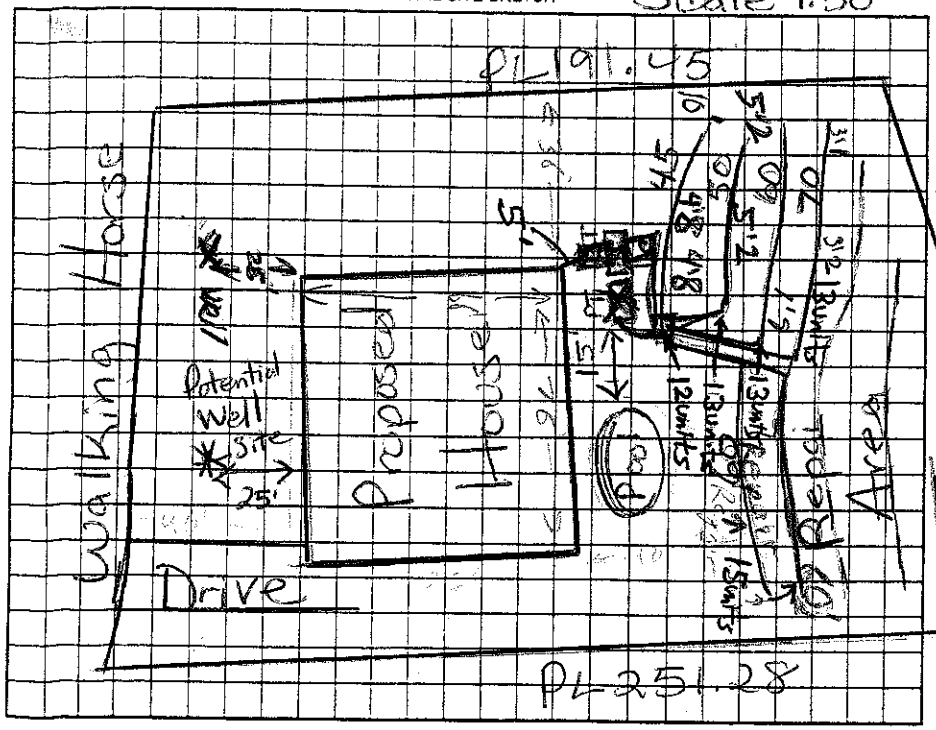

AS BUILT SKETCH

System Installed as shown w/ changes documented

Permit can be suspended or revoked if any false information is supplied toward securing the permit/any unauthorized changes are made to the site/any unauthorized changes are made in the installation of the system. Improvement Permit with plat valid without expiration ☐ Improvement Permit with site plan valid for sixty months ☐

Authorization to Construct is valid for a period equal to that of Improvement Permit – not to exceed sixty months.

Signed: date 3/7/08

Improvement Permit by: Maria H. Nolan RS date 2/11/08

Authorization to Construct by: Maria H. Nolan RS date 2/11/08

Installed by: A-1 Backhoe

Operation Permit by: Judy Melville date 1-27-09

Existing System Inspection by: date

HEALTH DEPT. COPY: WHITE OWNER COPY (FINAL): YELLOW OWNER COPY (INITIAL): PINK