IREDELL COUNTY HEALTH DEPARTMENT

Statesville Office (704) 878-5305 Mooresville Office (704) 660-3625 PERMIT # 210453

IMPROVEMENT PERMIT / AUTHORIZATION TO CONSTRUCT / OPERATION PERMIT / EXISTING SYSTEM

PIN # 7664772911

APPLICANT: BLUTO BUILDERS APPLICANT ADDRESS: 17005 GREEN DOLPHIN LN CORNELIUS NC

SITE ADDRESS: 117 WALKING HORSE TR - Davidson PHONE: ALT. PHONE:

SITE DIRECTIONS: SHEARERS (S) - TL ANNISTON WAY - TR BURNELL

SUBDIVISION: ANNISTON SECTION: 2 LOT # 62 LOT AREA: 2.07AC DESIGN FLOW: 600 L.T.A.R.: .25

Septic Tank	1500 (gal)	STB	964	Date	8/13/16	☑ New System ☐ Repair ☐ Expansion	System Type: I II III IV V VI	☑ Residence	No. Bedrooms 5
Pump Tank	(gal)	PT		Date		System Description:	25% REDUCTION	☐ Business	No. Persons 10
Pump Make		Model		Serial #		Repair System Description:	DRIP	☐ Other	No. Employees
# Nitrification Fields	1	# Lines	6	Linear Ft:	600	Maintenance Agreement Required: ☐ YES ☑ NO		☐ Slab	☐ Crawl Space
Trench Width	36"	Max. Trench Bottom Depth	24"	Gravel Depth	N/A	☑ GRAVITY ☐ PRESSURE		☑ Basement w/plumbing	☐ Basement w/o plumbing

Water Supply: ☑ Private ☐ Public ☐ Community

Comments / Conditions:

SMOOTH SUPPLY LINE ROUTE TO ACHIEVE UNIFORM FALL OR SYSTEM WILL BE PUMPED

INITIAL SITE SKETCH

See Michael Athanas & Associates Design

RECOMMEND INSTALLING LINES BEFORE TANK & DISTRIBUTION

AS BUILT SKETCH

Permit can be suspended or revoked if any false information is supplied toward securing the permit / any unauthorized changes are made to the site / any unauthorized changes are made in the installation of the system. **CONTACT A LOCATOR SERVICE PRIOR TO ANY EXCAVATION**

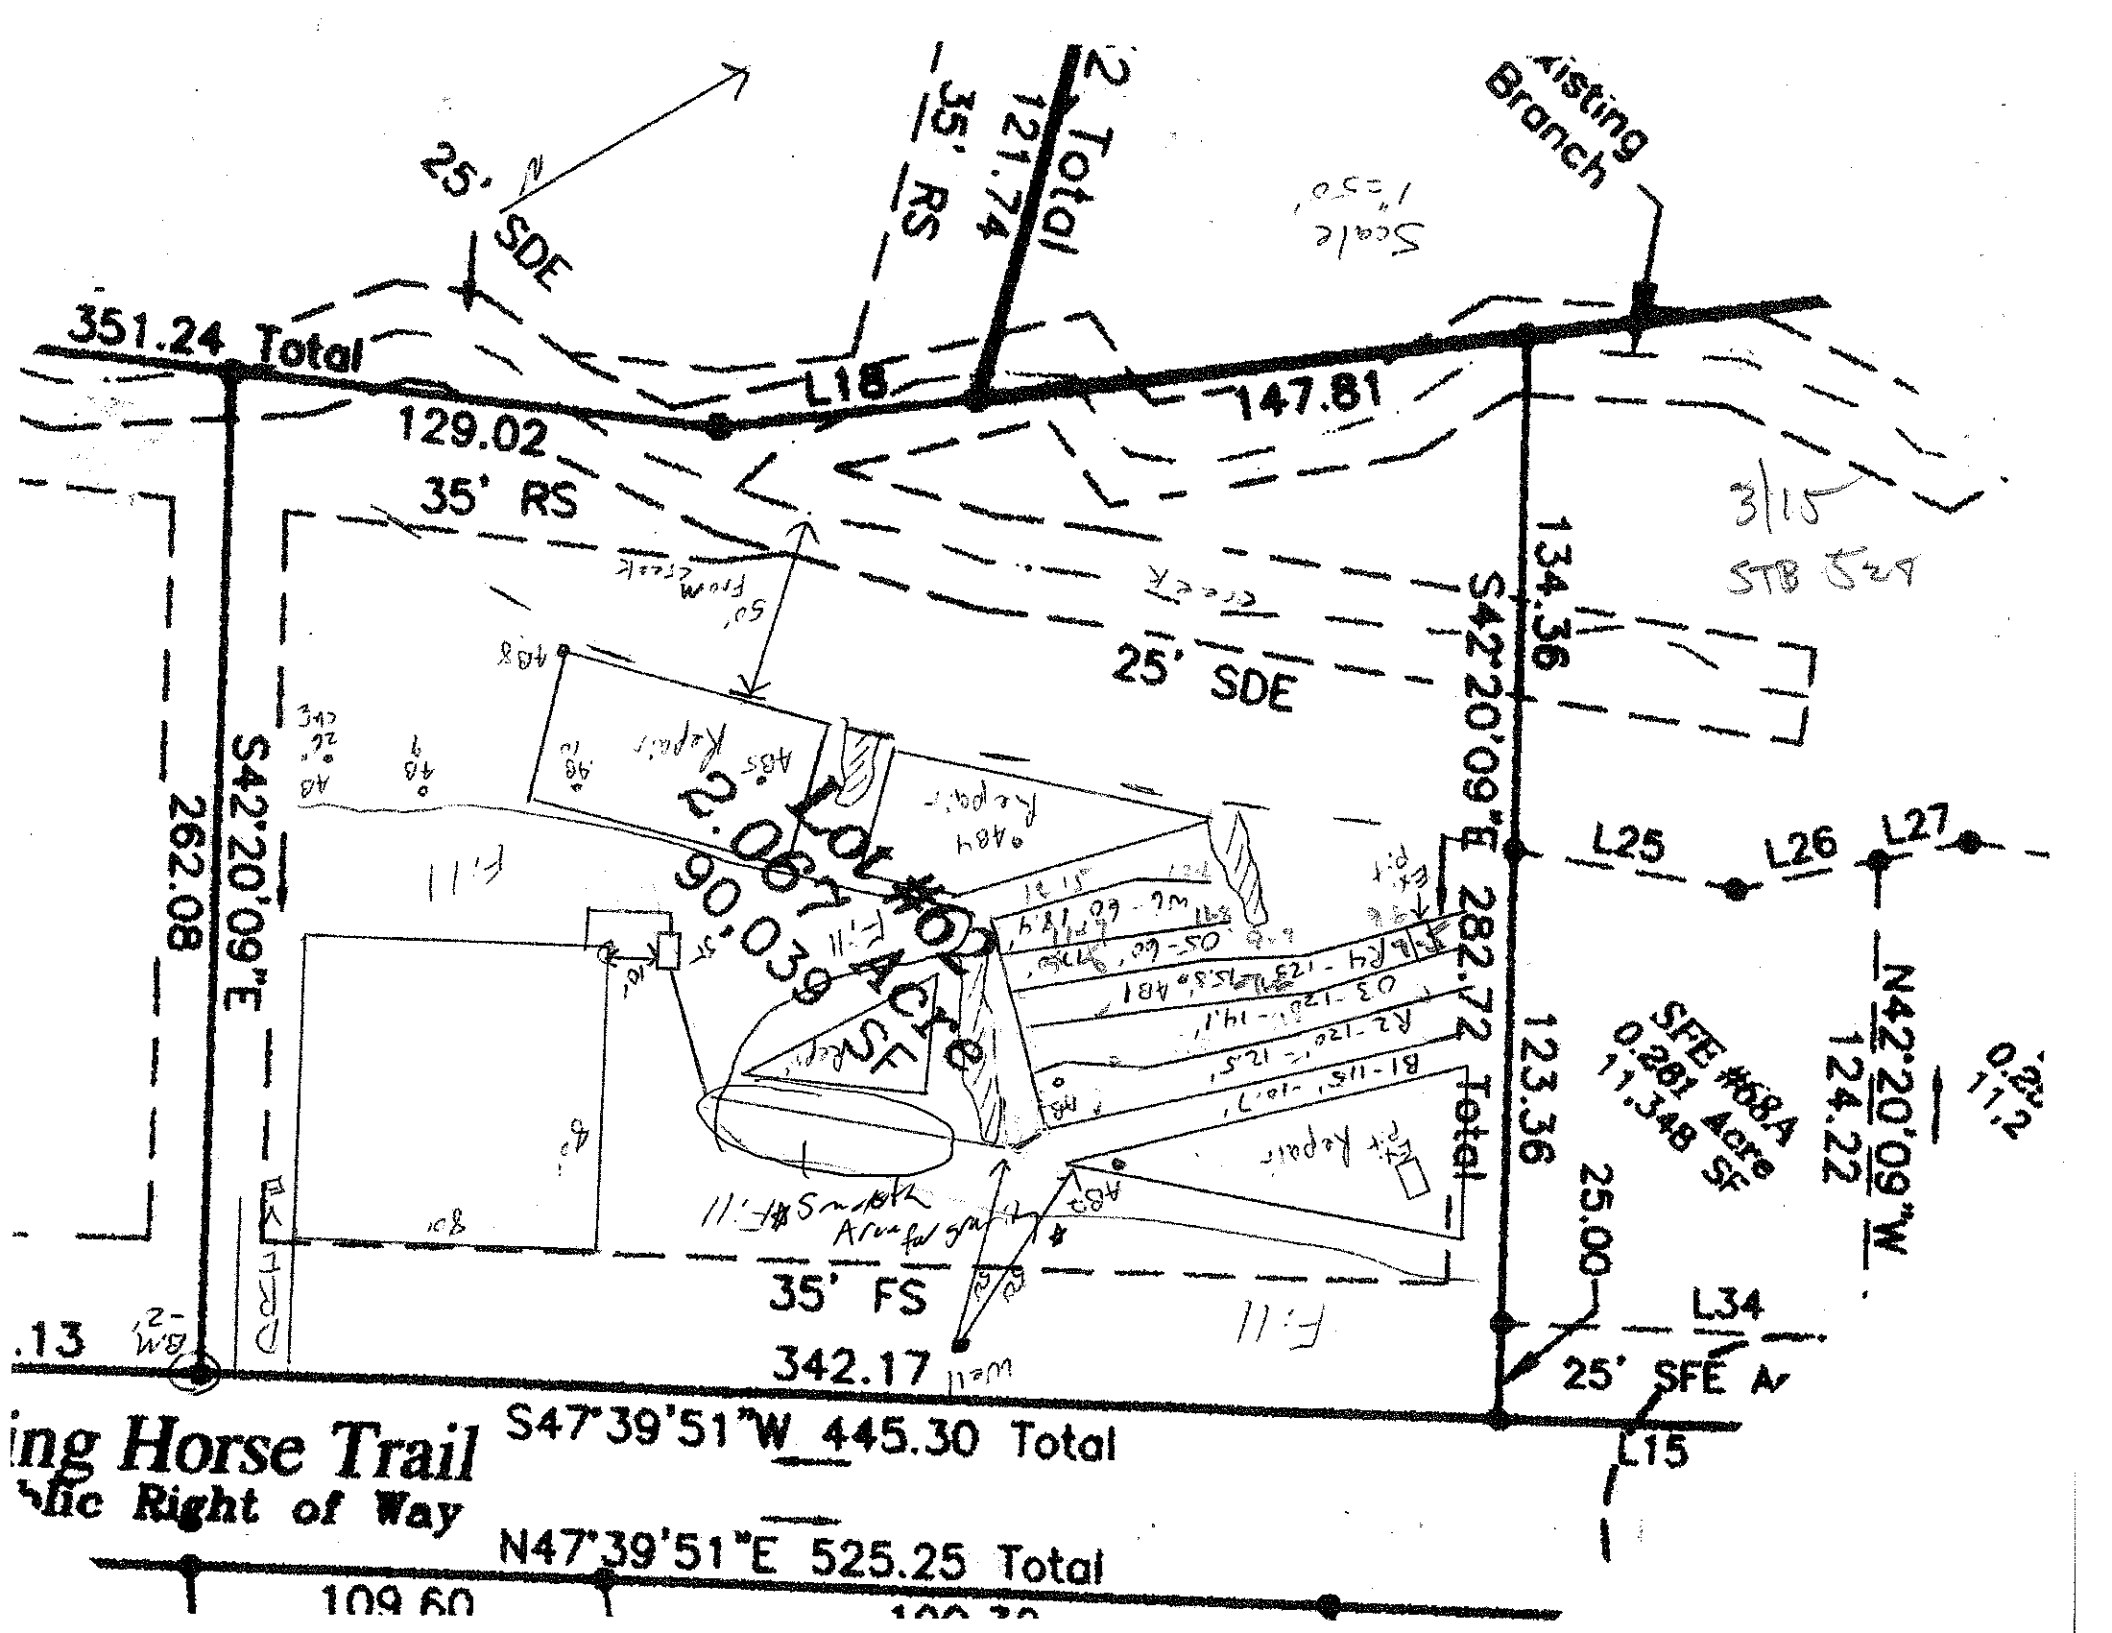
☐ **IMPROVEMENT PERMIT** *with plat valid without expiration.* ☑ **IMPROVEMENT PERMIT** *with site plan valid for 60 mos.* ☑ **AUTHORIZATION TO CONSTRUCT** *valid for period equal to IMPROVEMENT PERMIT--not to exceed 60 mo.*

Owner / Applicant Signature: Date: 9/28/16 Installed by: Craig Thompson

IMPROVEMENT PERMIT by: Date: 9/26/16 OPERATION PERMIT by: Wesley Sparks Date: 10/28/16

AUTHORIZATION TO CONSTRUCT by: Date: 9/26/16 Existing System Inspected by: Date:

Health Dept. Copy - WHITE Applicant (Final Approval) - YELLOW Applicant (Conditional Approval) - PINK


25' SDE
35' RS
121.74 Total
Existing Branch
351.24 Total
L18
147.81
129.02
35' RS
134.36
S42°20'09"E
25' SDE
262.08
S42°20'09"E
LOT #02
2.067 ACRE
90,039 SF
282.72 Total
L25
L26
L27
N42°20'09"W
124.22
SFE #68A
0.261 Acre
11,348 SF
123.36
25.00
L34
25' SFE
35' FS
342.17
S47°39'51"W 445.30 Total
L15
ing Horse Trail
blic Right of Way
N47°39'51"E 525.25 Total
109.60