IREDELL COUNTY HEALTH DEPARTMENT

STATESVILLE 704-878-5305 MOORESVILLE 704-664-5281

IMPROVEMENT PERMIT / AUTHORIZATION TO CONSTRUCT / OPERATION PERMIT / EXISTING SYSTEM INSPECTION

$315.00-Paid 11:30

PERMIT# 136819 PIN# 4664678995.055 4664-77-3724 DATE October 19, 2006

OWNER OR APPLICANT Anniston LLC / Stonebridge Croft PHONE: Business _____ Home _____

ADDRESS 17824 Statesville Rd / Suite 112, Cornelius, N.C. 28031

LOCATION Shearers Rd (S) TL Anniston Way at End

SUBDIVISION Anniston BLOCK / SECTION 2 LOT 33 LOT AREA 2.37Ac + 14,321 SF SITE CLASS. PS SFE DESIGN FLOW 480 gpd L.T.A.R. .03

Septic Tank: 1000 Gallons; STB 194 Date 2-12-08
Pump Tank: 1000 Gallons; PT 27 Date 10-2-07
Pump Make: Myers Model D102 Serial No. _____
Nitrification Field: (No) Fields 1 Square Feet 1200 Linear Feet 400
No Lines 3 Trench Width 36" Max Trench Bottom Depth 36"

☒ New System ☐ Repair ☐ Expansion System Type: I II (IIIB) IV V VI
System Description: pm 25% Reduction
Repair System Description: LP PPBBS
Maintenance Agreement Required: ☐ Yes ☒ No
Gravel Depth NA ☐ Gravity ☒ Pressure ☐ Slab ☒ Crawl Space ☒ Basement w/plumbing ☐ Basement wo/plumbing

☒ House/Mod. Home No. Bedrooms 4
☐ Mobile Home No. Persons ____
☐ Business No. Employees ____
☐ Other ____

Water Supply: ☒ Individual ☐ Public ☐ Community

Comments:/Conditions: 9/25/08 Checked lines Q4
Okay for more tanks uphill slightly.

Comments:/Conditions: * Change to Basement with plumbing maintain basement setbacks with Tanks. 10/18/07 A.C.
Lines = 132' 136' 132' 6/11/08 Tanks Checked

INITIAL SITE SKETCH

SEE PLAN from Rollins Soil & Env. Services

AS BUILT SKETCH

Plans show 3 BR with room to add 1 more in the future. 10/18/07 A.C.

Permit can be suspended or revoked if any false information is supplied toward securing the permit/any unauthorized changes are made to the site/any unauthorized changes are made in the installation of the system. Improvement Permit with plat valid without expiration ☐ Improvement Permit with site plan valid for sixty months ☒ Authorization to Construct is valid for a period equal to that of Improvement Permit – not to exceed sixty months.

Signed: Shon Oakley date 10-24-06

Improvement Permit by: _____ date 10-19-06


Authorization to Construct by: Anthony Cohen date 10-18-07

Installed by: _____

Operation Permit by: Marion Blackwelder RS date 8/13/08

Existing System Inspection by: _____ date _____

HEALTH DEPT. COPY: WHITE OWNER COPY (FINAL): YELLOW OWNER COPY (INITIAL): PINK

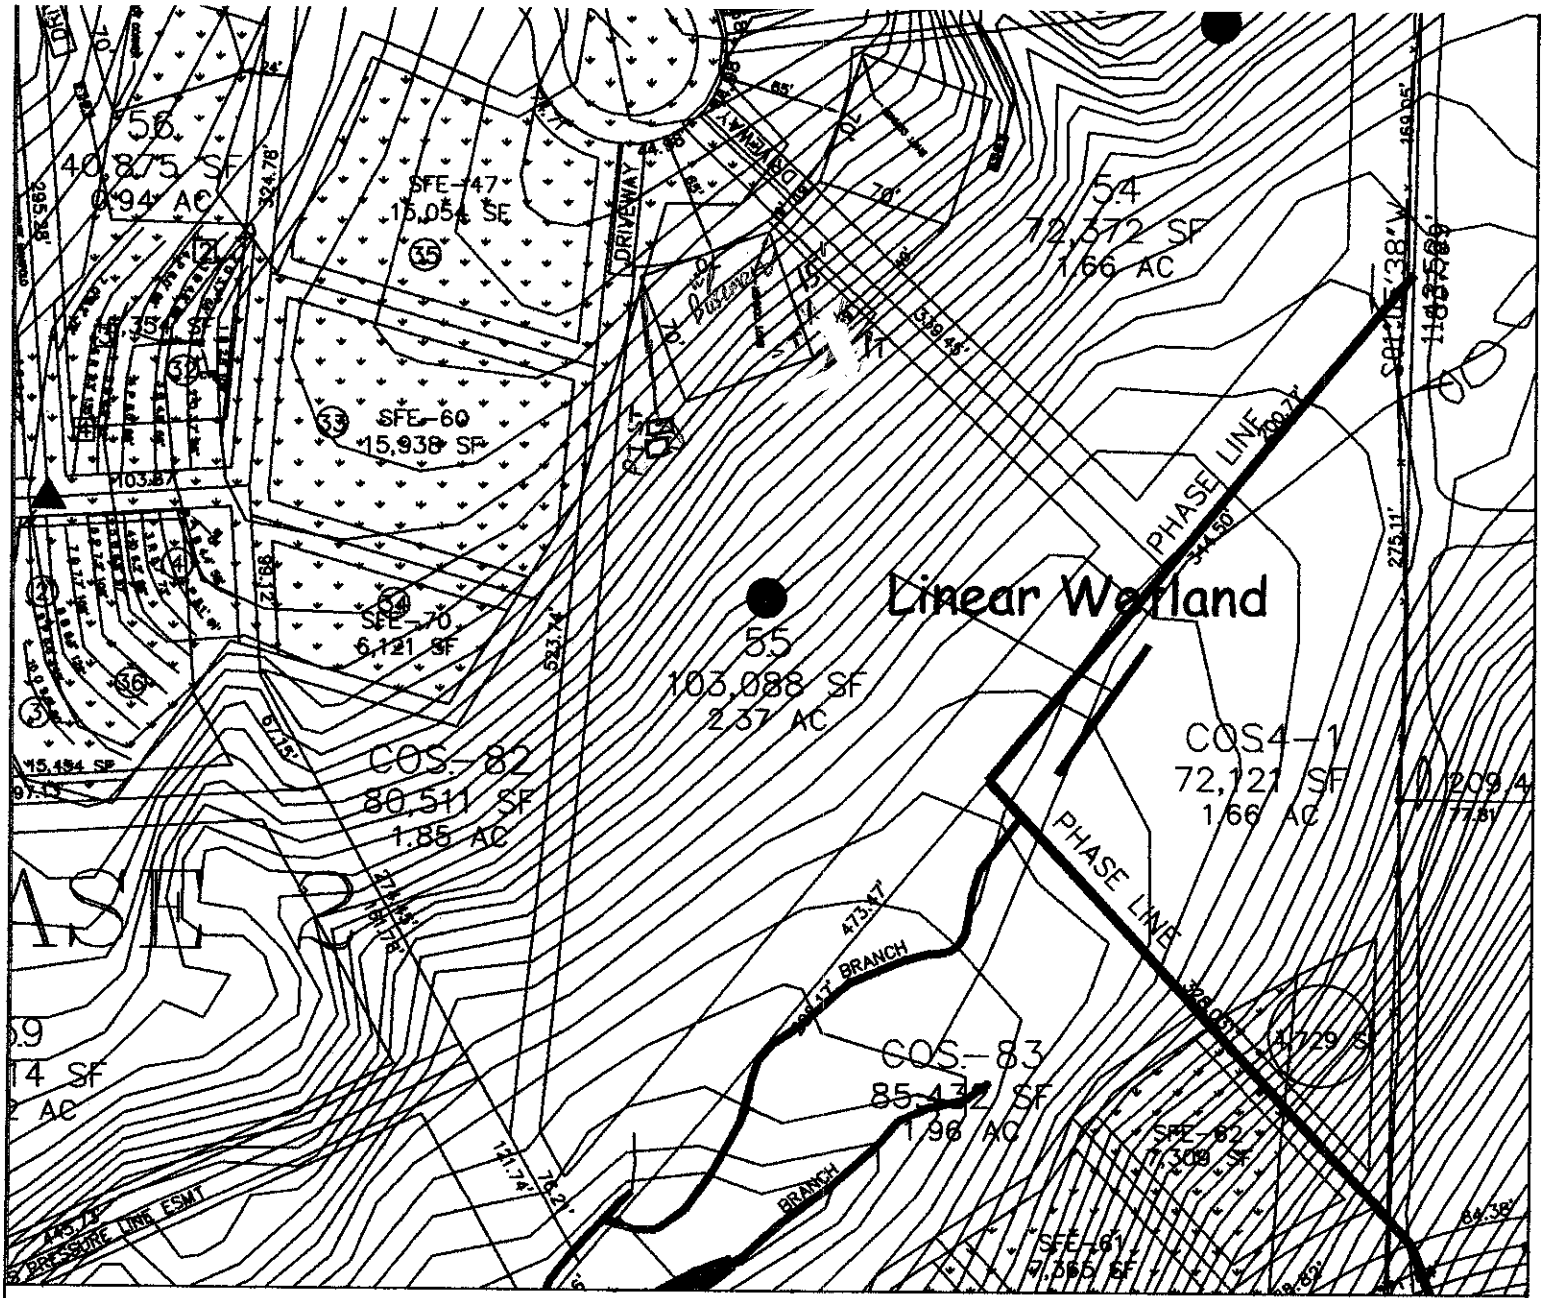

LEGEND

- Areas contain soils with 24 inches or more of useable material and have potential for conventional, modified conventional and low-pressure pipe (lpp) septic systems.
- House Footprint (All 70' x 70')
- System lines.
- Repair lines.
- TBM.
- (25) RS&ES Pit Location.
- Well Location.
- [28] Health Dept. Pit Location.

GRAPHIC SCALE
1" = 100'

100 0 100 200

FOR PRELIMINARY PLANNING PURPOSES ONLY. ALL LOTS WILL REQUIRE FINAL APPROVAL BY THE COUNTY HEALTH DEPARTMENT ON A LOT BY LOT BASIS. THIS MAP SHOULD BY USED AS A GENERAL GUIDE, SOME ADJUSTMENTS WILL BE NECESSARY IN THE FIELD DUE TO SOIL VARIABILITY AND COMPLEX TOPOGRAPHIC FEATURES.
THIS MAP ONLY REFLECTS EXISTING SOIL SUITABILITY FOR ON-SITE SEPTIC TANK SYSTEMS.

PLEASE REFER TO ATTACHED SOIL REPORT FOR ADDITIONAL SITE SPECIFIC INFORMATION

ROLLANS SOIL & ENVIRONMENTAL SERVICES
2129 GRAHAM ROAD
MOUNT ULLA, NC 28125
PHONE/FAX: (704) 278-0989
ASHLEY ROLLANS, NC LICENSED SOIL SCIENTIST
MOBILE: (704) 746-5046
EMAIL: ROLLANSFORTC@AOL.COM

MAP TITLE: SITE PLAN & DRAINFIELD AREAS

PROJECT NAME: ANNISTON, LLC. / ANNISTON PHASE II

LOCATION/DATE: SHEARER CHAPEL ROAD, IREDELL COUNTY, NORTH CAROLINA, JULY 2008

JOB # : 01-1005
FILE: C:\JOBS\01-1005
PROJECT MGR.: S.A.R.
FIELD WORK: S.A.R.
DRAWN BY: S.A.R.