Visit www.DAGmarketplace.com for information on interior and exterior products for your home!

WINDOW SCHEDULE

SYMBOL ☐

MARK	SIZE	QUAN.	DESCRIPTION
A	3'-0" x 4'-6"	1	D.H.
B	3'-0" x 5'-2"	2	D.H. ARCH HEAD
C	2'-0" x 6'-2"	6	D.H.
D	(2) 3'-0" x 6'-2"	3	D.H., W/ 10" ARCH HEAD TRANSOM *
E	(2) 2'-0" x 5'-2"	2	D.H., W/ 24" TRANSOM *
F	2'-0" x 4'-6"	1	D.H.
G	1'-8" x 5'-2" 2'-8" x 5'-2" 1'-8" x 5'-2"	2	D.H., W/ 2'-2" ARCH HEAD TRANSOM *
H	2'-0" x 5'-10" 3'-0" x 5'-10" 2'-0" x 5'-10"	1	D.H., W/ 2'-2" ARCH HEAD TRANSOM *
J	2'-8" x 4'-6" 3'-0" x 4'-6" 2'-0" x 4'-6"	1	D.H., W/ 1'-2" ARCH HEAD TRANSOM *
K	2'-8" x 5'-2" 3'-0" x 5'-2" 2'-0" x 5'-2"	1	D.H.
L	3'-0" x 4'-6"	1	D.H., ARCH HEAD
M	1'-5" x 3'-5"	3	FIXED CASEMENT, ARCH HEAD

ALL WINDOWS ARE INSULATED AND WEATHERSTRIPPED.

VERIFY LOCAL CODE EGRESS WINDOW REQUIREMENTS PRIOR TO CONSTRUCTION.


WINDOW MANUFACTURER TO PROVIDE TEMPERED GLASS WHERE REQUIRED BY CODE.

VERIFY WINDOW MODEL NUMBERS AND SIZES WITH MANUFACTURER BEFORE STARTING CONSTRUCTION.

* SEE ELEVATION FOR TRANSOM.

ELECTRICAL LEGEND

SYMBOL	DESCRIPTION
	DUPLEX OUTLET (GROUNDED TYPE)
WP	WEATHER PROOF DUPLEX OUTLET
AC	ABOVE COUNTER LOCATION
FL	FLUSH FLOOR DUPLEX OUTLET, OWNER VERIFY LOCATION
220	220 VOLT OUTLET OR CONNECTION
	CEILING MOUNTED LIGHT FIXTURE
	WALL BRACKET MOUNTED LIGHT FIXTURE
	SUSPENDED CEILING MOUNTED LIGHT FIXTURE
	RECESSED DIRECTIONAL CEILING LIGHT FIXTURE
	RECESSED CEILING LIGHT FIXTURE
W	RECESSED LIGHT FOR WET AREA
	UNDER CABINET FLUORESCENT LIGHT
	EXTERIOR CAST ALUMINUM FLOOD LIGHTS
	CEILING MOUNTED PADDLE FAN W/ LIGHT
	CEILING MOUNTED FAN - EXHAUST
	CEILING MOUNTED FAN AND HEATER
	CEILING MOUNTED FAN AND LIGHT

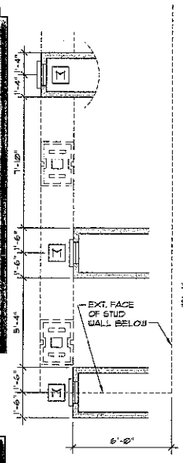

DORMER PLAN
1/4" = 1'-0"

PLAN NOTES:

1. VERIFY ALL LOCAL CODES, ENERGY TYPES, AND SITE CONDITIONS PRIOR TO CONSTRUCTION. THE OWNER AND BUILDER SHALL BE SOLELY RESPONSIBLE FOR CODE COMPLIANCE.
2. REVIEW SELECTED MECHANICAL SYSTEMS WITH OWNER PRIOR TO CONSTRUCTION.

   REVIEW SUB-CONTRACTORS LOCATIONS OF THE WATER HEATERS AND HVAC UNIT(S) WITH THE OWNER PRIOR TO CONSTRUCTION. ENSURE COMPLIANCE WITH LOCAL BUILDING CODE REQUIREMENTS AND MANUFACTURER REQUIREMENTS.


   H.V.A.C. EQUIPMENT IN THE ATTIC SPACE SHALL BE ACCESSIBLE BY AN OPENING LARGER THAN THE LARGEST PIECE OF EQUIPMENT (TO ALLOW REMOVAL OF THE EQUIPMENT) AND IN NO CASE LESS THAN 22"X36".
3. SEE STRUCTURAL DRAWINGS FOR ADDITIONAL INFORMATION.
4. INSULATE AROUND ALL BATHS AND UTILITY ROOM.
5. TYPICAL WALL, 2x4'S @ 16" O.C. UNLESS OTHERWISE DIMENSIONED.
6. PROVIDE SMOKE DETECTORS AS REQUIRED BY CODE.
7. PROVIDE DOORBELLS, TRANSFORMER, AND CHIME.

DOOR SCHEDULE

SYMBOL ◯

MARK	SIZE	QUAN.	DESCRIPTION
1	3'-0" x 6'-8"	1	EXT.,FULL GLASS W/ 20" SIDELITES & 2'-4" ARCH HEAD TRANSOM *
2	(2) 3'-0" x 6'-8"	1	EXT., FULL GLASS W/ 2'-4" ARCH HEAD TRANSOM *
3	9'-0" x 8'-0"	2	GARAGE
4	2'-8" x 6'-8"	1	EXT., 1 HOUR FIRE-RATED
5	2'-8" x 6'-8"	7	INT.
6	2'-4" x 6'-8"	9	INT.
7	2'-8" x 6'-8"	1	SCREEN
8	2'-6" x 6'-8"	1	INT.
9	(2) 2'-0" x 6'-8"	2	INT.
10	(2) 1'-6" x 6'-8"	1	INT.
11	2'-4" x 6'-8"	2	INT. POCKET DOOR

* SEE ELEVATION FOR TRANSOM.

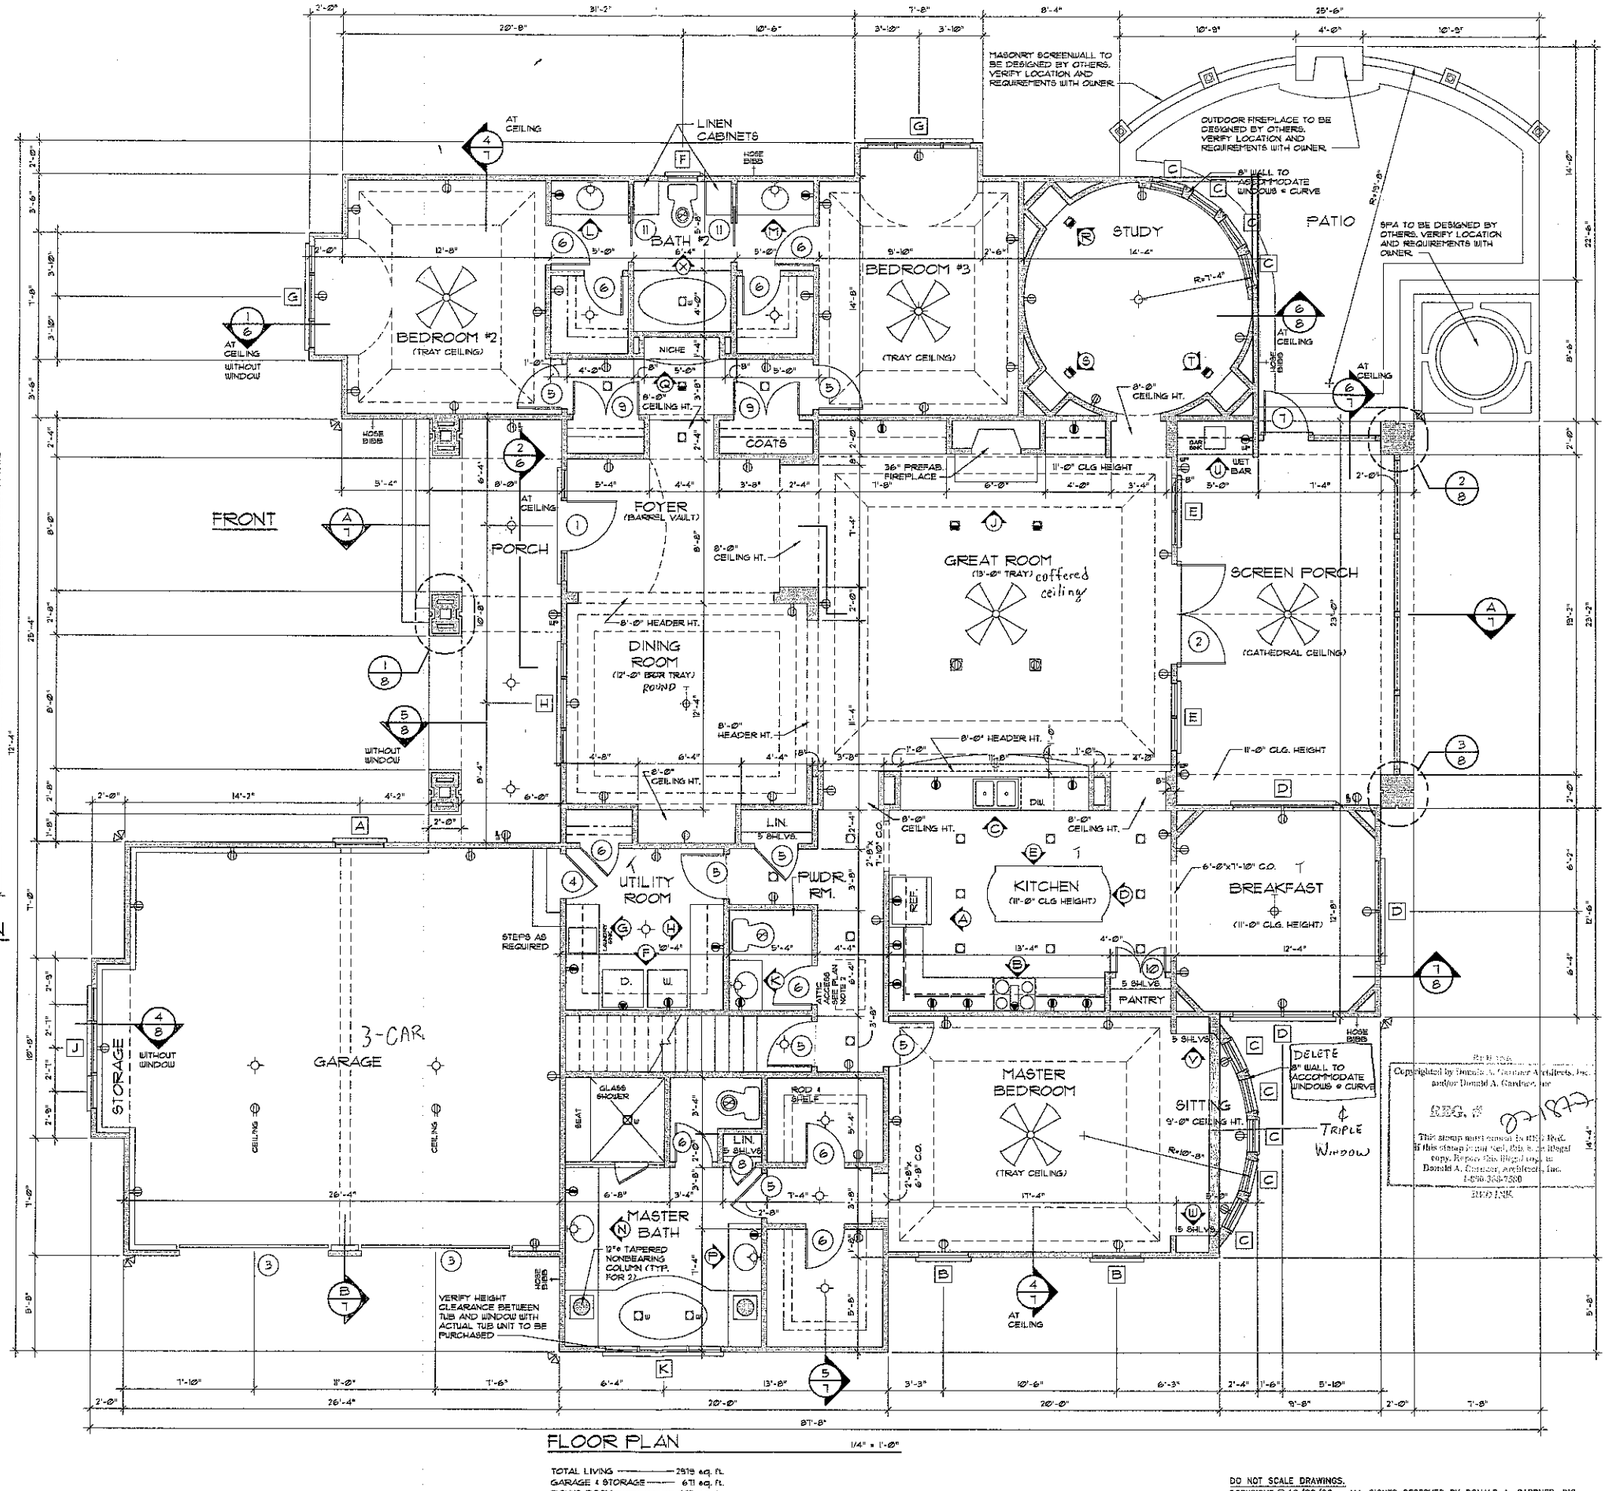

FLOOR PLAN
1/4" = 1'-0"

TOTAL LIVING ——— 2513 sq. ft.
GARAGE + STORAGE ——— 671 sq. ft.
BONUS ROOM ——— 403 sq. ft.

Revised
Copyrighted by Donald A. Gardner Architects, Inc. and/or Donald A. Gardner, Inc.
DRWG. # 03-1877
This stamp must appear in RED Ink. If this stamp is not Red, this is an illegal copy. Release this Illegal copy to Donald A. Gardner, Architects, Inc. 1-800-388-7580
RED INK

ALL FEDERAL, STATE, AND LOCAL CODES, ORDINANCES, REGULATIONS AND MANUFACTURER'S INSTRUCTIONS ETC. SHALL BE CONSIDERED AS PART OF THE SPECIFICATIONS FOR THIS BUILDING AND SHALL TAKE PRECEDENCE OVER ANYTHING SHOWN, DESCRIBED, OR IMPLIED WHERE SAME ARE AT VARIANCE. THESE PLANS ARE NOT DRAWN FOR ANY PARTICULAR LOCALE. YOU ARE RESPONSIBLE FOR DETERMINING AND ENSURING COMPLIANCE WITH ALL APPLICABLE CODES AND MANUFACTURER'S REQUIREMENTS.


DONALD A. GARDNER, INC.®
ARCHITECTS • PLANNERS®
P.O. BOX 26178 • GREENVILLE S.C. • 29616
864 • 288 • 7580
www.dongardner.com/BP

DESIGN NO. 1186
SHEET OF 3 3
DR DRH
FLOOR PLAN

DO NOT SCALE DRAWINGS.
COPYRIGHT © 10/02/06 ALL RIGHTS RESERVED BY DONALD A. GARDNER, INC.
NOT TO BE COPIED OR REPRODUCED WITHOUT WRITTEN PERMISSION

Visit www.DAGmarketplace.com for information on interior and exterior products for your home!

\\MASTER\DATA\WORK\COMMON\02'S\BP\1186\1186P.DWG 02/01/07 14:29

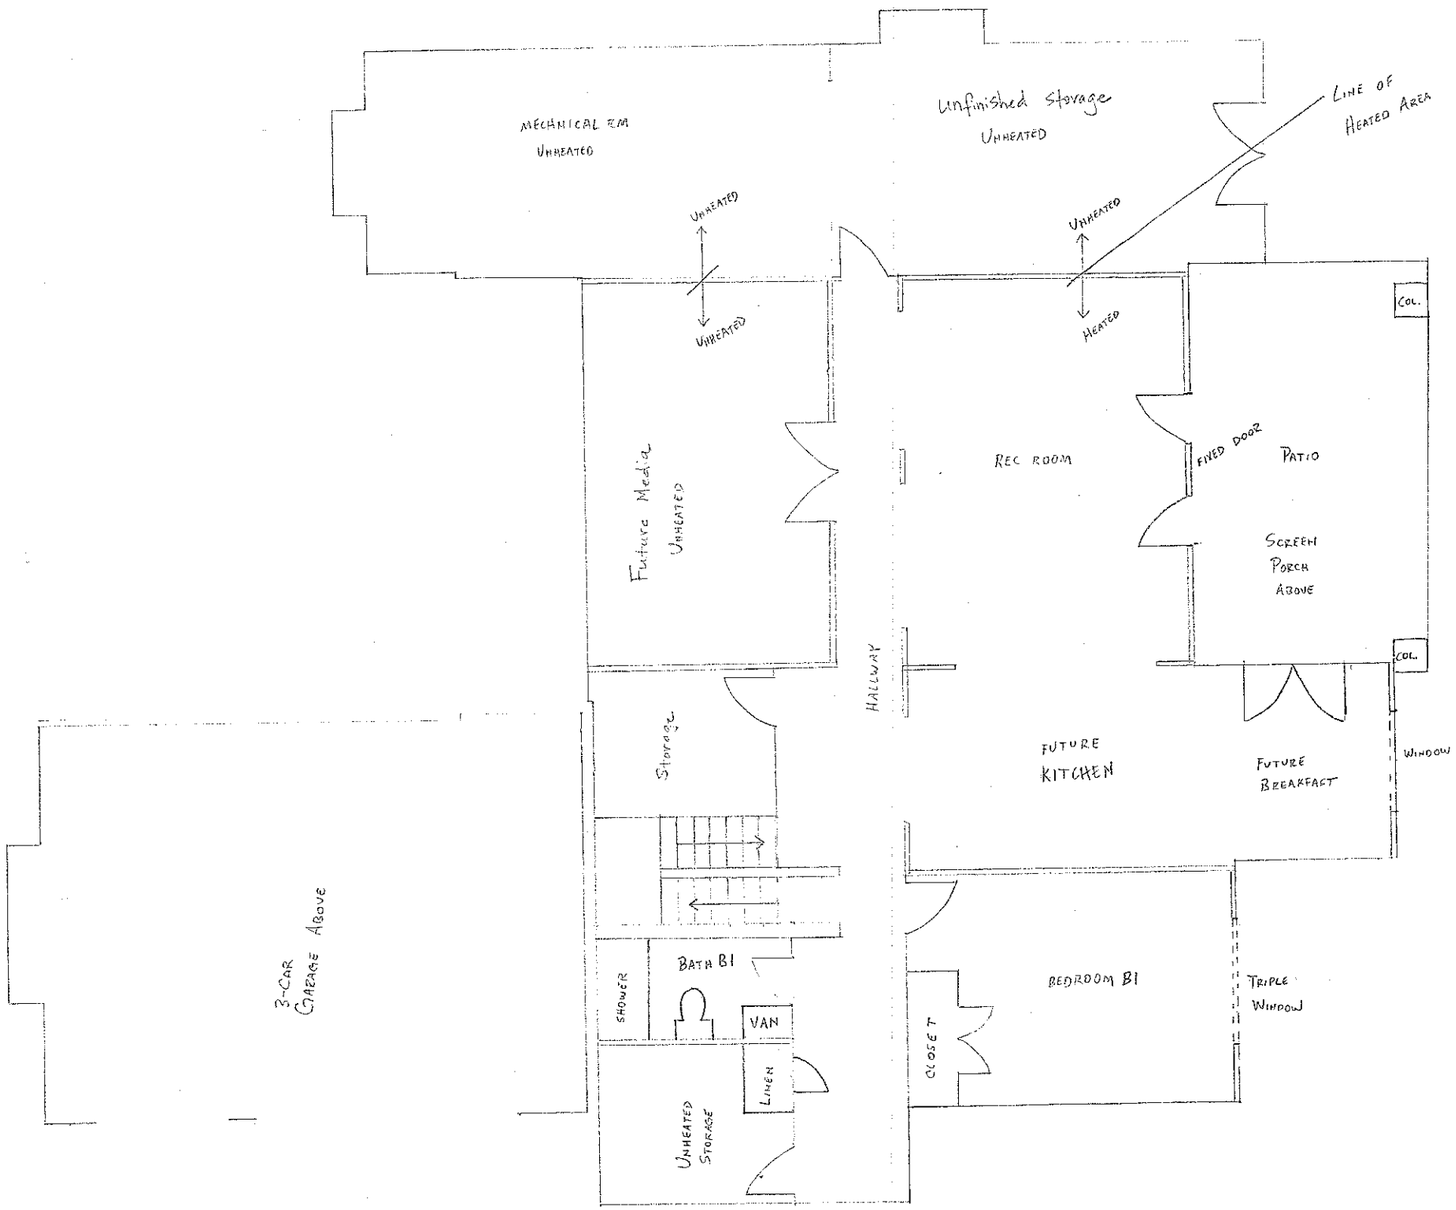

Acknowledgement Of
Plans Submittal ONLY!

_____ Date _____

_____ Date 10/18/07

UNFINISHED

BASEMENT LEVEL 1/4" = 1'-0"

HEATED 1700ft²