12:00, 2:00 206739 (Pool)

IREDELL COUNTY HEALTH DEPARTMENT

STATESVILLE 704-878-5305 MOORESVILLE 704-664-5281

IMPROVEMENT PERMIT / AUTHORIZATION TO CONSTRUCT / OPERATION PERMIT / EXISTING SYSTEM INSPECTION

PERMIT# ~~[illegible]~~ 204242 PIN# ~~4664-68-9747.092~~ 4664780420 DATE Feb 13, 2007

OWNER OR APPLICANT Anniston LLC PHONE: Business _____ Home _____

ADDRESS 17835 Statesville Rd Suite 112, Cornelius, N.C. 28031

LOCATION Sherrills Ford Rd-South TL Anniston Way TL Timberside Dr. 2nd lot on left

SUBDIVISION Anniston BLOCK / SECTION _____ LOT 92 LOT AREA .79Ac. SITE CLASS. PS DESIGN FLOW 480gpd L.T.A.R. .25

Septic Tank: 1000 Gallons; STB _____ Date _____

Pump Tank: 1000 Gallons; PT _____ Date _____

Pump Make: _____ Model _____ Serial No. _____

Nitrification Field: No Fields 1 Square Feet 1005 * Linear Feet 335 *

No Lines 5 Trench Width 36" * Max Trench Bottom Depth 36"

☒ New System ☐ Repair ☐ Expansion System Type: I II III IV V VI

System Description: LPPPBPS

Repair System Description: LPPPBPS

Maintenance Agreement Required: ☒ Yes ☐ No

☒ House/Mod. Home No. Bedrooms 4

☐ Mobile Home No. Persons ____

☐ Business No. Employees ____

☐ Other _____

Water Supply: ☒ Individual ☐ Public ☐ Community

Gravel Depth NA ☐ Gravity ☒ Pressure ☐ Slab ☒ Crawl Space ☐ Basement w/plumbing ☐ Basement wo/plumbing

Comments:/Conditions:

* Per Plans Specs, Subsurface Interceptor Drain Required

Comments:/Conditions:

Maintain 10' Seperation from Interceptor Drain.

INITIAL SITE SKETCH

SEE Plan from Rollins Soil and Env. Services

AS BUILT SKETCH

* Call ICHD if there are any questions for Drainfield placement.

* Use Site Plan Dated 11-7-14


Permit can be suspended or revoked if any false information is supplied toward securing the permit/any unauthorized changes are made to the site/any unauthorized changes are made in the installation of the system. Improvement Permit with plat valid without expiration ☐ Improvement Permit with site plan valid for sixty months ☒ Authorization to Construct is valid for a period equal to that of Improvement Permit – not to exceed sixty months.

Signed: _____ date 2-13-07 Installed by: Rowan Septic

Improvement Permit by: _____ date 2-13-07 Operation Permit by: _____ APPROVED JAN 27 2015 date _____

Authorization to Construct by: _____ APPROVED JUN 30 2014 date _____ Existing System Inspection by: _____ date _____

HEALTH DEPT. COPY: WHITE OWNER COPY (FINAL): YELLOW OWNER COPY (INITIAL): PINK

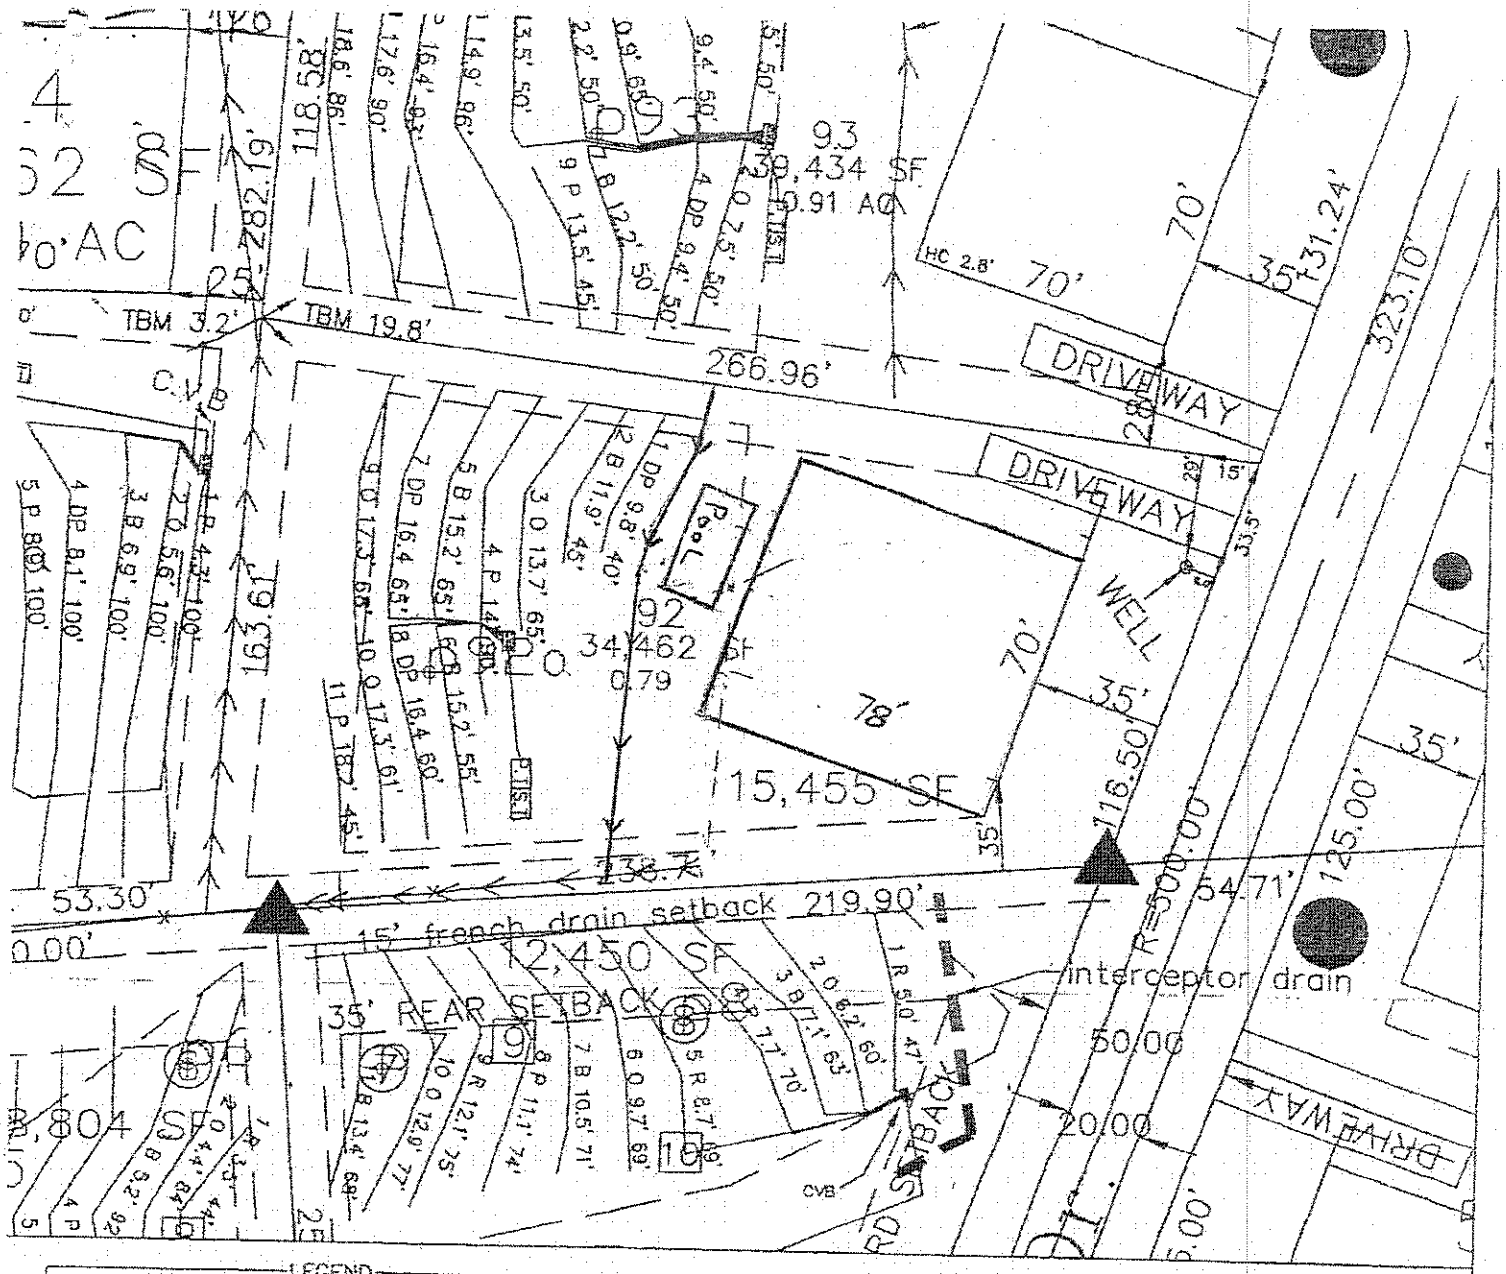

LEGEND

- Areas contain soils with 24 inches or more of useable material and have potential for conventional, modified conventional and low-pressure pipe (lpp) septic systems.
- House Footprint (All 70' x 70')
- System lines.
- Repair lines.
- TBM.
- (25) RS&ES Pit Location.
- Well Location.
- [28] Health Dept. Pit Location.

OK ICHD

APPROVED NOV 07 2014

GRAPHIC SCALE
1" = 50'
50 0 50 100

FOR PRELIMINARY PLANNING PURPOSES ONLY. ALL LOTS WILL REQUIRE FINAL APPROVAL BY THE COUNTY HEALTH DEPARTMENT ON A LOT BY LOT BASIS. THIS MAP SHOULD BY USED AS A GENERAL GUIDE, SOME ADJUSTMENTS WILL BE NECESSARY IN THE FIELD DUE TO SOIL VARIABILITY AND COMPLEX TOPOGRAPHIC FEATURES. THIS MAP ONLY REFLECTS EXISTING SOIL SUITABILITY FOR ON-SITE SEPTIC TANK SYSTEMS.

PLEASE REFER TO ATTACHED SOIL REPORT FOR ADDITIONAL SITE SPECIFIC INFORMATION

ROLLANS SOIL & ENVIRONMENTAL SERVICES
120 GRAHAM ROAD
MOUNT ULLA, NC 28125
PHONE/FAX: (704) 279-0989
ASHLEY ROLLANS, NC LICENSED SOIL SCIENTIST
MOBILE: (704) 746-3046
EMAIL: ROLLANSFORTIC@AOL.COM

MAP TITLE: SITE PLAN & DRAINFIELD AREAS

PROJECT NAME: [illegible]

LOCATION/DATE: SHOWER CHAPEL ROAD, IREDELL COUNTY, NORTH CAROLINA, JULY 2014

JOB #: 61-1005
FILE: C:\JOBS\61-1005
PROJECT MGR.: S.A.R.
FIELD WORK: S.A.R.
DRAWN BY: S.A.R.