Rcd 305.00

IREDELL COUNTY HEALTH DEPARTMENT

ES E 704-878-5305 MOORESVILLE 704-664-5281 3:30 - 4:00

IMPROVEMENT PERMIT / AUTHORIZATION TO CONSTRUCT / OPERATION PERMIT / EXISTING SYSTEM INSPECTION

PERMIT # 136817 PIN # ~~4664-78-7171~~ DATE 11/5/08

OWNER or APPLICANT Bluto Bldrs. 4664-78-7171 PHONE: Business 704-782-6216 Home:

OWNER or APPLICANT ADDRESS 1007 Central Dr. Concord NC 28027

LOCATION / DIRECTIONS Shearers Rd. Th Anniston Way Corner of Timberside on Right

SUBDIVISION Anniston BLOCK / SECTION LOT # 53 LOT AREA .86 DESIGN FLOW 480 L.T.A.R. .275

Septic Tank 1000 Gallons: STB 312 Date 10-29-08
Pump Tank 1000 Gallons: PT 283 Date 9-22-08
Pump Make Goulds Model WE05S12 HHA Serial #
Nitrification Field No Fields 1 No Lines 9 Linear Feet 270'
Trench Width 24" Max. Trench Bottom Depth 36" Gravel Depth N/A

☑ New System ☐ Repair ☐ Expansion System Type I II III IV V VI
System Description: LP-PBPS
Repair System Description: Same
Maintenance Agreement Required ☑ YES ☐ NO
☐ GRAVITY ☐ PRESSURE

☑ Residence No. Bedrooms 4
☐ Business No. Persons
☐ Other No. Employees
☐ Slab ☑ Crawl Space
☐ Basement w/plumbing ☐ Basement w/o plumbing


Water Supply: ☑ Private ☐ Public ☐ Community

Comments / Conditions * Keep drainfield min 15' from Embankment of pool


Comments / Conditions

INITIAL SITE SKETCH

1" = 50'

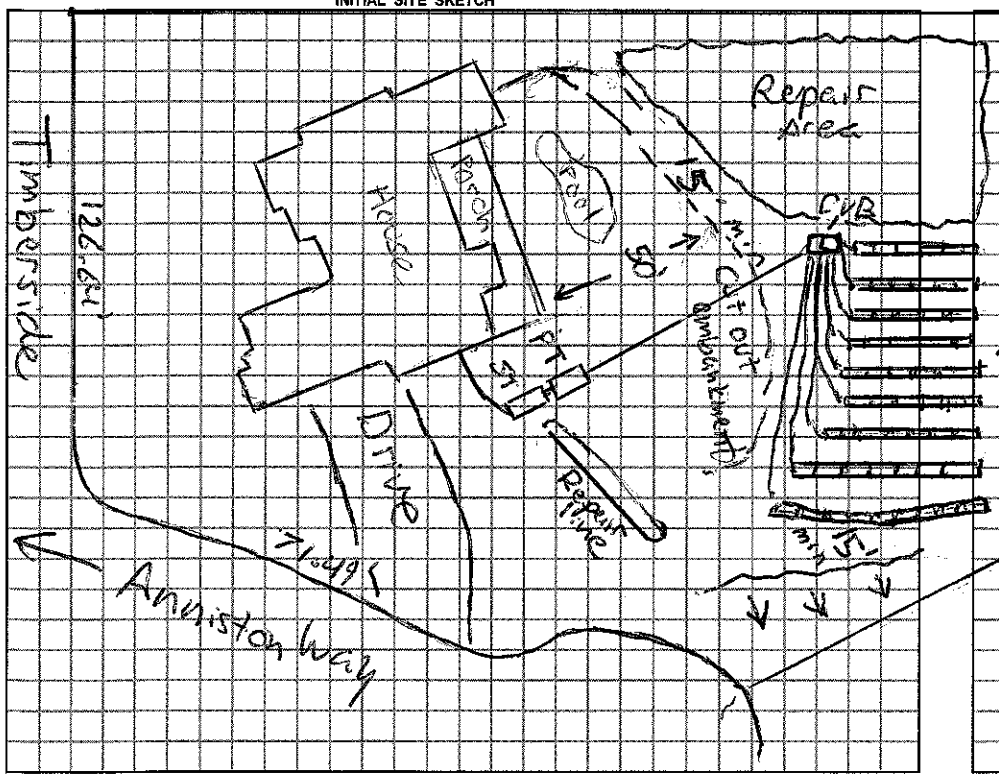

AS BUILT SKETCH

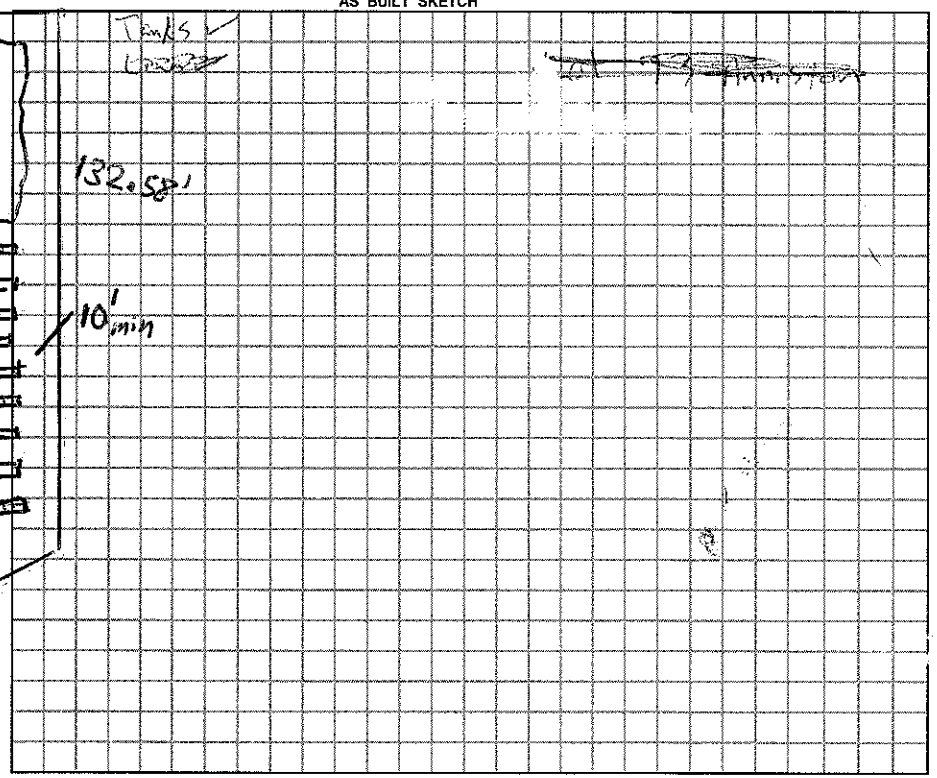

Permit can be suspended or revoked if any false information is supplied toward securing the permit / any unauthorized changes are made to the site / any unauthorized changes are made in the installation of the system.

☐ *IMPROVEMENT PERMIT w / plat valid without expiration.* ☑ *IMPROVEMENT PERMIT w / site plan valid for 60 mos.* ☑ *AUTHORIZATION TO CONSTRUCT valid for period equal to IMPROVEMENT PERMIT-not to exceed 60 mo.*

Owner / Applicant Signature: DENNIS GALLIHER Date 11/12/08

Improvement Permit by: Anthony Cohen R.S. Date 11/5/08

Authorzation to Construct by: Anthony Cohen R.S. Date 11/5/08

YOU SHOULD CONTACT A LOCATOR SERVICE PRIOR TO ANY EXCAVATION.

Installed by: A-1 Backhoe

Operation Permit by: [signature] Date: 1/29/09

Existing System Inspected by: Date:

WHITE COPY Environmental Health YELLOW COPY (Final) Owner / Applicant PINK COPY (Initial) Owner / Applicant