11,600

IREDELL COUNTY HEALTH DEPARTMENT

STATESVILLE 704-878-5305 MOORESVILLE 704-664-5281

IMPROVEMENT PERMIT / AUTHORIZATION TO CONSTRUCT / OPERATION PERMIT / EXISTING SYSTEM INSPECTION

PERMIT# 13820 PIN# 4664 68 9744 .116 4664-78-4526 DATE Jan 17, 2007

OWNER OR APPLICANT Anniston LLC / Nyblock PHONE: Business Home

ADDRESS 17825 Statesville Rd Suite 112, Cornelius N.C. 28031

LOCATION Shavers Rd (S) TL Anniston Way TL Timberside Dr. on Right

SUBDIVISION Anniston BLOCK / SECTION 3 LOT 116 LOT AREA .58Ac SITE CLASS. PS DESIGN FLOW 480gpd L.T.A.R. .03

Septic Tank: 1600 Gallons; STB 794 Date 11-13-07

Pump Tank: 1000 Gallons; PT 27 Date 11-27-07

Pump Make Gould's Model PE5IM Serial No.

Nitrification Field: No Fields 1 Square Feet 1200 Linear Feet 400

No Lines 5 Trench Width 36" Max Trench Bottom Depth 36" Gravel Depth NA ☐ Gravity ☒ Pressure

☒ New System ☐ Repair ☐ Expansion System Type: I II III IV V VI

System Description: pm 25% Reduction

Repair System Description: LPPBPS

Maintenance Agreement Required: ☐ Yes ☒ No

☒ House/Mod. Home No. Bedrooms 4

☐ Mobile Home No. Persons

☐ Business No. Employees

☐ Other

Water Supply: ☒ Individual ☐ Public ☐ Community

☐ Slab ☒ Crawl Space ☐ Basement w/plumbing ☐ Basement wo/plumbing

Comments/Conditions: Stone of old burns in septic system area.

Comments/Conditions: 11/6/07 Reviewed Floor plans, in compliance with original permit. 11/4/08 Checked tanks, lines, pressure & alarm

INITIAL SITE SKETCH

SEE Plan from Rollins Soil and Env. Services

AS BUILT SKETCH

Installed Quick 4


Permit can be suspended or revoked if any false information is supplied toward securing the permit/any unauthorized changes are made to the site/any unauthorized changes are made in the installation of the system. Improvement Permit with plat valid without expiration ☐ Improvement Permit with site plan valid for sixty months ☒ Authorization to Construct is valid for a period equal to that of Improvement Permit – not to exceed sixty months.

Signed: date 2/3/07 Installed by: Larry Hendrix RS

Improvement Permit by: date 1-17-07 Operation Permit by: date 2/5/08

Authorization to Construct by: RS 11/6/07 Existing System Inspection by: date

HEALTH DEPT. COPY: WHITE OWNER COPY (FINAL): YELLOW OWNER COPY (INITIAL): PINK

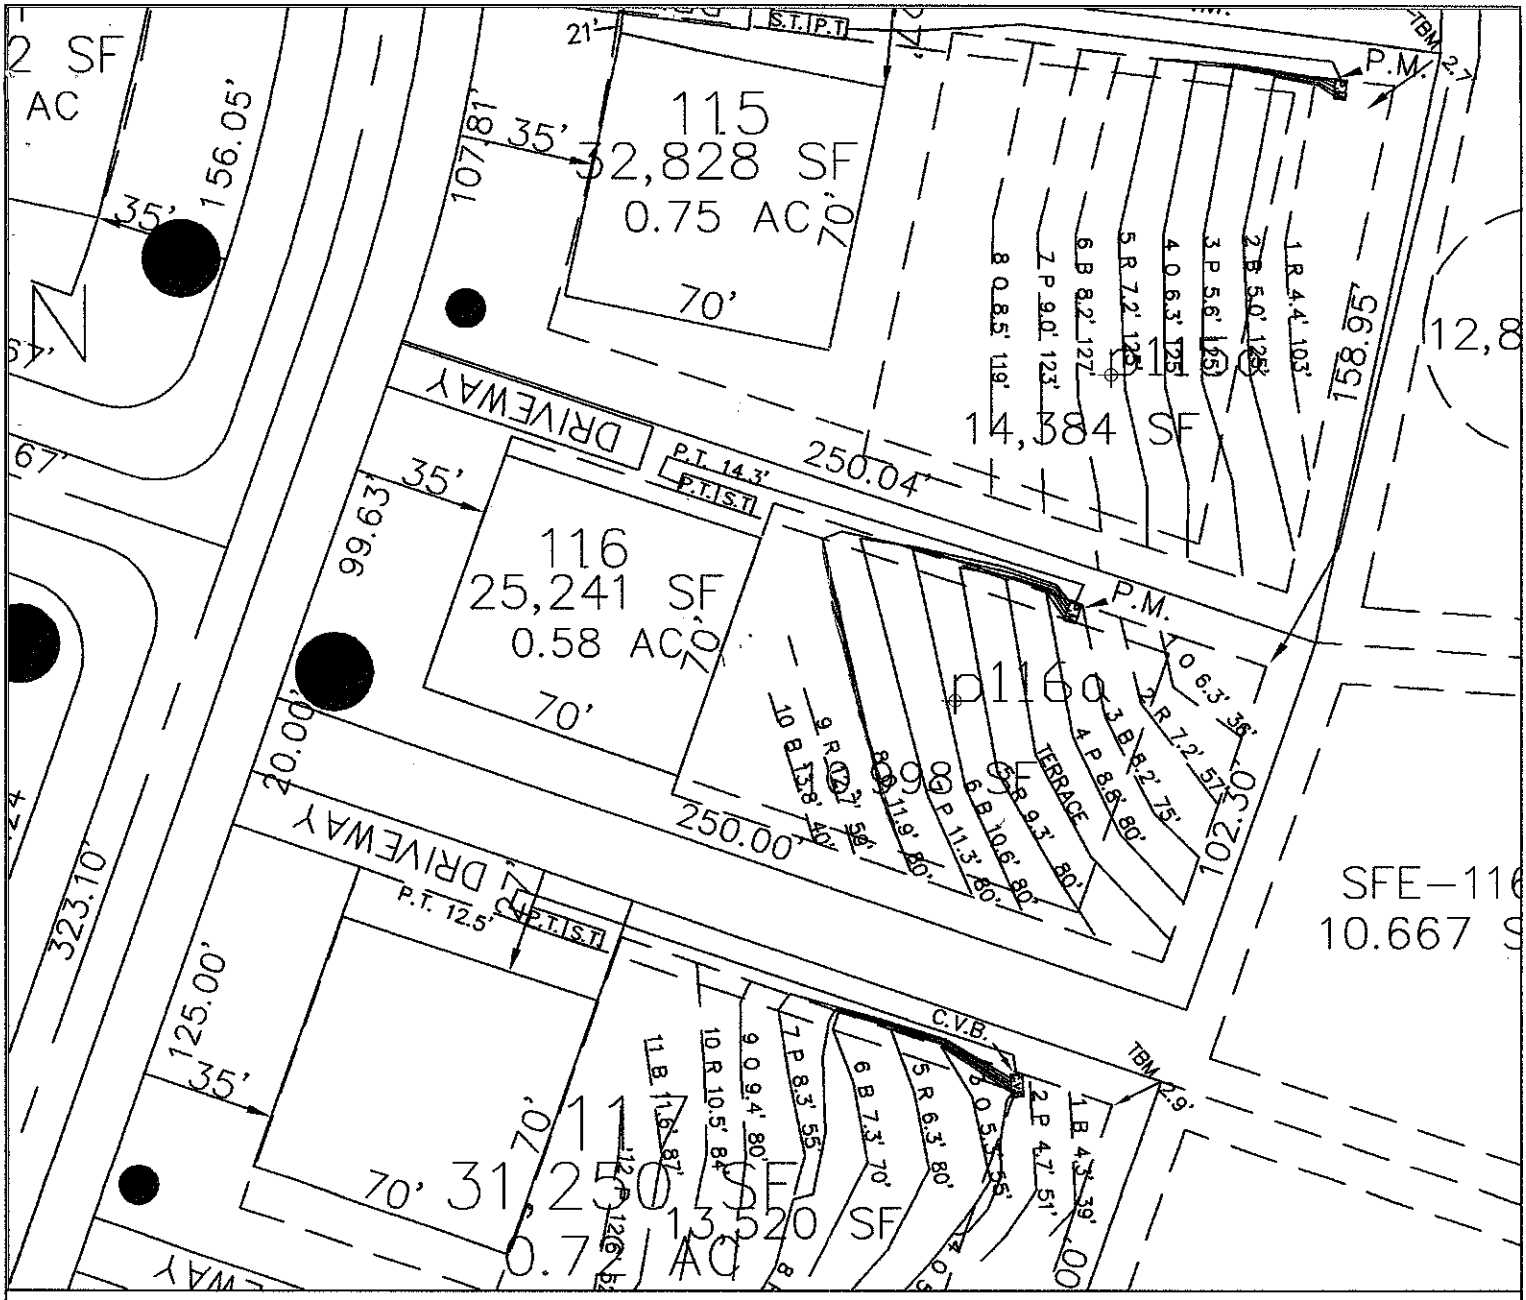

LEGEND

- Areas contain soils with 24 inches or more of useable material and have potential for conventional, modified conventional and low-pressure pipe (lpp) septic systems.
- House Footprint (All 70' x 70')
- System lines.
- Repair lines.
- TBM.
- (25) RS&ES Pit Location.
- Well Location.
- [28] Health Dept. Pit Location.

GRAPHIC SCALE
1" = 50'

50 0 50 100

FOR PRELIMINARY PLANNING PURPOSES ONLY. ALL LOTS WILL REQUIRE FINAL APPROVAL BY THE COUNTY HEALTH DEPARTMENT ON A LOT BY LOT BASIS. THIS MAP SHOULD BY USED AS A GENERAL GUIDE, SOME ADJUSTMENTS WILL BE NECESSARY IN THE FIELD DUE TO SOIL VARIABILITY AND COMPLEX TOPOGRAPHIC FEATURES. THIS MAP ONLY REFLECTS EXISTING SOIL SUITABILITY FOR ON-SITE SEPTIC TANK SYSTEMS.

PLEASE REFER TO ATTACHED SOIL REPORT FOR ADDITIONAL SITE SPECIFIC INFORMATION

ROLLANS SOIL & ENVIRONMENTAL SERVICES
2120 GRAHAM ROAD
MOUNT ULLA, NC 28125
PHONE/FAX: (704) 278-0989
ASHLEY ROLLANS, NC LICENSED SOIL SCIENTIST
MOBILE: (704) 746-5046
EMAIL: ROLLANSFORTC@AOL.COM

MAP TITLE:	SITE PLAN & DRAINFIELD AREAS
PROJECT NAME:	ANNISTON, LLC. / ANNISTON PHASE II
LOCATION/DATE:	SHEARER CHAPEL ROAD IREDELL COUNTY, NORTH CAROLINA JULY 2006
JOB # :	01-1005
FILE:	C:\JOBS\01-1005
PROJECT MGR.:	S.A.R.
FIELD WORK:	S.A.R.
DRAWN BY:	S.A.R.