IREDELL COUNTY HEALTH DEPARTMENT

STATESVILLE 704-878-5305 MOORESVILLE 704-664-5281

IMPROVEMENT PERMIT / AUTHORIZATION TO CONSTRUCT / OPERATION PERMIT / EXISTING SYSTEM INSPECTION

PERMIT# 138118 PIN# ~~4664689744.000~~ 4664784840 DATE Jan 17, 2007

OWNER OR APPLICANT Anniston LLC PHONE: Business _____ Home _____

ADDRESS 17825 Statesville Rd Suite 112, Cornelius, N.C. 28031

LOCATION Shearers Rd (S) TL Anniston Way TL Timberside Dr. on RS Right 140 Timberside Drive

SUBDIVISION Anniston BLOCK / SECTION _____ LOT 114 LOT AREA .75Ac SITE CLASS. PS DESIGN FLOW 600gpd L.T.A.R. .3

Septic Tank: 1500 Gallons: STB 358 Date 4-11-11
Pump Tank: 1500 Gallons: PT 477 Date 4-19-11
Pump Make: GOULDS Model WE0512H Serial No. _____
Nitrification Field: No Fields 1 Square Feet 1500 Linear Feet 500
No Lines 4 Trench Width 36" Max Trench Bottom Depth 36"

☒ New System ☐ Repair ☐ Expansion System Type: I II III IV V VI
System Description: pm 25% Reduction
Repair System Description: LPPBDS
Maintenance Agreement Required: ☐ Yes ☒ No

☒ House/Mod. Home No. Bedrooms 5
☐ Mobile Home No. Persons _____
☐ Business No. Employees _____
☐ Other _____

Water Supply: ☒ Individual ☐ Public ☐ Community

Gravel Depth NA ☐ Gravity ☒ Pressure ☐ Slab ☒ Crawl Space ☐ Basement w/plumbing ☐ Basement wo/plumbing

Comments:/Conditions:
There is old burns in septic system area.
6/13 Tanks checked BA
6/15 Drainlines, pressure, alarm checked by BA

INITIAL SITE SKETCH

Comments:/Conditions: 3/21/11 Reviewed Site plan & Floor plans, in Compliance with original plan (Floor plans show 4 Bedrooms but want to leave permit as 5 Bedrooms)

AS BUILT SKETCH

3" CH. PERLINE QUICK 4 INSTALLED
X4
124 + END CAPS

INFILTRATOR PRESSURE BELL INSTALLED

SEE PLAN from Rollins Soil & Env. Services

	Date	Initials
Drain Lines Checked	6-15	BA
Tanks Checked	6-13	BA
Pressure Manifold or Valve Box Checked	6-15	BA
Pressure Head Set	6-15	BA
Electrical Checked		
Floats Set		
Alarm Checked	6-15	BA
Maintenance Contract Y (N)		


Couldn't issue in Munis - 4-20-2015
CO issued 7-13-11

Permit can be suspended or revoked if any false information is supplied toward securing the permit/any unauthorized changes are made to the site/any unauthorized changes are made in the installation of the system. Improvement Permit with plat valid without expiration ☐ Improvement Permit with site plan valid for sixty months ☒ Authorization to Construct is valid for a period equal to that of Improvement Permit – not to exceed sixty months.

Signed: _____ date 2-13-07
Improvement Permit by: _____ RS date 1-17-07
Authorization to Construct by: _____ RS date 3/21/2011

Installed by: Larry Hinkle
Operation Permit by: _____ RS date 4/15/15
Existing System Inspection by: _____ date _____

HEALTH DEPT. COPY: WHITE OWNER COPY (FINAL): YELLOW OWNER COPY (INITIAL): PINK

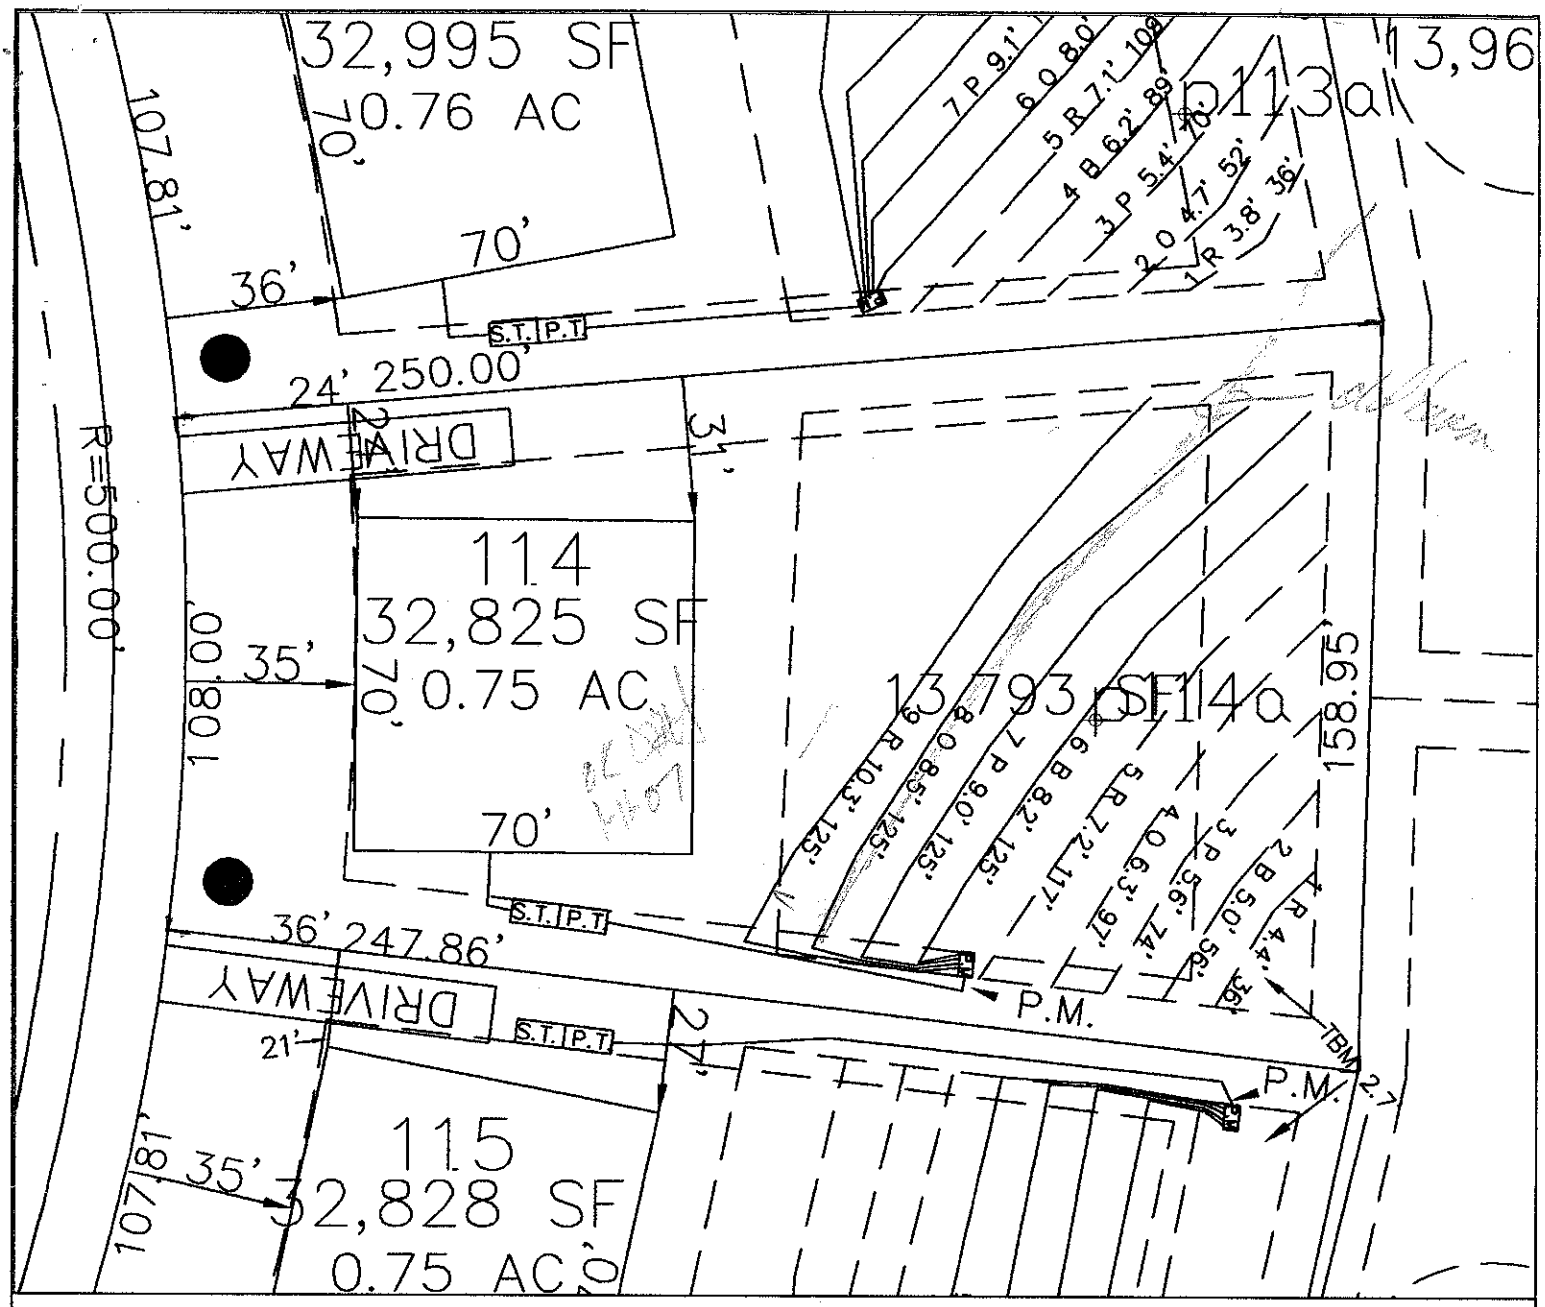

LEGEND

- Areas contain soils with 24 inches or more of useable material and have potential for conventional, modified conventional and low-pressure pipe (lpp) septic systems.
- House Footprint (All 70' x 70')
- System lines.
- Repair lines.
- TBM.
- (25) RS&ES Pit Location.
- Well Location.
- [28] Health Dept. Pit Location.

GRAPHIC SCALE
1" = 40'

40 0 40 80

FOR PRELIMINARY PLANNING PURPOSES ONLY. ALL LOTS WILL REQUIRE FINAL APPROVAL BY THE COUNTY HEALTH DEPARTMENT ON A LOT BY LOT BASIS. THIS MAP SHOULD BY USED AS A GENERAL GUIDE, SOME ADJUSTMENTS WILL BE NECESSARY IN THE FIELD DUE TO SOIL VARIABILITY AND COMPLEX TOPOGRAPHIC FEATURES. THIS MAP ONLY REFLECTS EXISTING SOIL SUITABILITY FOR ON-SITE SEPTIC TANK SYSTEMS.

PLEASE REFER TO ATTACHED SOIL REPORT FOR ADDITIONAL SITE SPECIFIC INFORMATION

ROLLANS SOIL & ENVIRONMENTAL SERVICES
2120 GRAHAM ROAD
MOUNT ULLA, NC 28125
PHONE/FAX: (704) 278-0989
ASHLEY ROLLANS, NC LICENSED SOIL SCIENTIST
MOBILE: (704) 746-5046
EMAIL: ROLLANSPORTC@AOL.COM

MAP TITLE: SITE PLAN & DRAINFIELD AREAS

PROJECT NAME: ANNISTON, LLC. / ANNISTON PHASE II

LOCATION/DATE: SHERRER CHAPEL ROAD, IREDELL COUNTY, NORTH CAROLINA, JULY 2008

JOB # :	01-1005
FILE:	C:\JOBS\01-1005
PROJECT MGR.:	S.A.R.
FIELD WORK:	S.A.R.
DRAWN BY:	S.A.R.