IREDELL COUNTY HEALTH DEPARTMENT

STATESVILLE 704-878-5305 MOORESVILLE 704-664-5281

IMPROVEMENT PERMIT / AUTHORIZATION TO CONSTRUCT / OPERATION PERMIT / EXISTING SYSTEM INSPECTION

PERMIT# 144370 PIN# 4664 79 2036.111 4664-79-3236 DATE Sept. 13, 07

OWNER OR APPLICANT Anniston LLC / Kiblock PHONE: Business Home

ADDRESS 1724 Statesville Rd Suite 112, Cornelius, N.C. 28031

LOCATION Shearers RC. South TL Anniston Way TL Timberside Dr. on right near end

SUBDIVISION Anniston BLOCK / SECTION 3 LOT 111 LOT AREA 1.27ac SITE CLASS. PS DESIGN FLOW 600gpd L.T.A.R. .825

Septic Tank: 1500 Gallons; STB 338 Date 11-26-07 ☒ New System ☐ Repair ☐ Expansion System Type: I-II III IV V VI ☒ House/Mod. Home No. Bedrooms 5 Water Supply: ☒ Individual ☐ Public ☐ Community

Pump Tank: 1500 Gallons; PT 471 Date 2-13-08 System Description: PM 25% Reduction ☐ Mobile Home No. Persons

Pump Make Gould's Model PE5IM Serial No. Repair System Description: LP PUBS ☐ Business No. Employees

Nitrification Field: No Fields Square Feet 1800 Linear Feet 600 Maintenance Agreement Required: ☐ Yes ☒ No ☐ Other

No Lines 4@150' Trench Width 36" Max Trench Bottom Depth 36" Gravel Depth N/A ☐ Gravity ☒ Pressure ☐ Slab ☒ Crawl Space ☐ Basement w/plumbing ☐ Basement wo/plumbing

Comments:/Conditions 4/10/08 Check lines, tanks, set 2# pressure & alarm 199ft of 2 inch Supply line

Comments:/Conditions: Sch 40 1/2" Tap

INITIAL SITE SKETCH

Install Quick 4 As Drawn

See Plan from Rollins Soil + Env. Services

AS BUILT SKETCH

The proposed / existing SunRoom addition does not appear to impact the existing septic system.

**NOTE:

R.S.

Date: 04-15-12

ICHD-Environmental Health Division

Permit can be suspended or revoked if any false information is supplied toward securing the permit/any unauthorized changes are made to the site/any unauthorized changes are made in the installation of the system. Improvement Permit with plat valid without expiration ☐ Improvement Permit with site plan valid for sixty months ☒ Authorization to Construct is valid for a period equal to that of Improvement Permit – not to exceed sixty months.

Signed: date 9-20-07

Improvement Permit by: date 9-13-07


Authorization to Construct by: Wesley Sparks R.S. date 1/28/08

Installed by: Larry Henkle RS

Operation Permit by: date 5/1/08

Existing System Inspection by: date

HEALTH DEPT. COPY: WHITE OWNER COPY (FINAL): YELLOW OWNER COPY (INITIAL): PINK

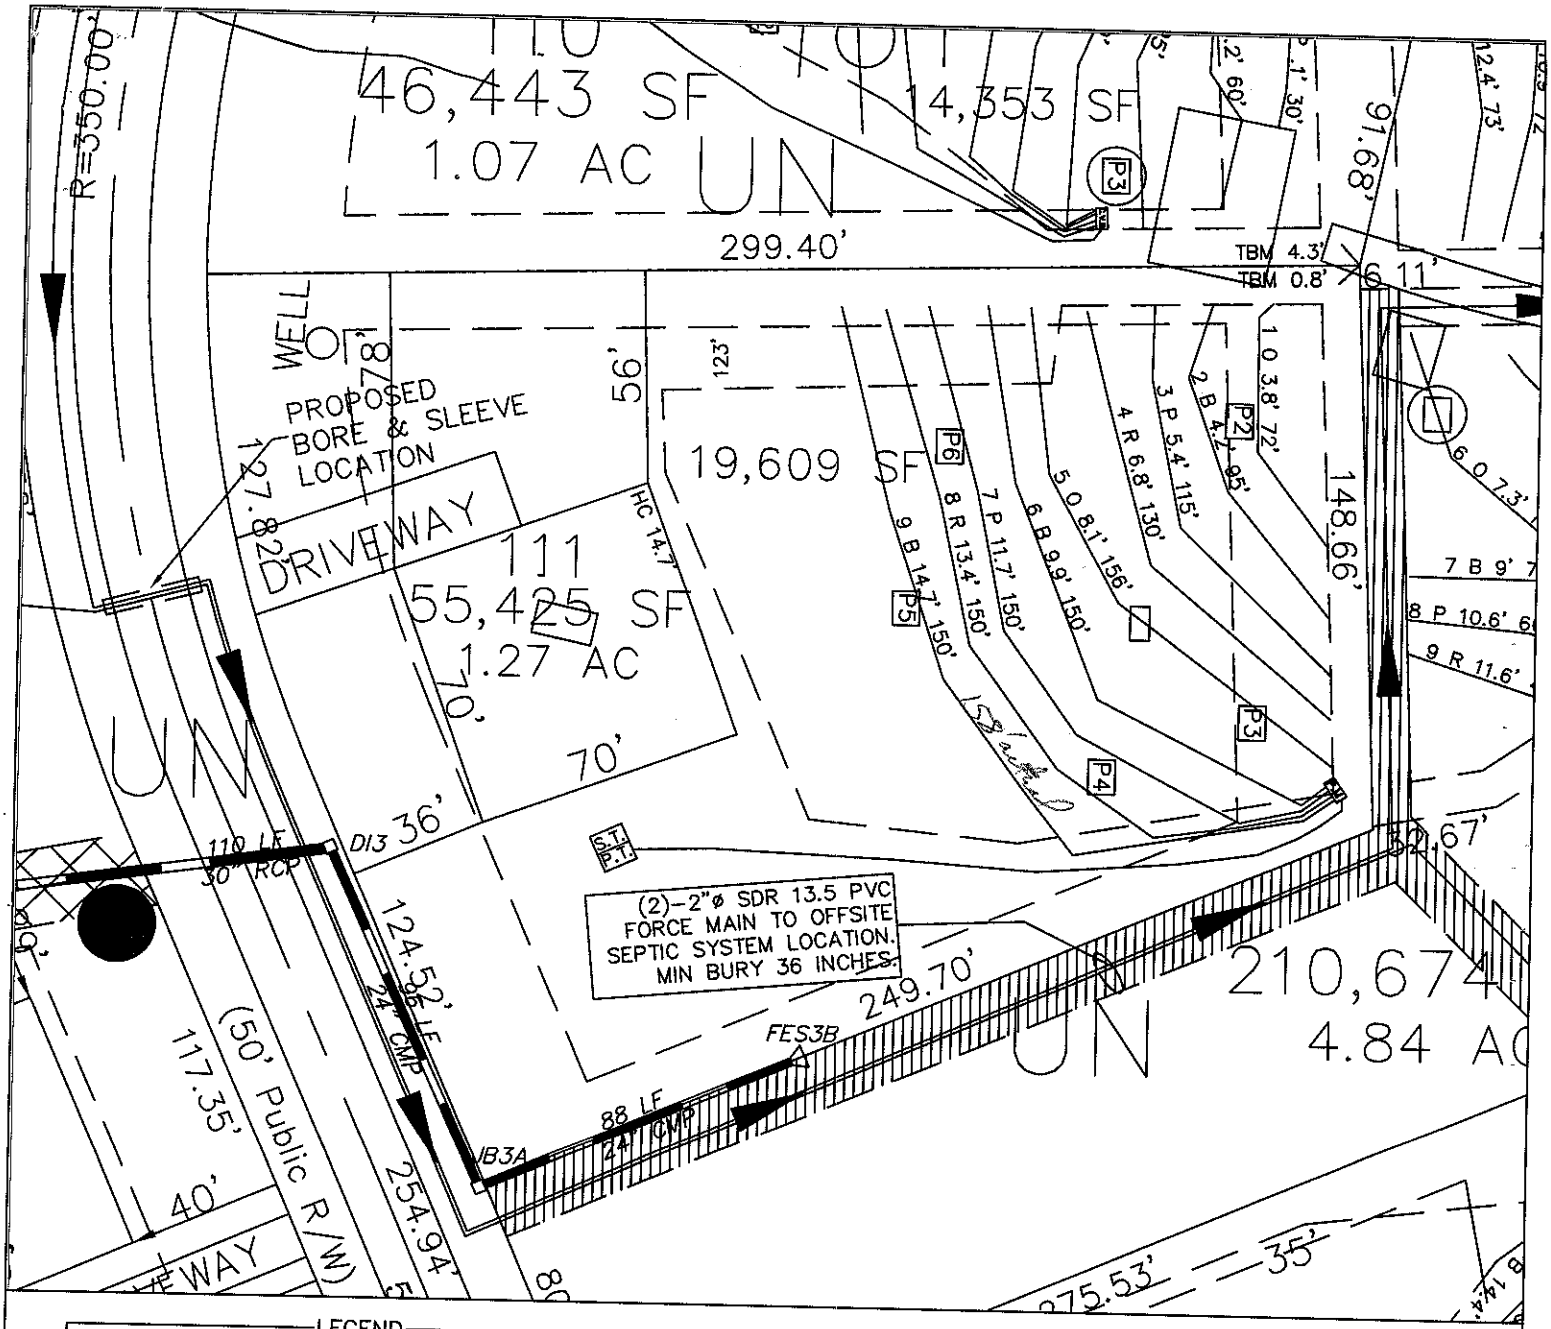

LEGEND

- Areas contain soils with 24 inches or more of useable material and have potential for conventional, modified conventional and low-pressure pipe (lpp) septic systems.
- House Footprint (All 70' x 70')
- System lines.
- Repair lines.
- TBM.
- Well Location.
- Purposed Pit Location
- RS&ES Pit Location.
- Health Dept. Pit Location.

GRAPHIC SCALE
1" = 50'

50 0 50 100

FOR PRELIMINARY PLANNING PURPOSES ONLY. ALL LOTS WILL REQUIRE FINAL APPROVAL BY THE COUNTY HEALTH DEPARTMENT ON A LOT BY LOT BASIS. THIS MAP SHOULD BY USED AS A GENERAL GUIDE, SOME ADJUSTMENTS WILL BE NECESSARY IN THE FIELD DUE TO SOIL VARIABILITY AND COMPLEX TOPOGRAPHIC FEATURES. THIS MAP ONLY REFLECTS EXISTING SOIL SUITABILITY FOR ON-SITE SEPTIC TANK SYSTEMS.

PLEASE REFER TO ATTACHED SOIL REPORT FOR ADDITIONAL SITE SPECIFIC INFORMATION

ROLLANS SOIL & ENVIRONMENTAL SERVICES
2120 GRAHAM ROAD
MOUNT ULLA, NC 28125
PHONE/FAX: (704) 278 - 0989
ASHLEY ROLLANS, NC LICENSED SOIL SCIENTIST
MOBILE: (704) 746 - 5046
EMAIL: ROLLANSFORTCJ@AOL.COM

MAP TITLE: SITE PLAN & DRAINFIELD AREAS

PROJECT NAME: ANNISTON, LLC. / ANNISTON PHASE II

LOCATION/DATE: SHEARER CHAPEL ROAD IREDELL COUNTY, NORTH CAROLINA JULY 2006

JOB # :	01-1005
FILE:	C:\JOBS\01-1005
PROJECT MGR.:	S.A.R.
FIELD WORK:	S.A.R.
DRAWN BY:	S.A.R.