IREDELL COUNTY HEALTH DEPARTMENT

Statesville Office (704) 878-5305 Mooresville Office (704) 660-3625 PERMIT # 208949

IMPROVEMENT PERMIT / AUTHORIZATION TO CONSTRUCT / OPERATION PERMIT / EXISTING SYSTEM

PIN # 4664873323 ✓

APPLICANT: SHEA HOMES APPLICANT ADDRESS: 8088 CORPORATE CENTER ST 300 CHARLOTTE NC

SITE ADDRESS: 177 WALKING HORSE TR - PHONE: ALT. PHONE:

SITE DIRECTIONS: SHEARERS RD - TL ANNISTON WAY - TR BURNELL, TL WALKING HORSE - ON LT

SUBDIVISION: ANNISTON SECTION: 4 LOT # 121 LOT AREA: 1.04AC DESIGN FLOW: @ 600 L.T.A.R.: .3

Septic Tank 1500 (gal) STB 1014 Date 5-24-15
Pump Tank 1500 (gal) PT 302 Date 6-14-15
Pump Make ZOELLER Model N152 Serial #
Nitrification Fields 1 # Lines 4 Linear Ft: 336
Trench Width 24" MIN Max. Trench Bottom Depth 36" Gravel Depth 12"

☑ New System ☐ Repair ☐ Expansion System Type: I II III (IV) V VI
System Description: CPP PPBPS
Repair System Description: SAME
Maintenance Agreement Required: ☑ YES ☐ NO ☐ GRAVITY ☑ PRESSURE

☐ Residence ☐ Business ☐ Other ☐ Slab ☐ Basement w/plumbing
No. Bedrooms 5 No. Persons 10 No. Employees ☑ Crawl Space
Water Supply: ☑ Private ☐ Public ☐ Community ☐ Basement w/o plumbing

Comments / Conditions:
7/1/15 New Well location
Keep tanks > 50FT

10/21/15 Elect & Alarm

INITIAL SITE SKETCH

SEE MICHAEL ATHANAS & ASSOCIATES DESIGN

AS BUILT SKETCH

CHECKED LINES, TANKS, SET 2' PH
TANK EXACTLY 50' FROM WELL
JA 10-8-15

Permit can be suspended or revoked if any false information is supplied toward securing the permit / any unauthorized changes are made to the site / any unauthorized changes are made in the installation of the system. **CONTACT A LOCATOR SERVICE PRIOR TO ANY EXCAVATION**

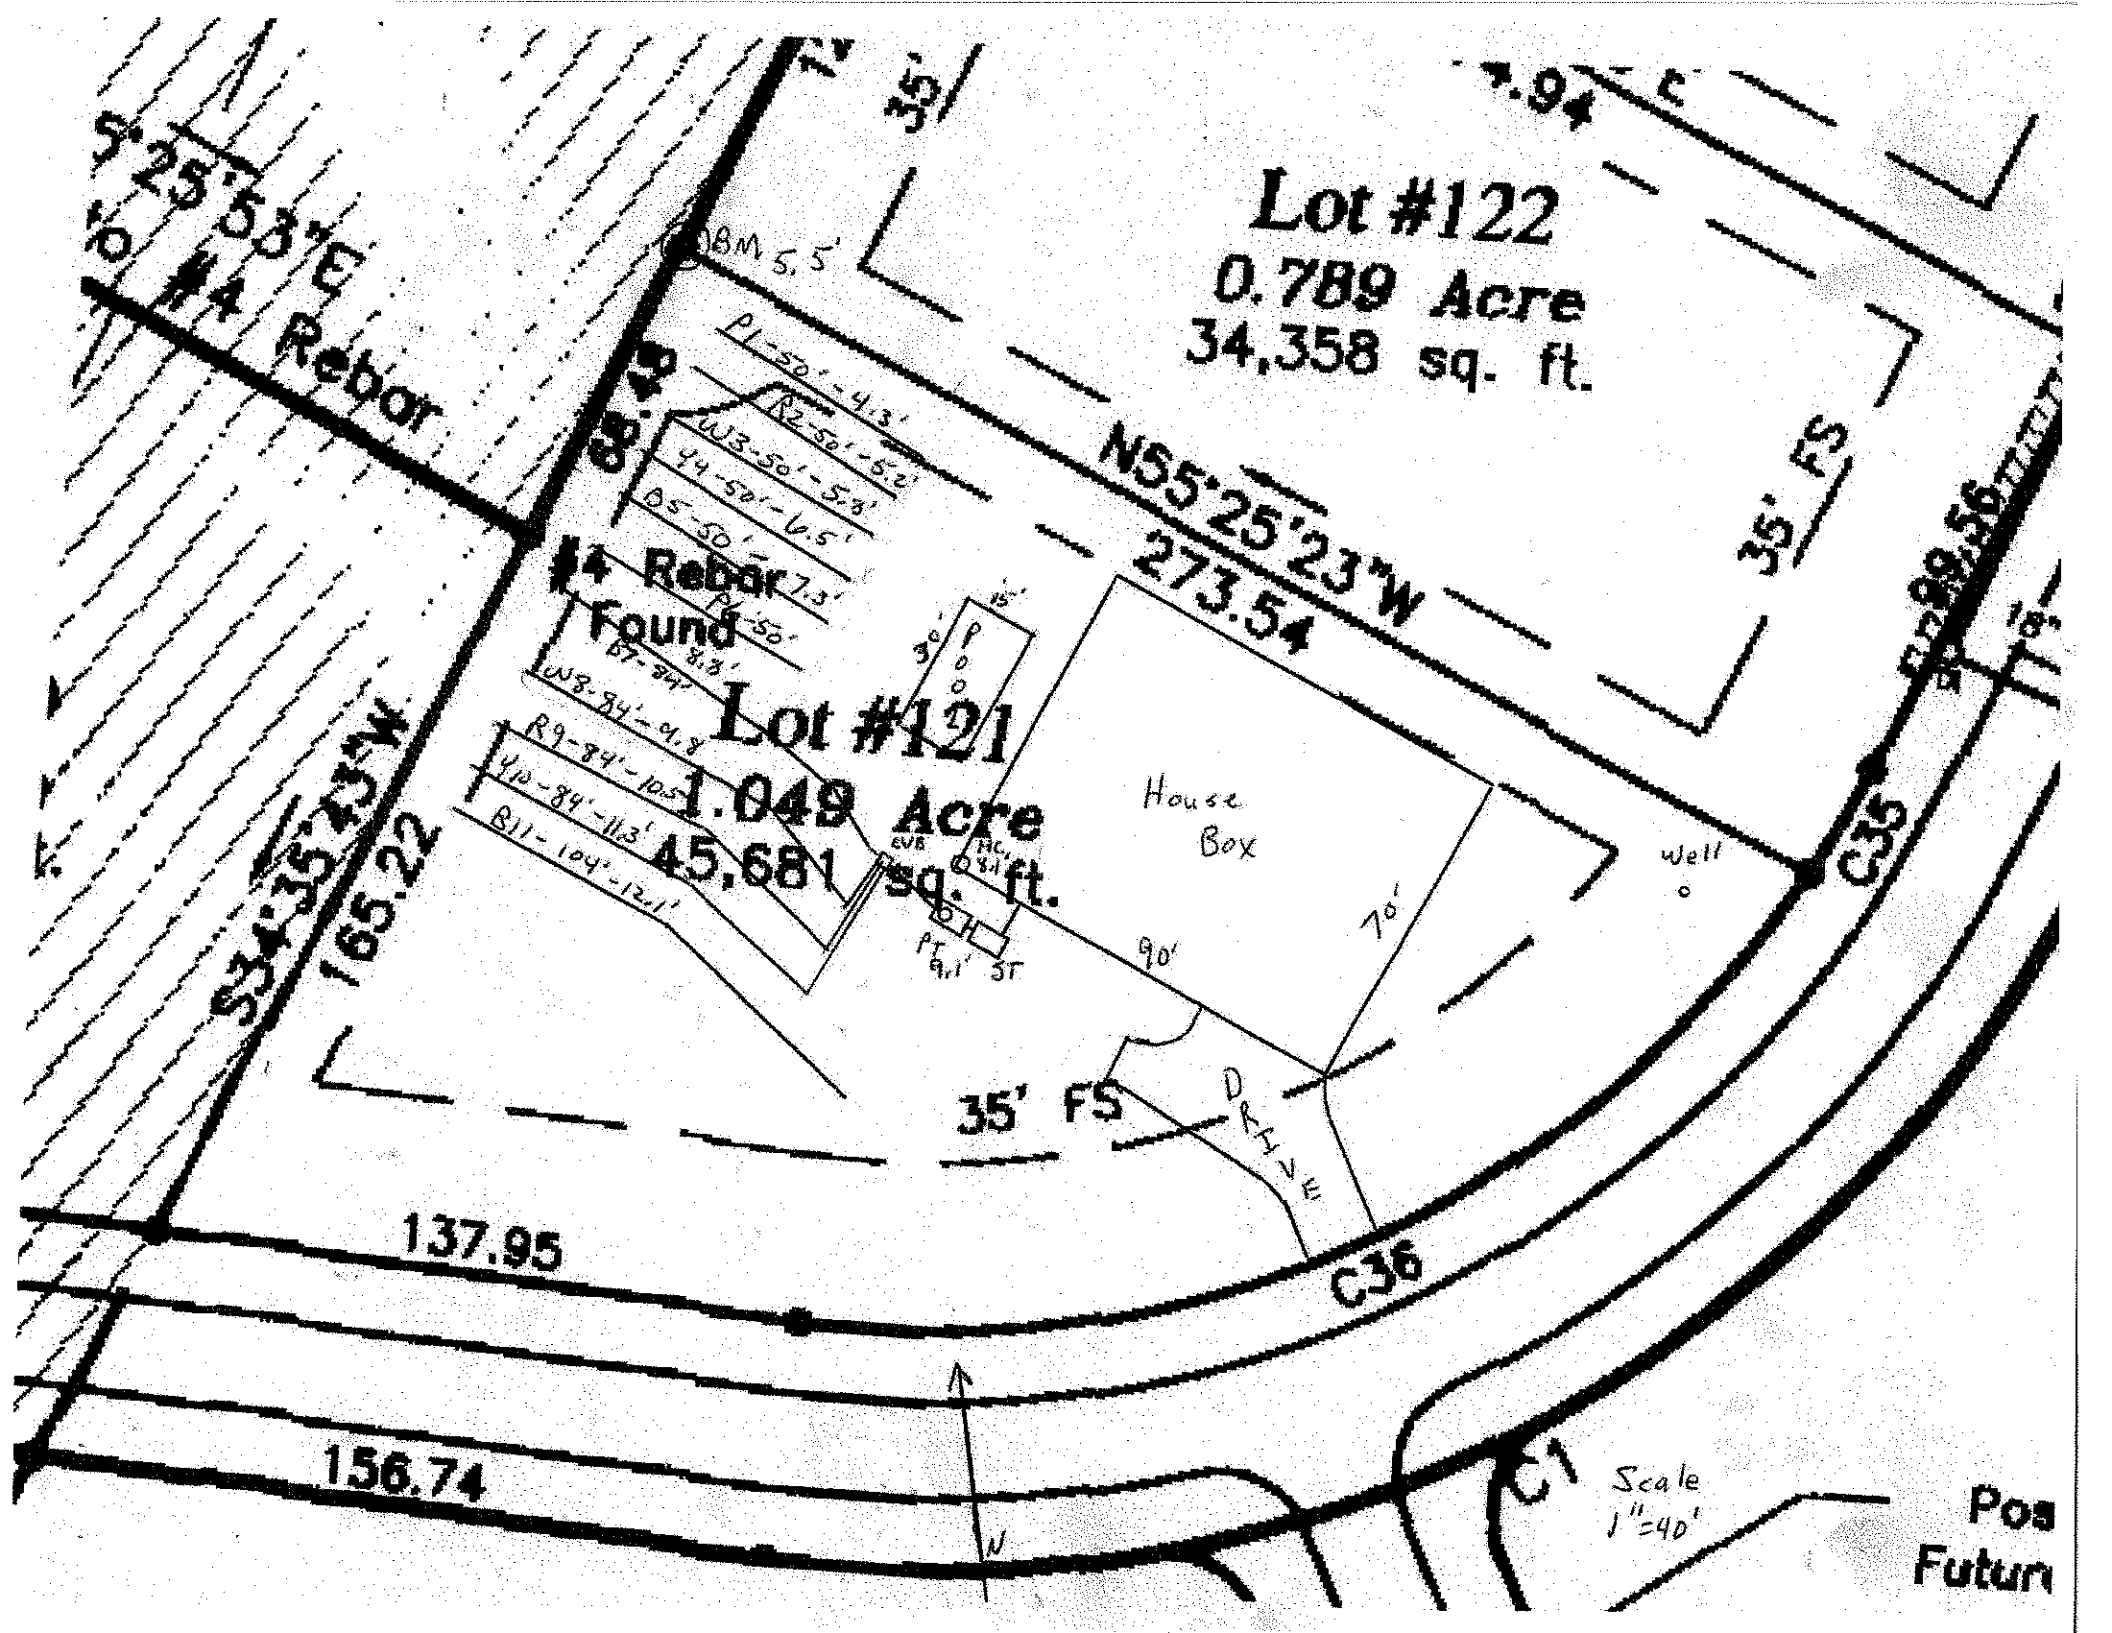
☐ **IMPROVEMENT PERMIT** *with plat valid without expiration.* ☑ **IMPROVEMENT PERMIT** *with site plan valid for 60 mos.* ☑ **AUTHORIZATION TO CONSTRUCT** *valid for period equal to IMPROVEMENT PERMIT--not to exceed 60 mo.*

Owner / Applicant Signature: Stan Prenty Date: 4/6/15 Installed by: ROWAN SEPTIC

IMPROVEMENT PERMIT by: Date: 3/3/15 OPERATION PERMIT by: Date: 10/21/15

AUTHORIZATION TO CONSTRUCT by: Date: 3/3/15 Existing System Inspected by: Date:

Health Dept. Copy - WHITE Applicant (Final Approval) - YELLOW Applicant (Conditional Approval) - PINK


Lot #122
0.789 Acre
34,358 sq. ft.
Lot #121
1.049 Acre
45,681 sq. ft.
#4 Rebar Found
#4 Rebar
S 25° 53' E
N55°25'23"W
273.54
S34°35'43"W
165.22
137.95
156.74
35' FS
House Box
Well
DRIVE
90'
70'
C35
C36
C1
BM 5.5'
P1-50'-4.3'
R2-50'-5.2'
W3-50'-5.3'
Y4-50'-6.5'
B5-50'-7.3'
R6-50'
B7-34'-8.3'
W8-34'-9.8'
R9-34'-10.5'
Y10-34'-11.3'
B11-104'-12.1'
POB
EVB
HC
PT
ST
Scale 1"=40'
N
Pos
Futur