IREDELL COUNTY HEALTH DEPARTMENT

Statesville Office (704) 878-5305 Mooresville Office (704) 660-3625 PERMIT # 214584

IMPROVEMENT PERMIT / AUTHORIZATION TO CONSTRUCT / OPERATION PERMIT / EXISTING SYSTEM

PIN # 4664-87-5544

APPLICANT: SHEA HOMES APPLICANT ADDRESS: 8008 CORPORATE CENTER DR.

SITE ADDRESS: 193 WALKING HORSE TR. - DAVIDSON PHONE: 704-576-3887 ALT. PHONE:

SITE DIRECTIONS: ANNISTON, TR BURNELL, TL WALKING HORSE, ON L

SUBDIVISION: ANNISTON SECTION: 4 LOT # 123 LOT AREA: .789 AC DESIGN FLOW: 480 L.T.A.R.: .5

Septic Tank	1000 (gal)	STB	825	Date	4-21-16	☒ New System ☐ Repair ☐ Expansion	System Type: I II (III)B IV V VI	☒ Residence	No. Bedrooms	4	Water Supply
Pump Tank	1000 (gal)	PT	302	Date	3-08-16	System Description:	PM - 25% REDUCTION	☐ Business	No. Persons	8	☒ Private
Pump Make	ZOELLER	Model	N152	Serial #		Repair System Description:	SAME	☐ Other	No. Employees		☐ Public
# Nitrification Fields	1	# Lines	4@100'	Linear Ft:	400'	Maintenance Agreement Required:	☐ YES ☒ NO	☐ Slab	☒ Crawl Space		☐ Community
Trench Width	36"	Max. Trench Bottom Depth	36"	Gravel Depth	—		☐ GRAVITY ☒ PRESSURE	☐ Basement w/plumbing		☐ Basement w/o plumbing	

Comments / Conditions:

INITIAL SITE SKETCH

SEE PLAN FROM MICHAEL ATHANAS & ASSOCIATES

AS BUILT SKETCH

CHECKED TANKS, LINES, SET 2' PH SA 6-21-16

Permit can be suspended or revoked if any false information is supplied toward securing the permit / any unauthorized changes are made to the site / any unauthorized changes are made in the installation of the system. **CONTACT A LOCATOR SERVICE PRIOR TO ANY EXCAVATION**

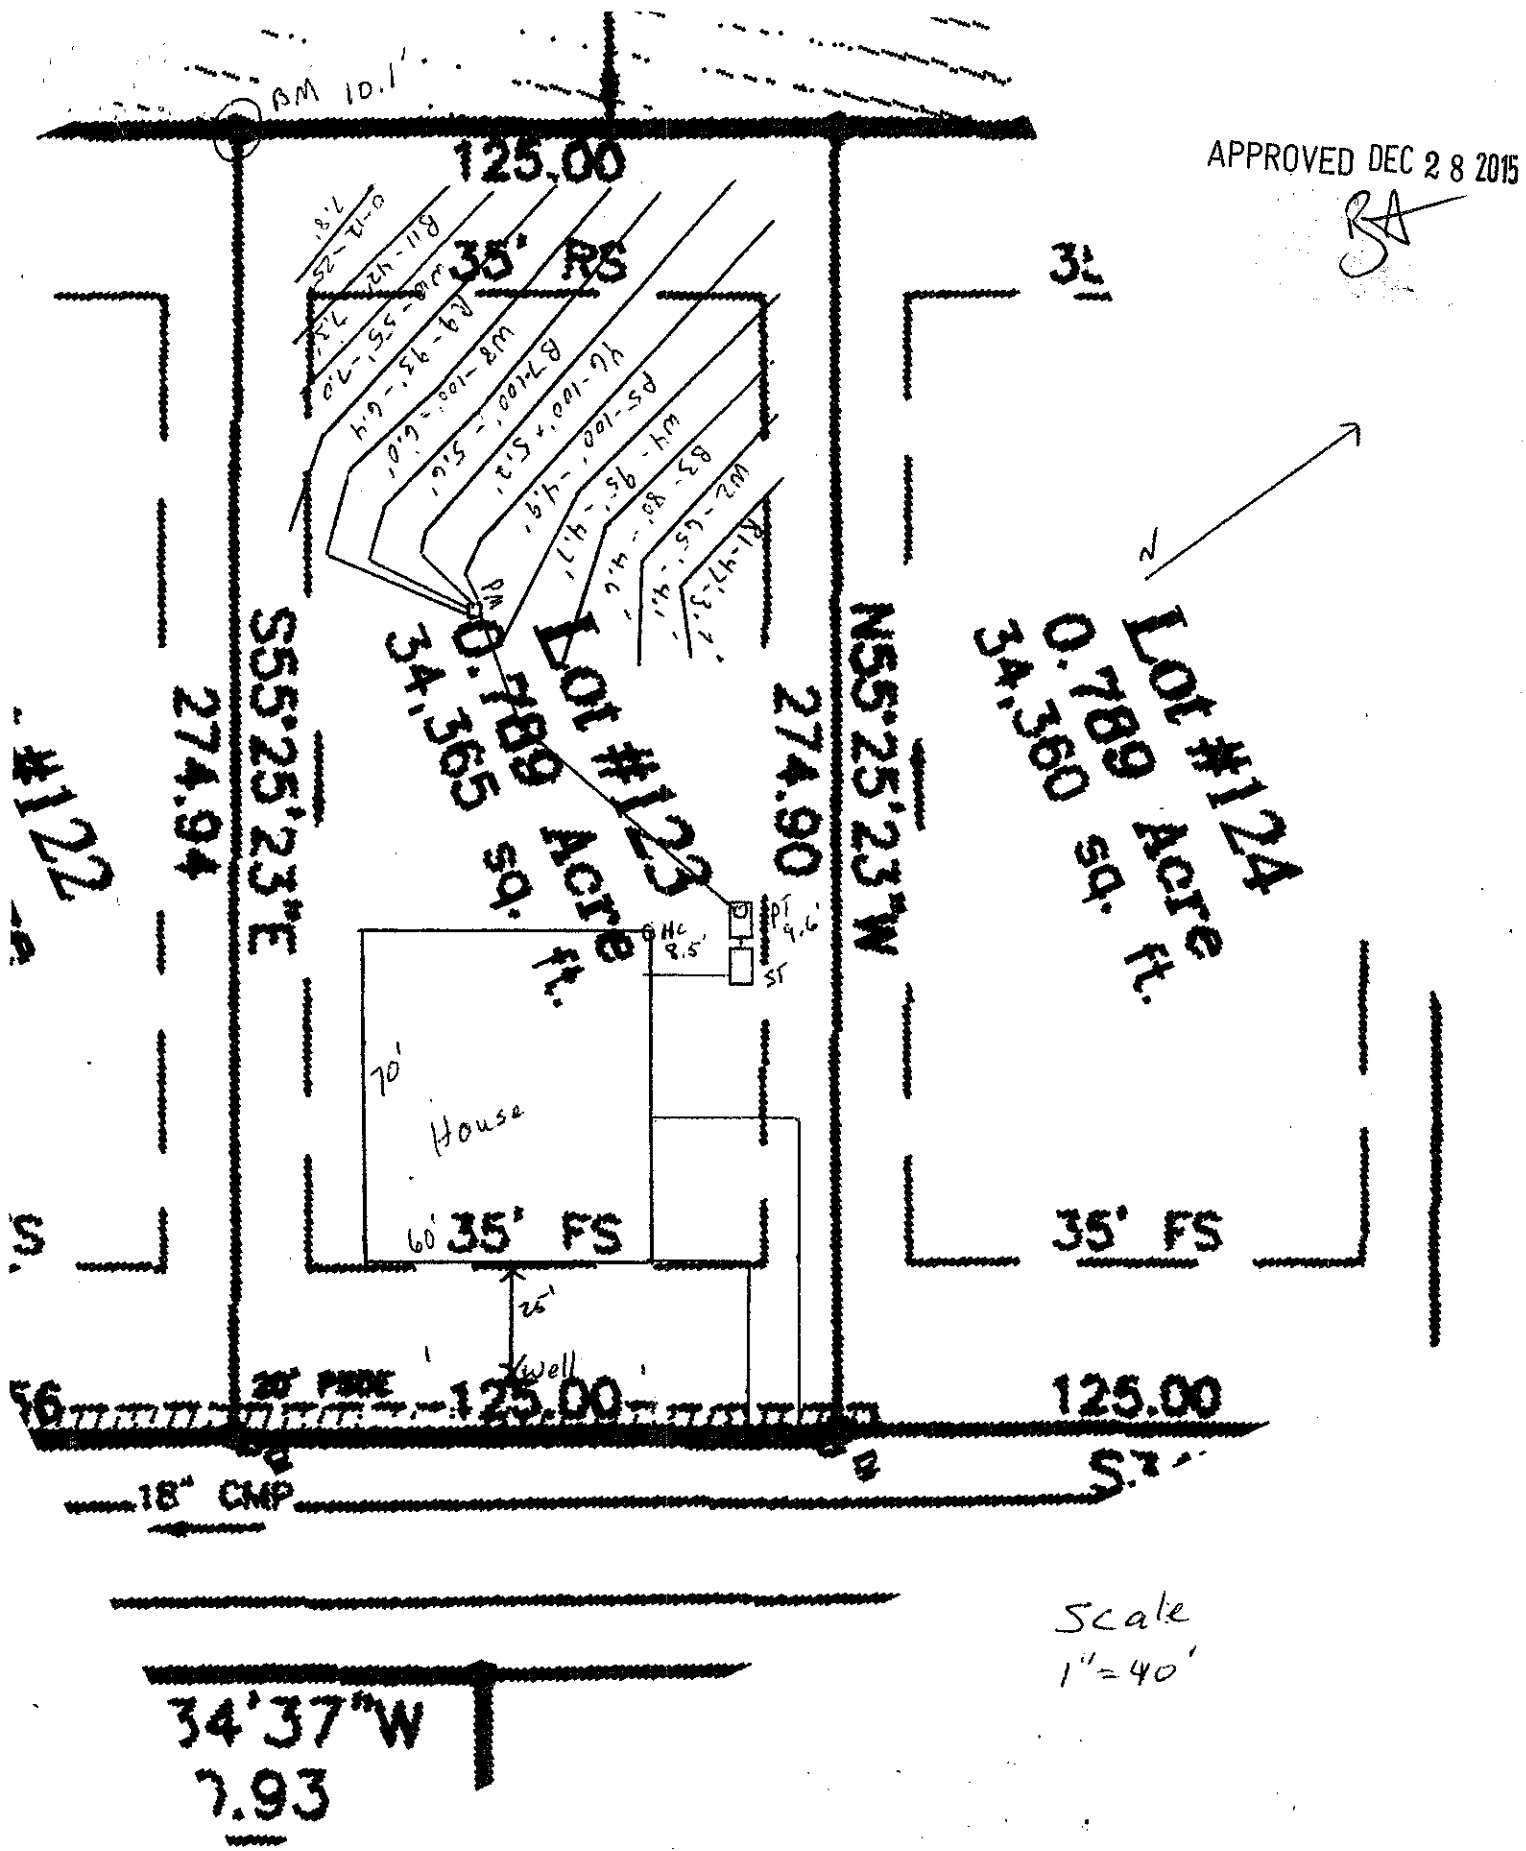
☐ **IMPROVEMENT PERMIT** *with plat valid without expiration.* ☒ **IMPROVEMENT PERMIT** *with site plan valid for 60 mos.* ☒ **AUTHORIZATION TO CONSTRUCT** *valid for period equal to IMPROVEMENT PERMIT--not to exceed 60 mo.*

Owner / Applicant Signature: [signature] Date: 2-16-16 Installed by:

IMPROVEMENT PERMIT by: [signature] Date: 12-28-15 OPERATION PERMIT by: [signature] Date: 8/31/16

AUTHORIZATION TO CONSTRUCT by: [signature] Date: 2-10-16 Existing System Inspected by: Date:

Health Dept. Copy - WHITE Applicant (Final Approval) - YELLOW Applicant (Conditional Approval) - PINK


APPROVED DEC 2 8 2015
125.00
35' RS
Lot #123
0.789 Acre
34,365 sq. ft.
S55°25'23"E
274.94
N55°25'23"W
274.90
Lot #124
0.789 Acre
34,360 sq. ft.
#122
#124
70'
House
60' 35' FS
35' FS
25'
Well
20' PSDE
125.00
18" CMP
34'37"W
7.93
Scale
1"=40'